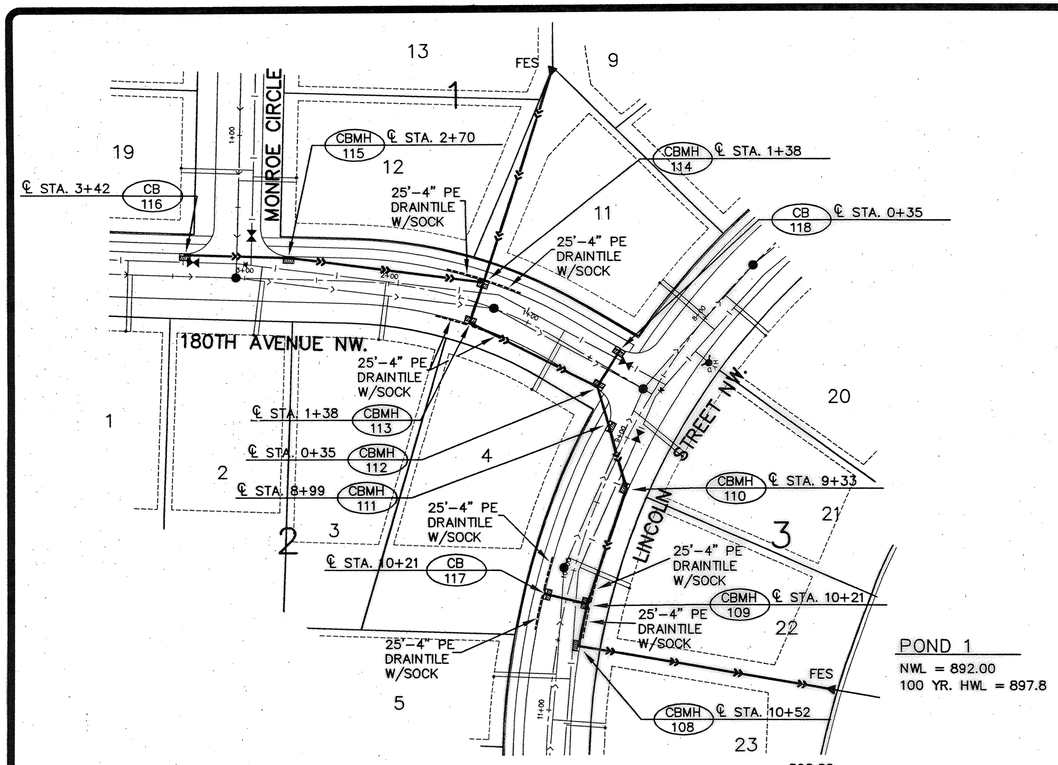

STORM SEWER SCHEDULE		
CB or MH NO.	STRUCT. SIZE	NEENAH CASTING or EQUAL
MH – 107	48" DIA.	R–1733
CBMH – 108	48" DIA.	R–3067–V
CBMH – 109	48" DIA.	R–3067–V
CBMH – 110	48" DIA.	R–3067–V
CBMH – 111	48" DIA.	R–3067–V
CBMH – 112	48" DIA.	R–3067–V
CBMH – 113	48" DIA.	R–3067–V
CBMH – 114	48" DIA.	R–3067–V
CBMH – 115	48" DIA.	R–3067–V
CB – 116	24" X 36"	R–3067–V
CB – 117	24" X 36"	R–3067–V
CB – 118	24" X 36"	R–3067–V

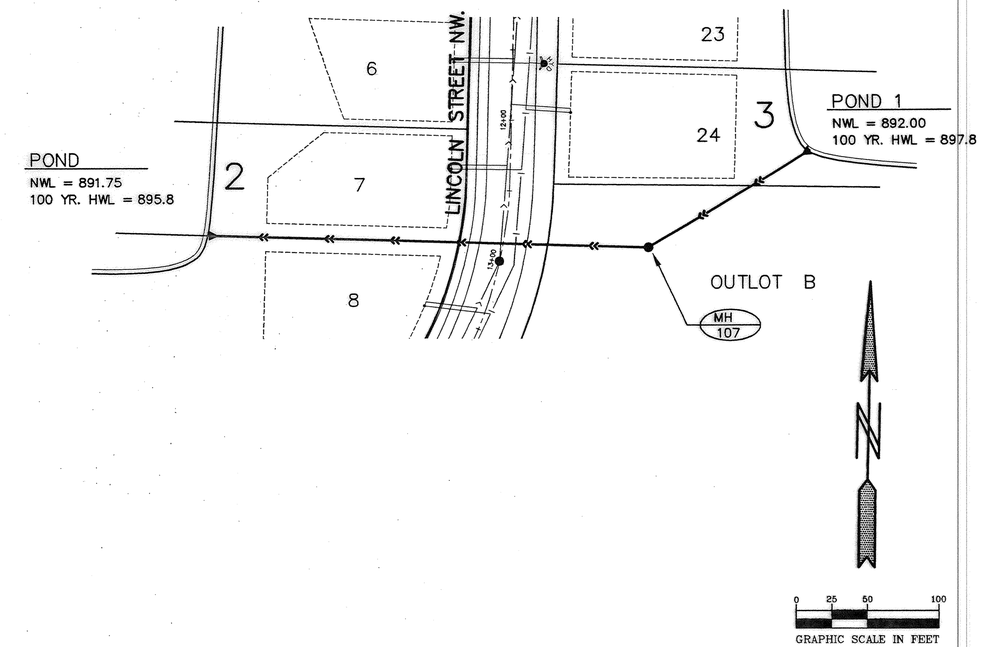

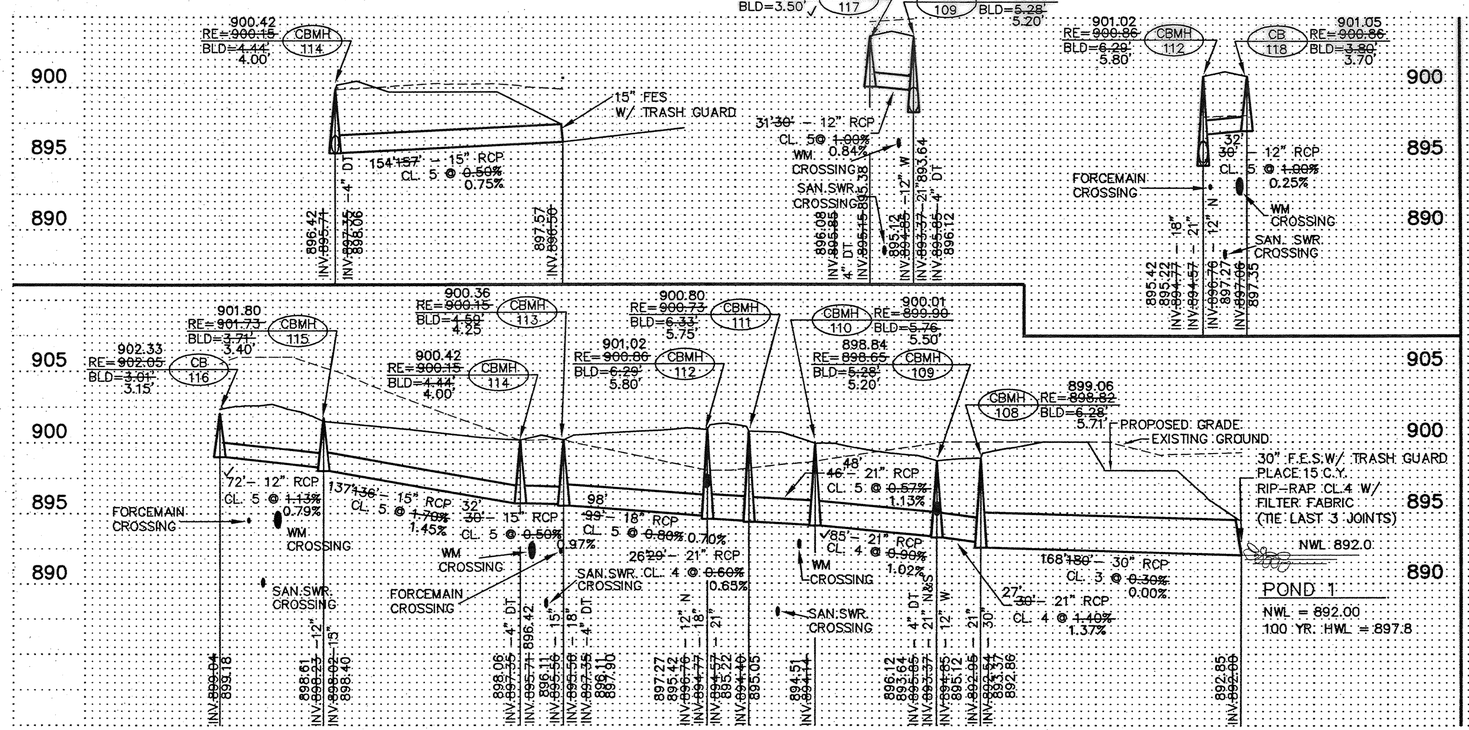

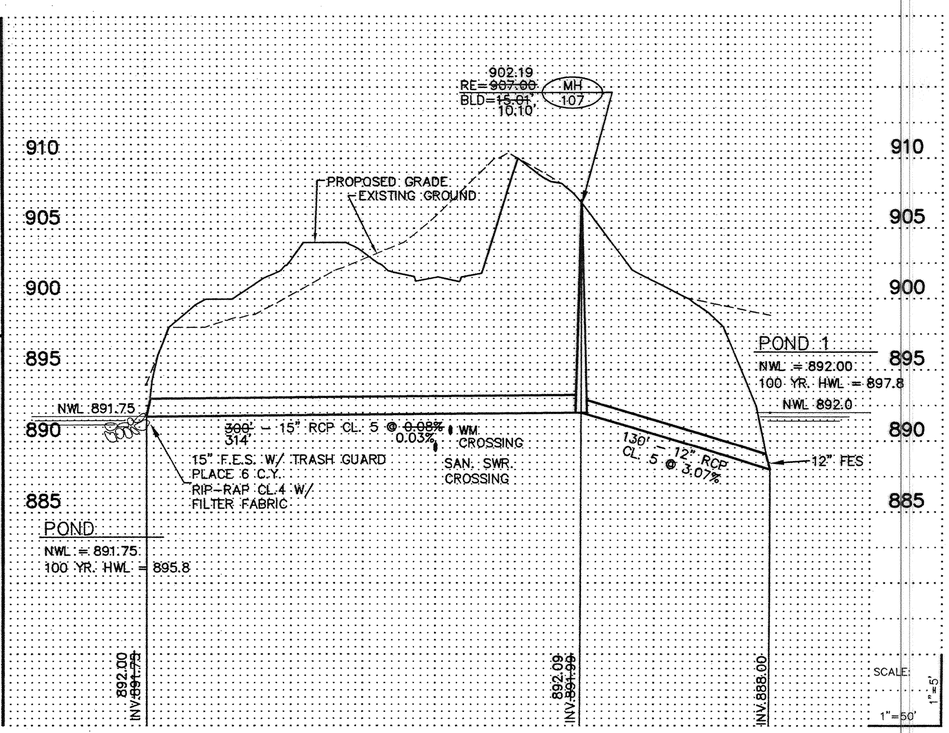

RECORD PLAN 03/11/03

2. AS-BUILT
1. PER CITY REVIEW.

Revisions
1. 10/1/01
2. 3/11/03

PIONEER engineering PA
LAND SURVEYORS • CIVIL ENGINEERS
LAND PLANNERS • LANDSCAPE ARCHITECTS
2422 Enterprise Drive, Mendota Heights, MN 55120, (651) 681-1914 FAX: 681-9488
625 Highway 10 N.E., Blaine, MN 55434, (763) 783-1880 FAX: 783-1883

I hereby certify that this plan was prepared by me or under my direct supervision and that I am a duly Licensed Professional Engineer under the laws of the State of Minnesota.

Name Paul J. Cherne
Reg. No. 19860 Date 8/31/01

Date	8/31/01
Designed	PJC
Drawn	SAG

SHEET TITLE: STORM SEWER

OWNER: GOLD NUGGET, 8857 ZEALAND AVENUE NORTH, BROOKLYN PARK, MINNESOTA 55445

PROJECT: KLIEVER LAKE FIELDS, PHASE 1

SHEET 9 OF 20 SHEETS

SAFCO PRODUCTS • NEW HOPE, MINNESOTA
REORDER BY PART NUMBER 62052
PRINTING SIDE OF PRINT ON THIS LINE

J:\Dwg\200376-ELK RIVER\Dwg\200376S06.dwg 03/30/2002 08:39:17 AM CST