KLIEVER LAKE FIELDS 2ND ADDITION

STREET AND UTILITY CONSTRUCTION PLANS

ELK RIVER, MINNESOTA

BENCHMARKS

DOUBLE SPIKE EAST FACE OF POWER POLE, WEST SIDE OF FILLMORE STREET N.W., 50± FT. SOUTH OF 178TH AVENUE N.W.. ELEVATION = 897.82 FT.

TRIPLE SPIKE EAST FACE OF POWER POLE, NW QUADRANT OF FILLMORE STREET AND 175TH AVENUE N.W.. ELEVATION = 909.73 FT.

SHEET INDEX

1. COVER SHEET
2. SANITARY SEWER AND WATERMAIN
   JOHNSON STREET NW.
3. SANITARY SEWER AND WATERMAIN
   179TH ST. NW.
4. SANITARY SEWER AND WATERMAIN
   180TH LANE NW. / 180TH COURT NW.
5. SANITARY SEWER AND WATERMAIN
6. STORM SEWER CONSTRUCTION
7. STORM SEWER CONSTRUCTION
8. STREET CONSTRUCTION
   JOHNSON ST. NW. / 179TH ST. NW.
9. STREET CONSTRUCTION
   179TH STREET NW.
10. STREET CONSTRUCTION
    180TH LANE NW. & 180TH COURT NW.
11. DETAILS
12. DETAILS
13. DETAILS

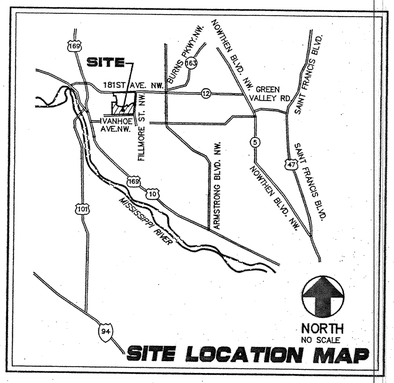

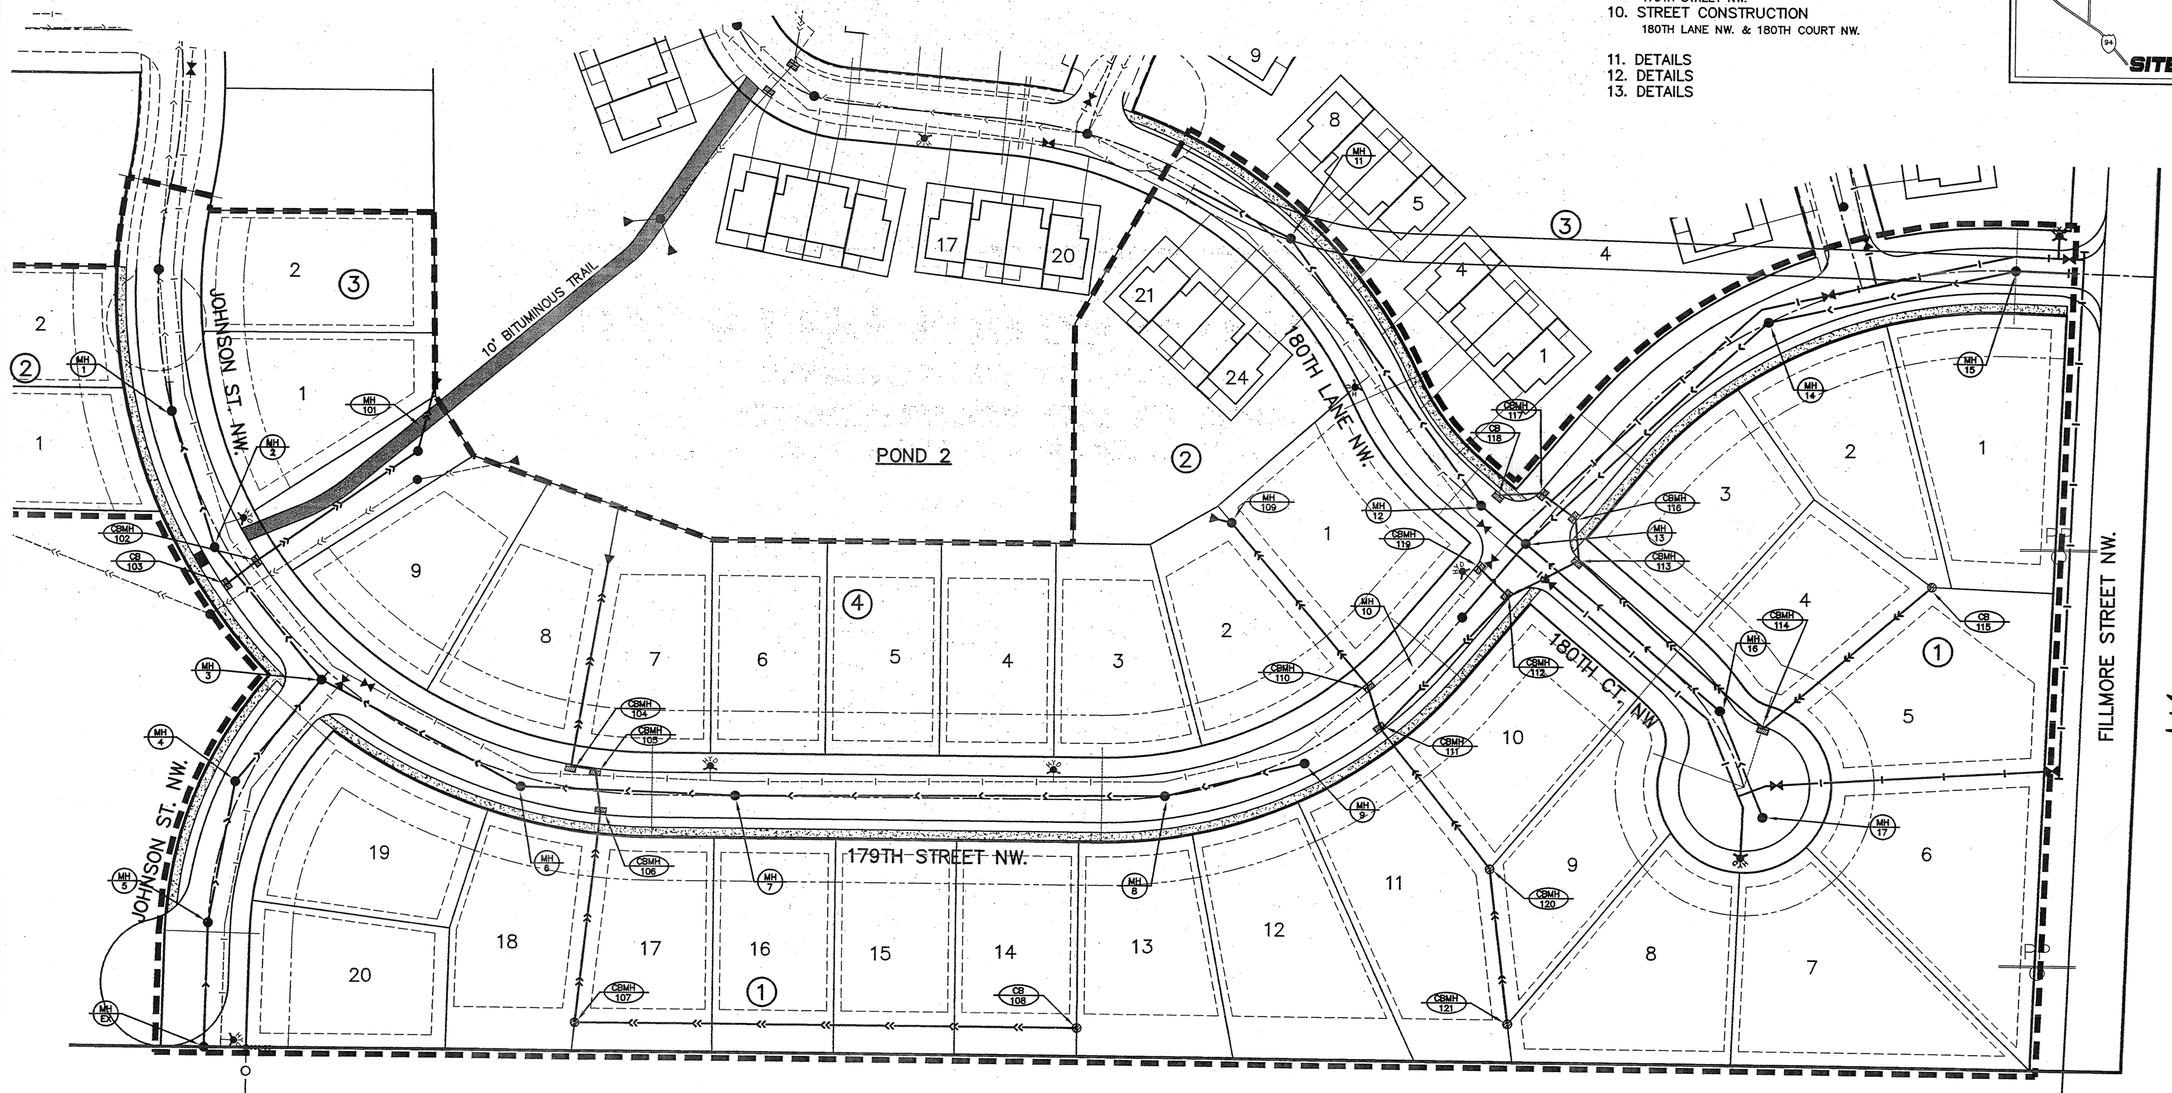

Prior to any excavation the contractor shall verify the location of all underground utilities.
Call 48 Hours before digging:
GOPHER STATE ONE CALL
Twin City Area 454-0002
Mn. Toll Free 1-800-252-1166

RECORD PLAN 1/14/05

PIONEER engineering, PA
LAND SURVEYORS • CIVIL ENGINEERS
LAND PLANNERS • LANDSCAPE ARCHITECTS
201 85th Avenue NW
Coon Rapids, MN 55433
(763) 783-1850 FAX:783-1883
2422 Enterprise Drive
Mendota Heights, MN 55120
(651) 681-1914 FAX:681-9488

I hereby certify that this plan was prepared by me or under my direct supervision and that I am a duly Licensed Professional Engineer under the laws of the State of Minnesota.

Name Brian F. Kallio
Reg. No. 25817 Date 7/8/04

Revisions
1. 7/8/04
2. 7/21/04
3. 8/3/04
4. 1/14/05

4. AS-BUILT
3. All Sheets
2. Sheets 4 & 6-11
1. Sheets 1-13

Date	6/3/04
Designed	B.F.K.
Drawn	LC

SHEET TITLE: COVER SHEET

OWNER: GSS PROPERTIES, LLC
8857 ZEALAND AVENUE NORTH
BROOKLYN PARK, MINNESOTA 55445

PROJECT: KLIEVER LAKE FIELDS 2ND ADDITION
ELK RIVER, MINNESOTA

SHEET 1 OF 13 SHEETS

L:\Engineering\200376 - KlieverLakeFields\2nd Addition\200376CVR
Plot Date: Feb 04, 2005

#200376

STREET AND UTILITY CONSTRUCTION PLANS

DRAWING NUMBER

SAFCO PRODUCTS • NEW HOPE, MINNESOTA
REORDER BY PART NUMBER 60532
POSITION SAME AS PRINT ON THIS LINE

DRAWING NUMBER

SAFCO PRODUCTS • NEW HOPE, MINNESOTA
REORDER BY PART NUMBER 60532
POSITION SAME AS PRINT ON THIS LINE

DRAWING NUMBER

SAFCO PRODUCTS • NEW HOPE, MINNESOTA
REORDER BY PART NUMBER 60532
POSITION SAME AS PRINT ON THIS LINE

DRAWING NUMBER
KLIEV.04
1

SAFCO PRODUCTS • NEW HOPE, MINNESOTA
REORDER BY PART NUMBER 60532
POSITION SAME AS PRINT ON THIS LINE