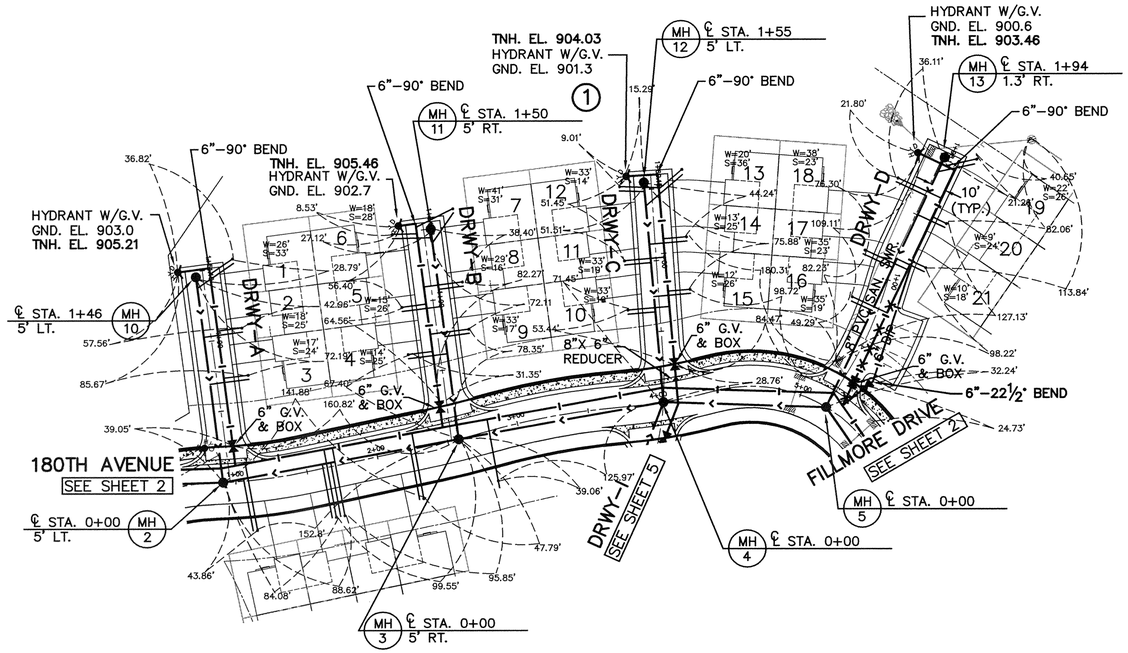

GENERAL NOTES:

1.) SANITARY SEWER SERVICES SHALL BE 4" PVC SDR-~~35~~ 26.

2.) SANITARY SEWER SERVICE WYES ARE STATIONED FROM DOWN STREAM MANHOLE OR MAINLINE WYE CONNECTION FOR 6" LATERAL RUNS

3.) WATER SERVICES SHALL BE 1" COPPER TYPE "K" W/ 7.5' MINIMUM COVER.

4.) SANITARY SEWER INVERTS ARE SHOWN AT THE BEND JUST BEFORE THE RISER PIPE.

5.) SANITARY SEWER & WATER SERVICES SHALL BE CONSTRUCTED 10' BEYOND RIGHT-OF-WAY. SERVICES ON PRIVATE STREET SHALL BE INSTALLED AT THE LOCATIONS SHOWN ON THE PLANS.

6.) EXISTING SERVICES TO BE REMOVED TO THE ~~CURB STOP~~ CORPORATE

SANITARY SEWER SERVICES SCHEDULE

LOT	BLOCK	STATION	C.S.	INV. @ CURB STOP
1	1	1+38	903.2	895.2
2	1	1+03	903.2	895.2
3	1	0+69	903.1	895.1
4	1	0+61	902.5	894.5
5	1	0+94	902.6	894.6
6	1	1+43	902.9	894.9
7	1	1+40	902.4	894.4
8	1	1+07	902.5	894.5
9	1	0+73	902.1	894.1
10	1	0+64	901.9	893.9
11	1	0+99	901.9	893.9
12	1	1+49	901.7	893.7
13	1	1+39	901.0	893.0
14	1	1+12	901.8	893.8
15	1	0+75	901.7	893.7
16	1	0+75	901.2	893.2
17	1	1+09	901.3	893.3
18	1	1+64	900.8	892.8
19	1	1+83	901.2	893.2
20	1	1+50	901.4	893.4
21	1	1+16	901.7	893.7

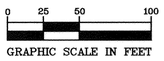

BENCHMARK

DOUBLE SPIKE EAST FACE OF POWER POLE WEST OF FILLMORE STREET NW. 50 FT SOUTH OF 178TH AVE. NW. ELEVATION = 897.82

TRIPLE SPIKE EAST FACE OF POWER POLE NW QUADRANT OF FILLMORE STREET AND 175TH AVENUE NW. ELEVATION = 909.73

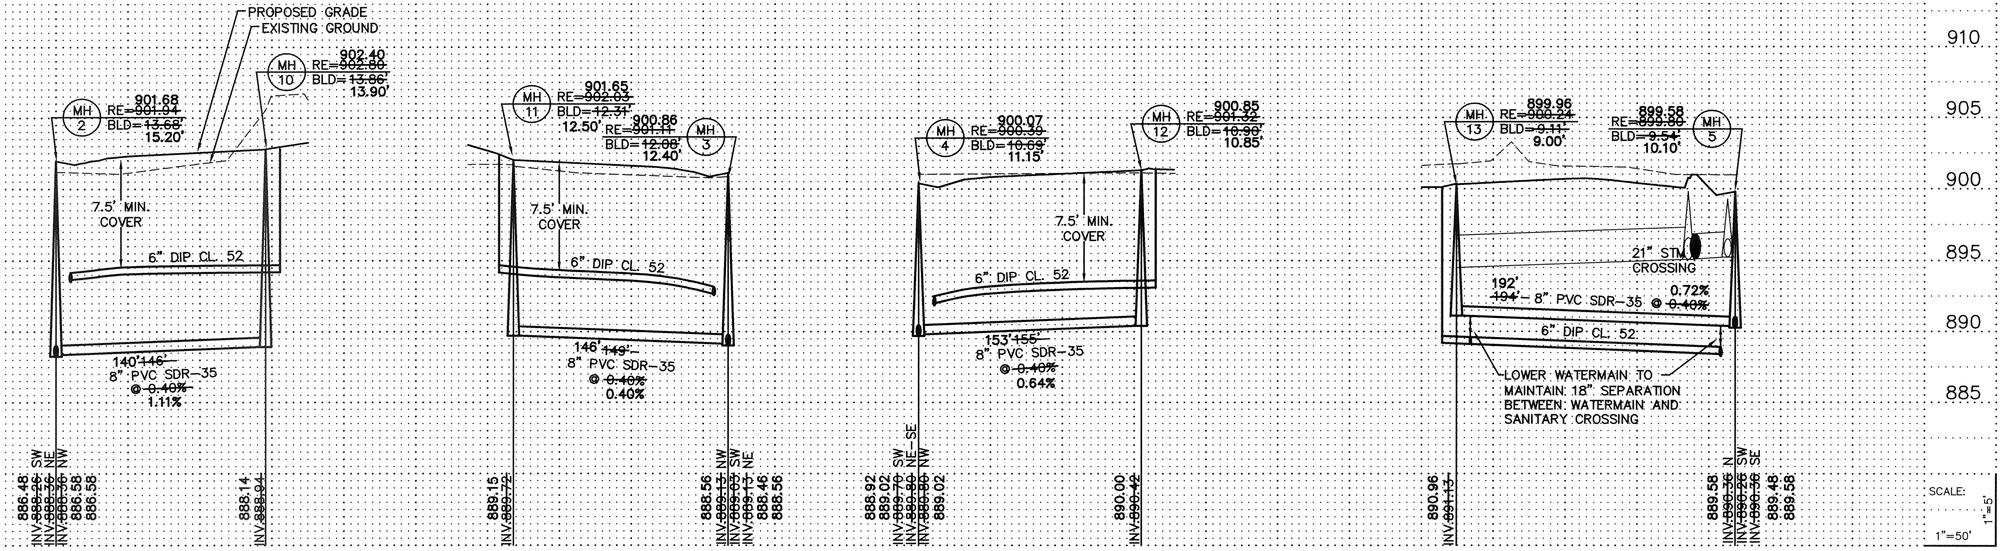

RECORD PLAN 2/22/2006

PIONEER *engineering*
CIVIL ENGINEERS LAND PLANNERS LAND SURVEYORS LANDSCAPE ARCHITECTS

2422 Enterprise Drive
Mendota Heights, MN 55120
(651)681-1914 Fax:681-9488

Coon Rapids Office

201 85th Avenue N.W.
Coon Rapids, MN 55433
(763) 783-1880 Fax:783-1883

I hereby certify that this plan was prepared by me or under my direct supervision and that I am a duly Licensed Professional Engineer under the laws of the State of Minnesota.

Name Christopher J. Huntley
Reg. No. 44246 Date 08/05/05

3. PRE-CON NOTES
2. CITY COMMENTS
1. CITY COMMENTS

Revisions
1. 08/18/05
2. 09/01/05
3. 09/02/05

Date 08/05/05
Designed C.J.H.
Drawn kAp

SANITARY SEWER & WATERMAIN

MEADOW CREEK BUILDERS
6382 BALSAM LANE
MAPLE GROVE, MN 55369

KLIEVER LAKE FIELDS 3RD
ELK RIVER, MINNESOTA

3 OF 11

DRAWING NUMBER
3
KLIEVLKFLD3.06

SAFCO PRODUCTS • NEW HOPE, MINNESOTA
REORDER BY PART NUMBER 65052
POSITION EDGE OF PRINT ON THIS LINE

L:\Engineering\200376 - Kliever\Land\Fields\200145-Kliever Lake Fields\Cu\200145431
Plotted: 5/4/06 9:47am By: Chris Huntley
Page Setup: ANSI_B Plot Scale: 1.000000
Xrefs: 200145SBA; 200145SBT; 200145BM; BENCHMARK