VERNON / TIPTON STREET NW

RECORD DRAWINGS

STORM SEWER

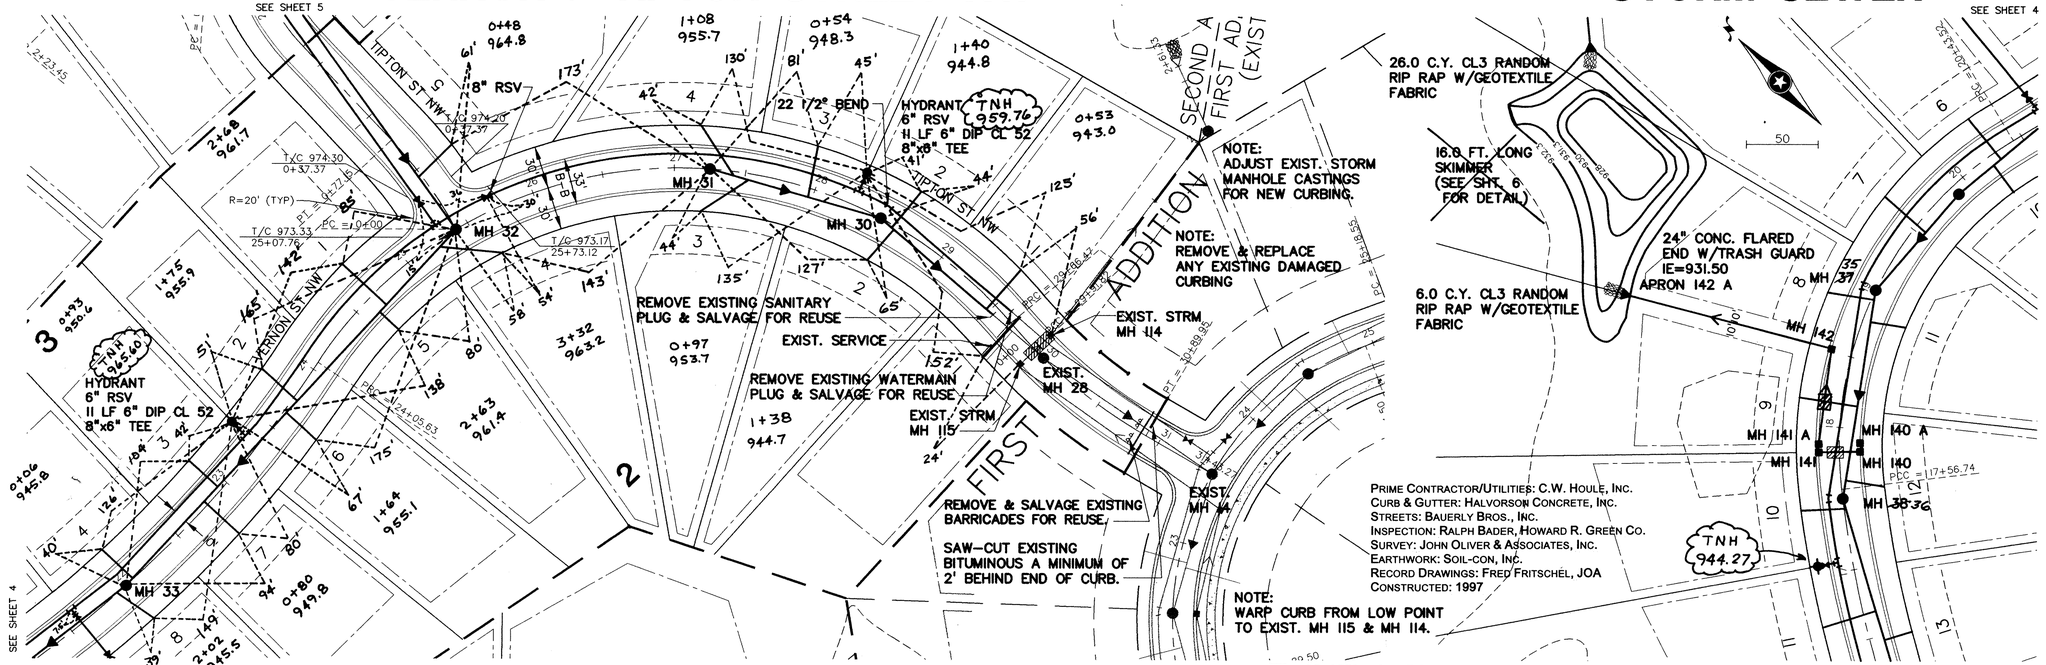

PRIME CONTRACTOR/UTILITIES: C.W. HOULE, INC.
CURB & GUTTER: HALVORSON CONCRETE, INC.
STREETS: BAUERLY BROS., INC.
INSPECTION: RALPH BADER, HOWARD R. GREEN CO.
SURVEY: JOHN OLIVER & ASSOCIATES, INC.
EARTHWORK: SOIL-CON, INC.
RECORD DRAWINGS: FRED FRITSCHEL, JOA
CONSTRUCTED: 1997

NOTE: CENTERLINE STREET ELEVATIONS WERE NOT SHOT AFTER CONSTRUCTION.

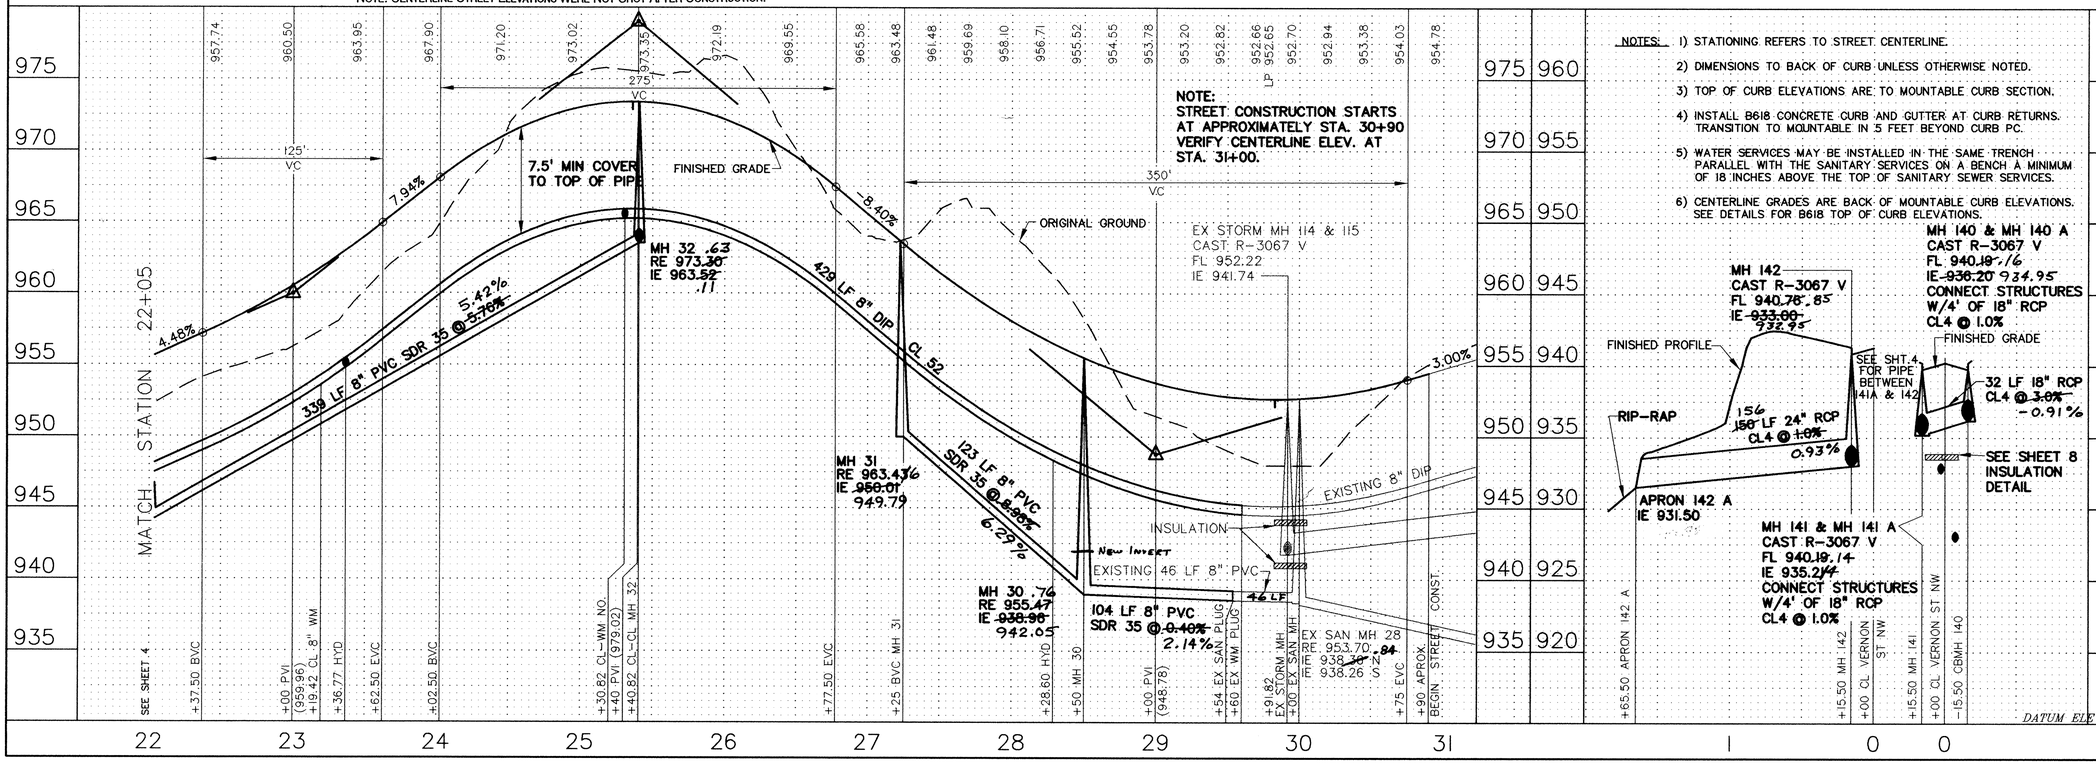

REV NO.	DATE	DESCRIPTION
1	7/31/97	PER ENGINEER REVIEW LETTER DATED 7/25/97
2	8/21/97	REVISED STORM SEWER & PONDING AREA
3	9/05/97	REVISED STORM SEWER & PONDING AREA
4	10/01/97	REVISED SANITARY SEWER @ WATERMAIN
5	10/14/97	REVISED SANITARY SEWER @ WATERMAIN
6	11/06/97	REVISED SANITARY SEWER @ WATERMAIN
7	2/09/98	RECORD DRAWINGS

DATE: 9/26/97
DESIGN BY: GD
DRAWN BY: BG
CHECKED BY: GD JB
DWG FILE: 3-TIP
TEXT FILE: NONE
FILE NO.: 7024.20-03

I hereby certify that this plan was prepared by me or under my direct supervision and that I am a duly Registered Professional Engineer under the laws of the State of Minnesota.

Signed: [signature]
Date: 9/26/97 Reg. No. 14960

John Oliver & Associates, Inc.
Civil Engineering, Land Surveying, Land Planning
560 Dodge Avenue, Elk River, Minnesota 55330 (612)441-2072 (FAX)441-5665
201 W. Travelers Trail, Suite 200, Burnsville, MN 55337 (612)894-3045 (FAX)894-3049

LAFAYETTE WOODS SECOND ADDITION
ELK RIVER, MN
WINDSOR DEVELOPMENT L.L.P.
SANITARY SEWER, WATERMAIN, STORM SEWER AND STREET PLAN
VERNON/TIPTON ST NW & STORM SEWER

SHEET NO. 3 OF 9

DRAWING NUMBER 3
LAFAY2N.97

1261