STORM SEWER

195TH COURT & WATERMAIN

RECORD DRAWINGS

NOTES: 1) STATIONING REFERS TO STREET CENTERLINE.

2) WATER SERVICES MAY BE INSTALLED IN THE SAME TRENCH PARALLEL WITH THE SANITARY SERVICES ON A BENCH A MINIMUM OF 18 INCHES ABOVE THE TOP OF SANITARY SEWER SERVICES.

3) ROUGH GRADING TO FUTURE SUBGRADE TO BE PROVIDED BY SEPARATE CONTRACT.

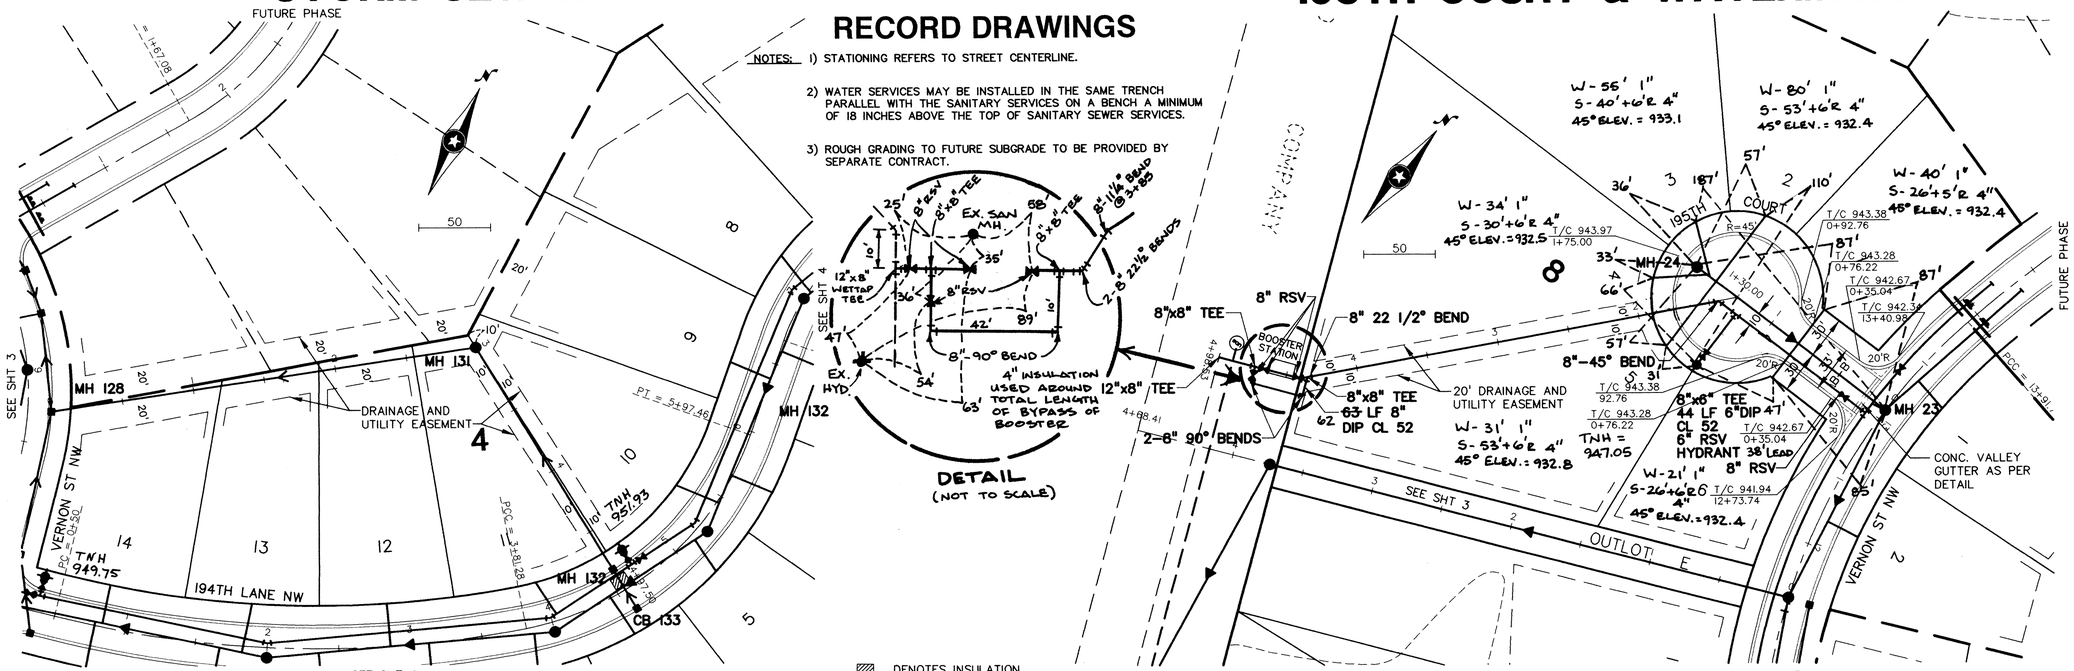

▨ DENOTES INSULATION

NOTE: CENTERLINE STREET ELEVATIONS WERE NOT SHOT AFTER CONSTRUCTION.

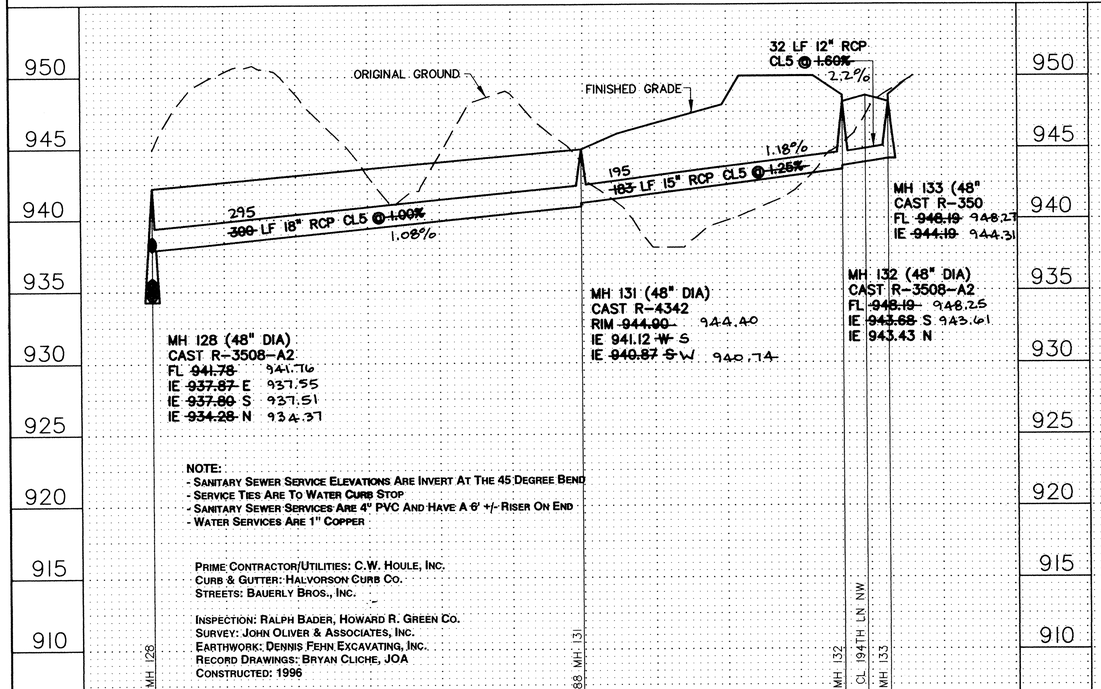

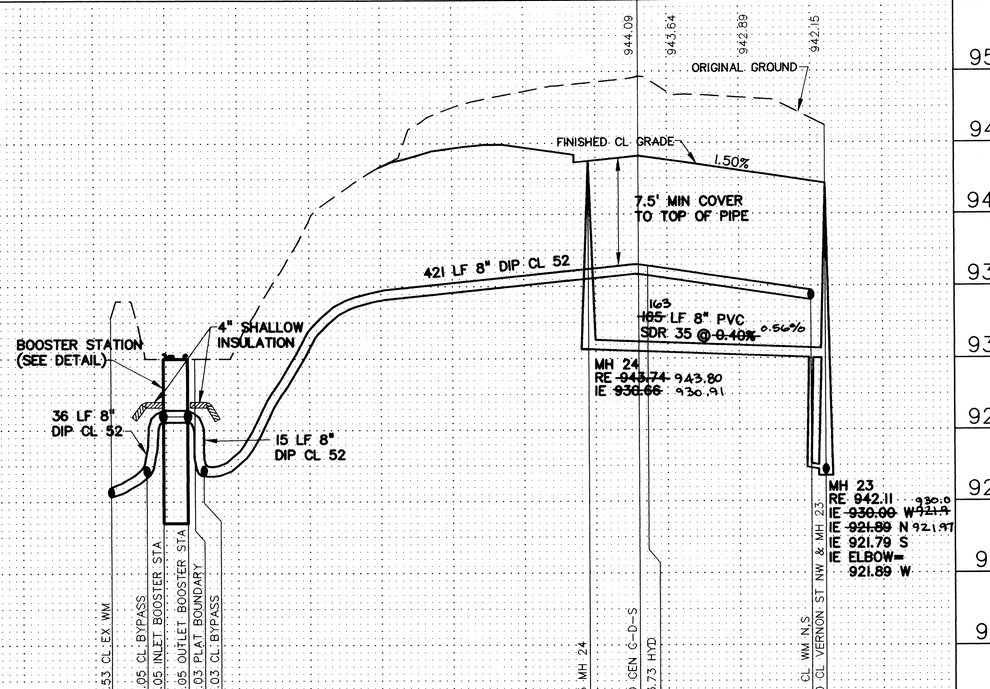

REV NO.	DATE	DESCRIPTION
1	05/14/96	EXPANDED PHASE 1 REVISIONS
2	06/05/96	MINOR REVISIONS, STREET NAMES
3	06/25/96	GENERAL REVISIONS, CITY COMMENTS
4	11/4/97	RECORD PLANS

DATE: 04/30/96
DESIGN BY: JB
DRAWN BY: BG
CHECKED BY: JB
DWG FILE: 3-UPLND.
TEXT FILE: NONE
FILE NO.: 7024.10-03

I hereby certify that this plan was prepared by me or under my direct supervision and that I am a duly Registered Professional Engineer under the laws of the State of Minnesota.

Signed:
Date: 04/30/96 Reg. No.19900

John Oliver & Associates, Inc.
Civil Engineering, Land Surveying, Land Planning
580 Dodge Avenue
Elk River, Minnesota 55330
(612)441-2072 (FAX)441-5665
201 W. Travelers Trail, Suite 200
Burnsville, MN 55337
(612)894-3045 (FAX)894-3049

LAFAYETTE WOODS
ELK RIVER, MN
WINDSOR DEVELOPMENT L.L.P.
SANITARY SEWER, WATERMAIN,
STORM SEWER AND STREET PLAN
STORM SEWER, 195TH CRT, WATERMAIN

SHEET NO. 9 OF 15

1127

DRAWING NUMBER
LAFAY.96
9

SHERCO PRODUCTS • NEW HOPE, MINNESOTA
REORDER BY PART NUMBER 10000
PRINTED SIDE OF PAPER ON THIS LINE