©2002 Westwood Professional Services, Inc.

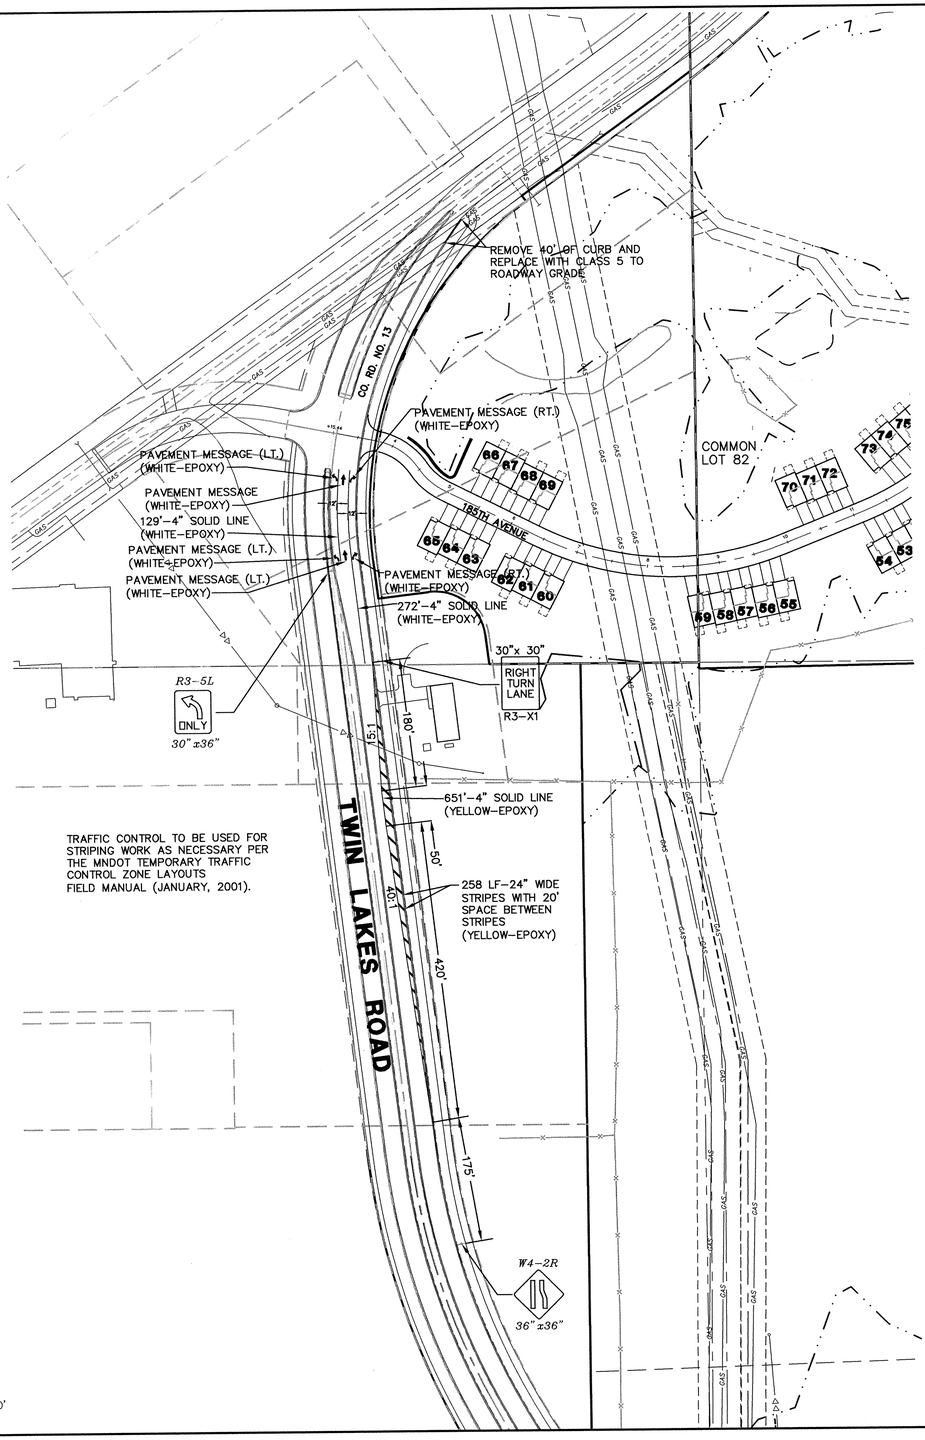

Call 48 Hours before digging:
GOPHER STATE ONE CALL
Twin City Area 651-454-0002
Mn. Toll Free 1-800-252-1166

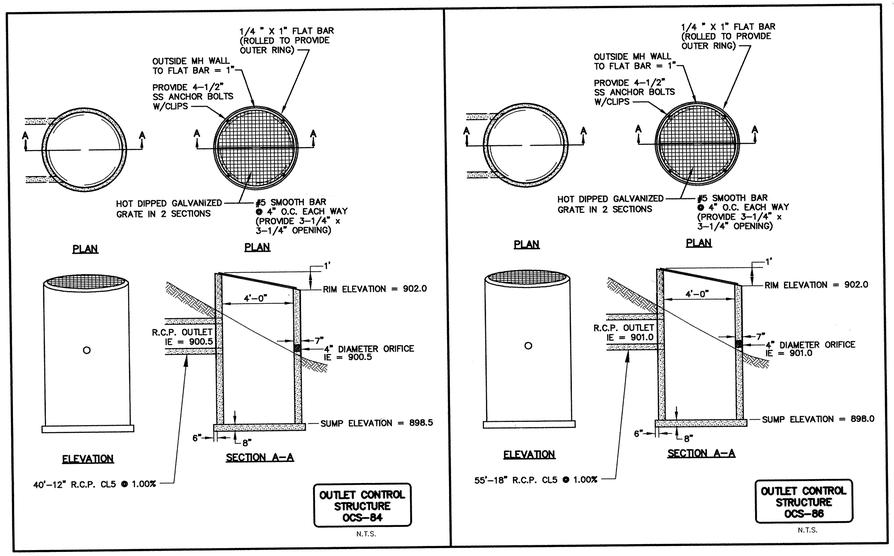

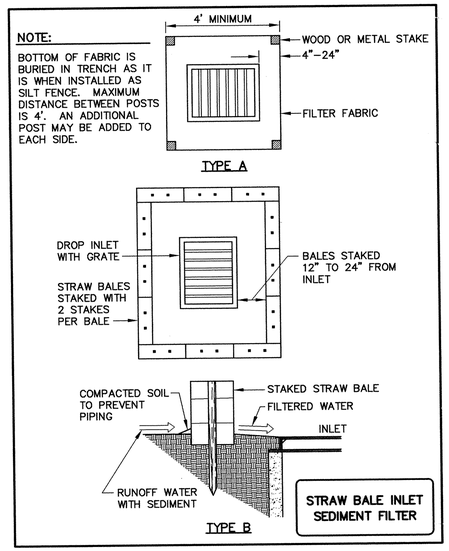

CONTRACTOR: RYAN CONTRACTING

RECORD DRAWING
CONFORMING TO CONSTRUCTION RECORDS.
BY ALLAN SPILLES DATE 01/21/05
WESTWOOD PROFESSIONAL SERVICES

Latest Revision Date: 04/22/03
E-3 20011092DE05.DWG

Date: 07/12/02 Sheet: 14 OF 14

Marshes of Trott Brook Farms

Elk River, Minnesota

Street Sections & Outlet Control Structure Details

Westwood Professional Services, Inc.
7599 Anagram Drive
Eden Prairie, MN 55344
Phone: 952/937-5150 Fax: 952/937-5822

I hereby certify that this plan was prepared by me or under my direct supervision and that I am a duly licensed PROFESSIONAL ENGINEER under the laws of the State of Minnesota.
Francis D. Hagen, II
Date: 01/21/05 License No. 17716

Revisions:
08/05/02 City Review (CLJ)
08/19/02 City Review (JPB)
04/22/03 185th Avenue Over Gas Lines (CLJ)
01/21/05 RECORD DRAWING (AS/GKB)

Designed: FDH, II
Checked: FDH, II
Drawn: WH/RNS
Record Drawing by/date: AS 1/21/05

Prepared for:

D.R. Horton, Inc.
20860 Kenbridge Court, Suite 100
Lakeville, Minnesota 55044

P:\20011092\dwg\RECORD\20011092DE05.dwg 01/18/2005 03:34:17 PM CST

DRAWING NUMBER
SAFCO PRODUCTS • NEW HOPE, MINNESOTA
REORDER BY PART NUMBER 6502
POSITION EDGE OF PRINT ON THIS LINE
DRAWING NUMBER
MTROTT.02
14