
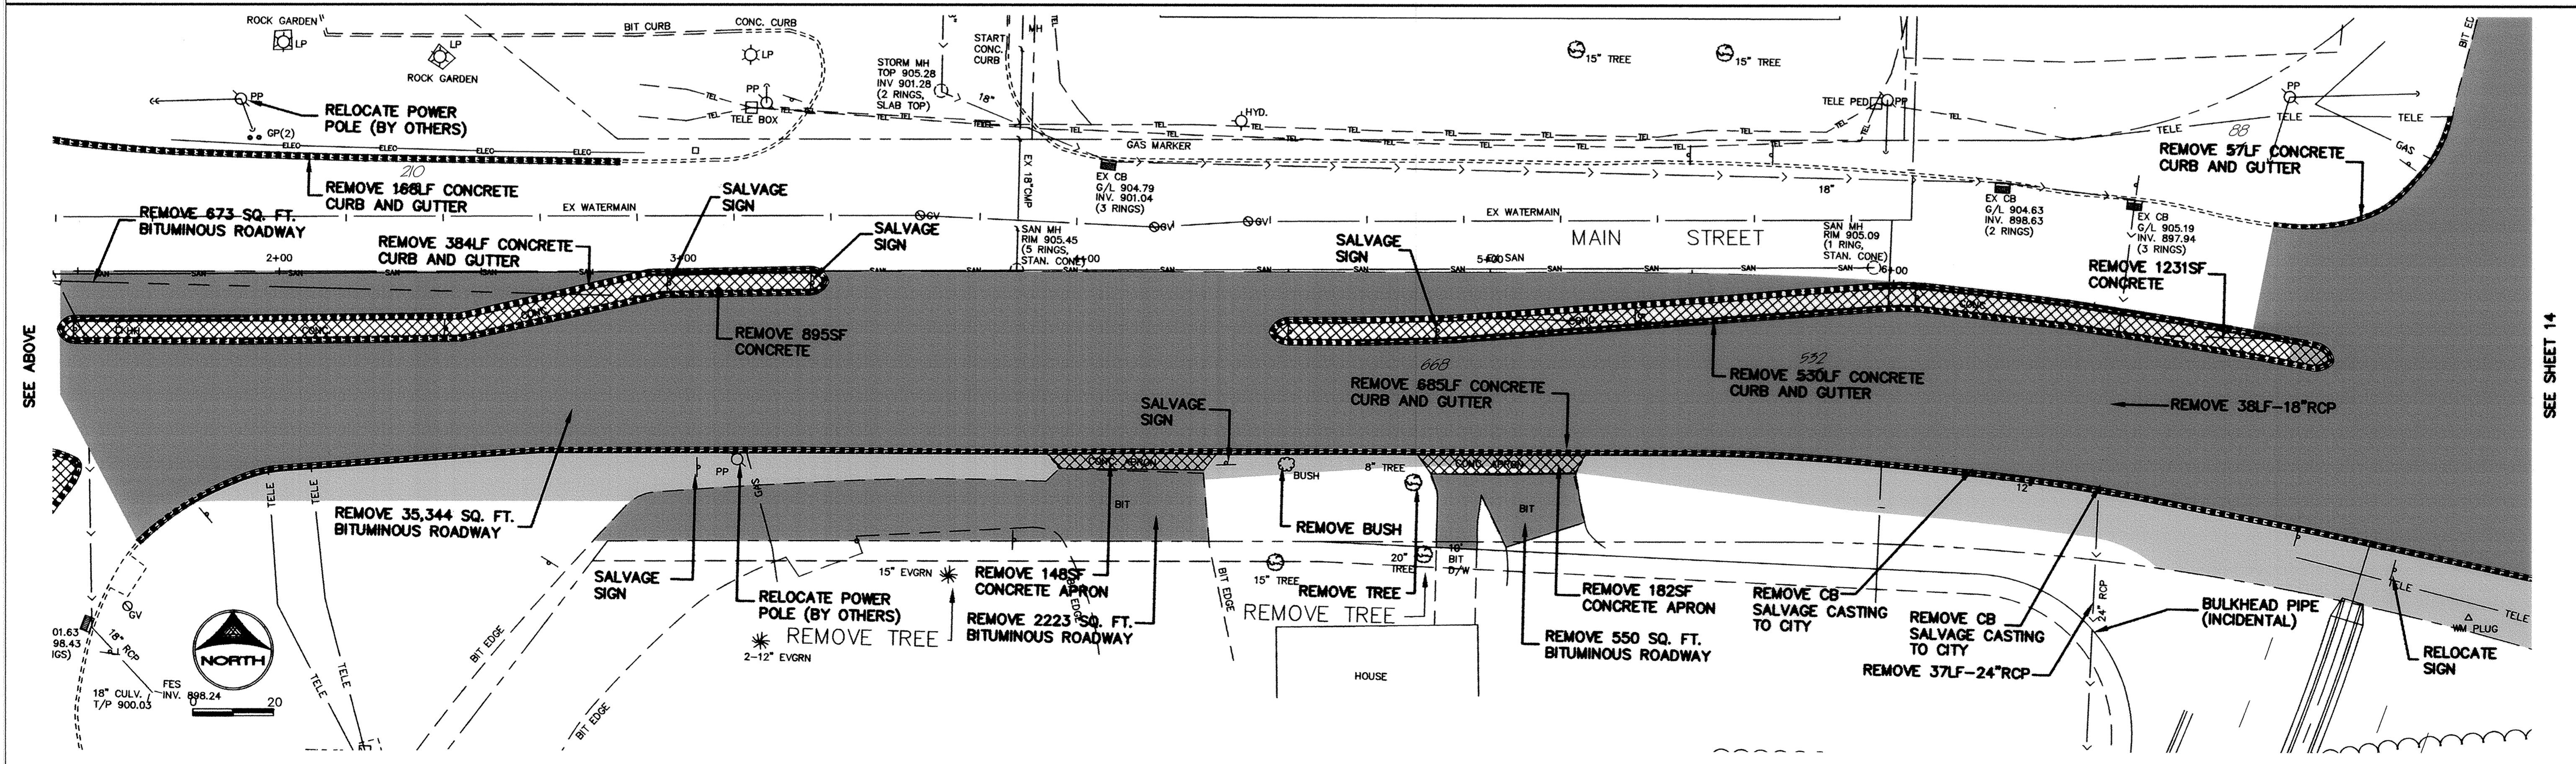


MAIN ST. / TH 169

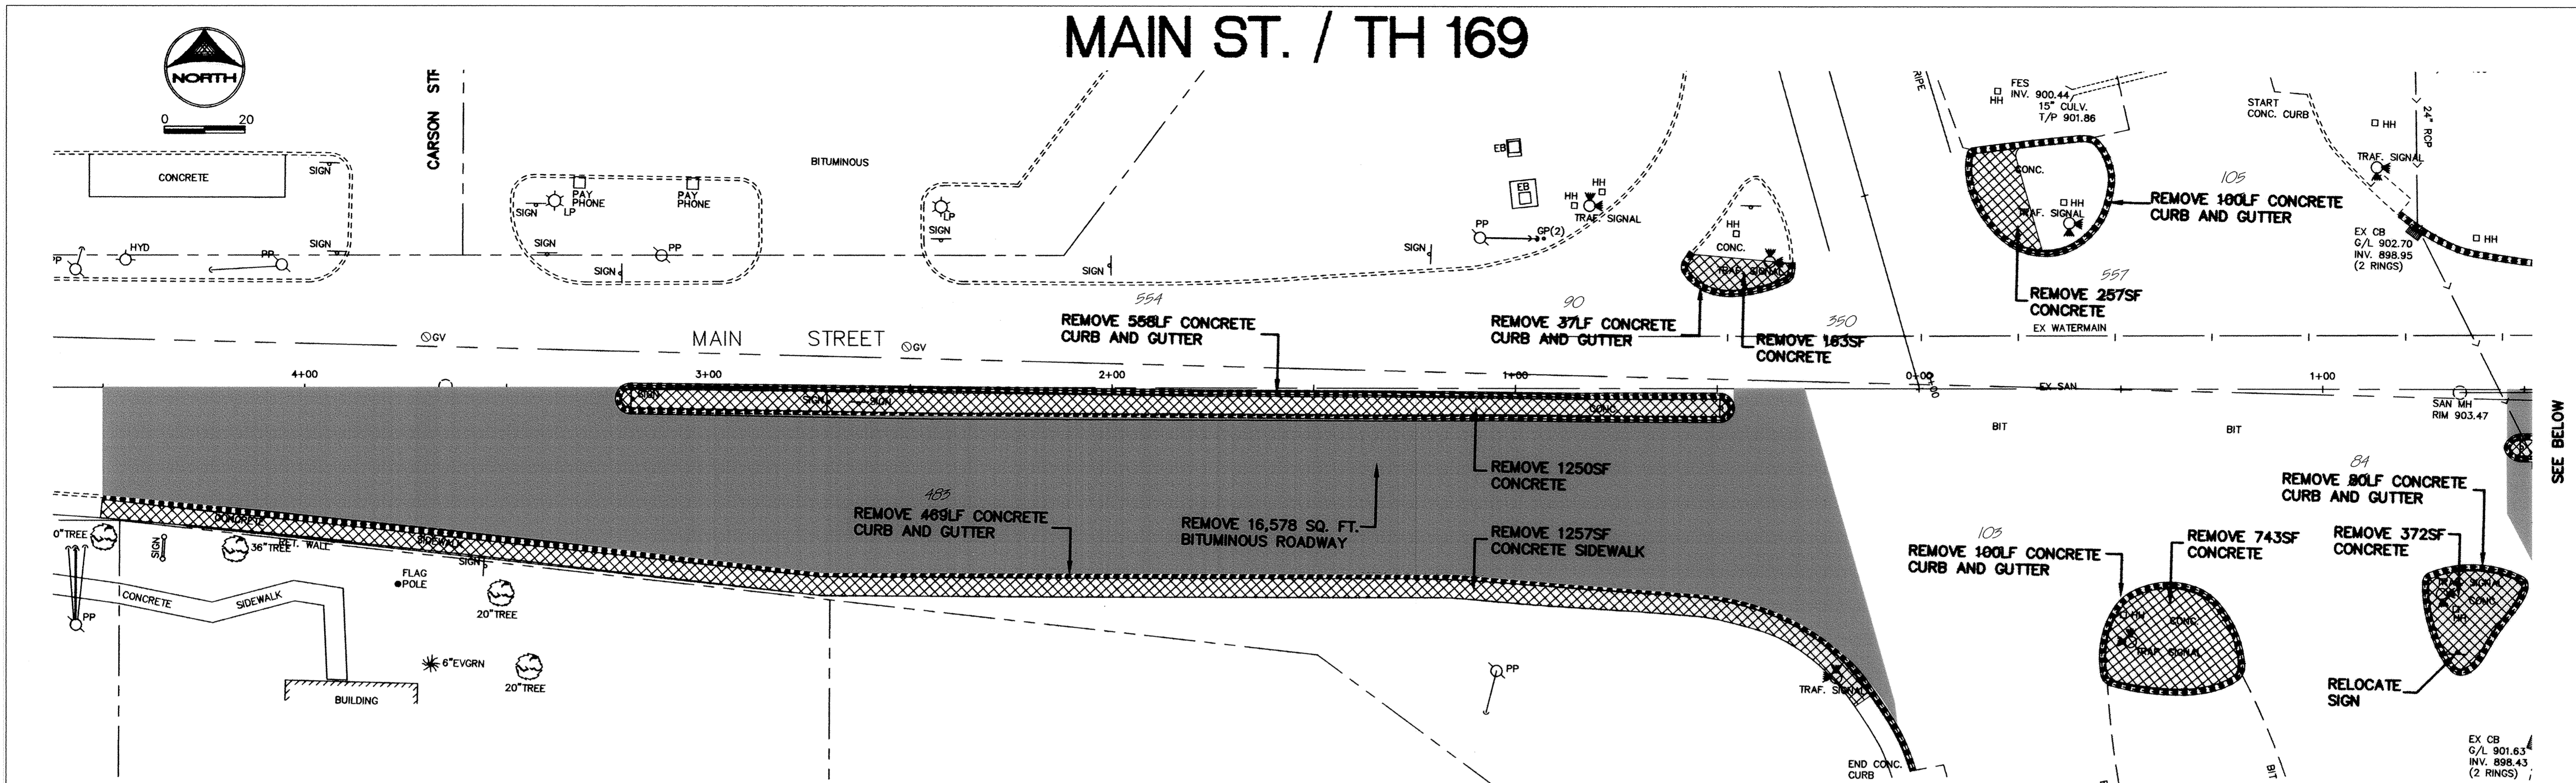

DESIGNED BY: DESIGNED_BY DRAWN BY: EY
 APPROVED BY: APPROVED_BY JOB NUMBER 808200
 CAD DATE: June 22, 2000 11:16:24 a.m.
 CAD FILE: 808200\808200R1.DWG

I HEREBY CERTIFY THAT THIS PLAN, SPECIFICATION, OR REPORT WAS PREPARED BY ME OR UNDER MY DIRECT SUPERVISION AND THAT I AM A DULY REGISTERED PROFESSIONAL ENGINEER UNDER THE LAWS OF THE STATE OF MINNESOTA.
 DATE _____ REG. NO. _____

NO.	DATE	BY	REVISION DESCRIPTION

1326 ENERGY PARK DRIVE
 ST. PAUL, MINNESOTA 55108
 (651) 644-4389

Howard R. Green Company
 CONSULTING ENGINEERS

CITY OF ELK RIVER
 EASTERN AREA PHASE II
 STREET AND UTILITY IMPROVEMENTS

REMOVAL PLAN
 MAIN ST. / TH 169
 S.A.P. 204-113-09 0+000 TO 0+500

SHEET NO.
13
 OF
46

DRAWING NUMBER MAINS.00 3