



WEST MAIN STREET

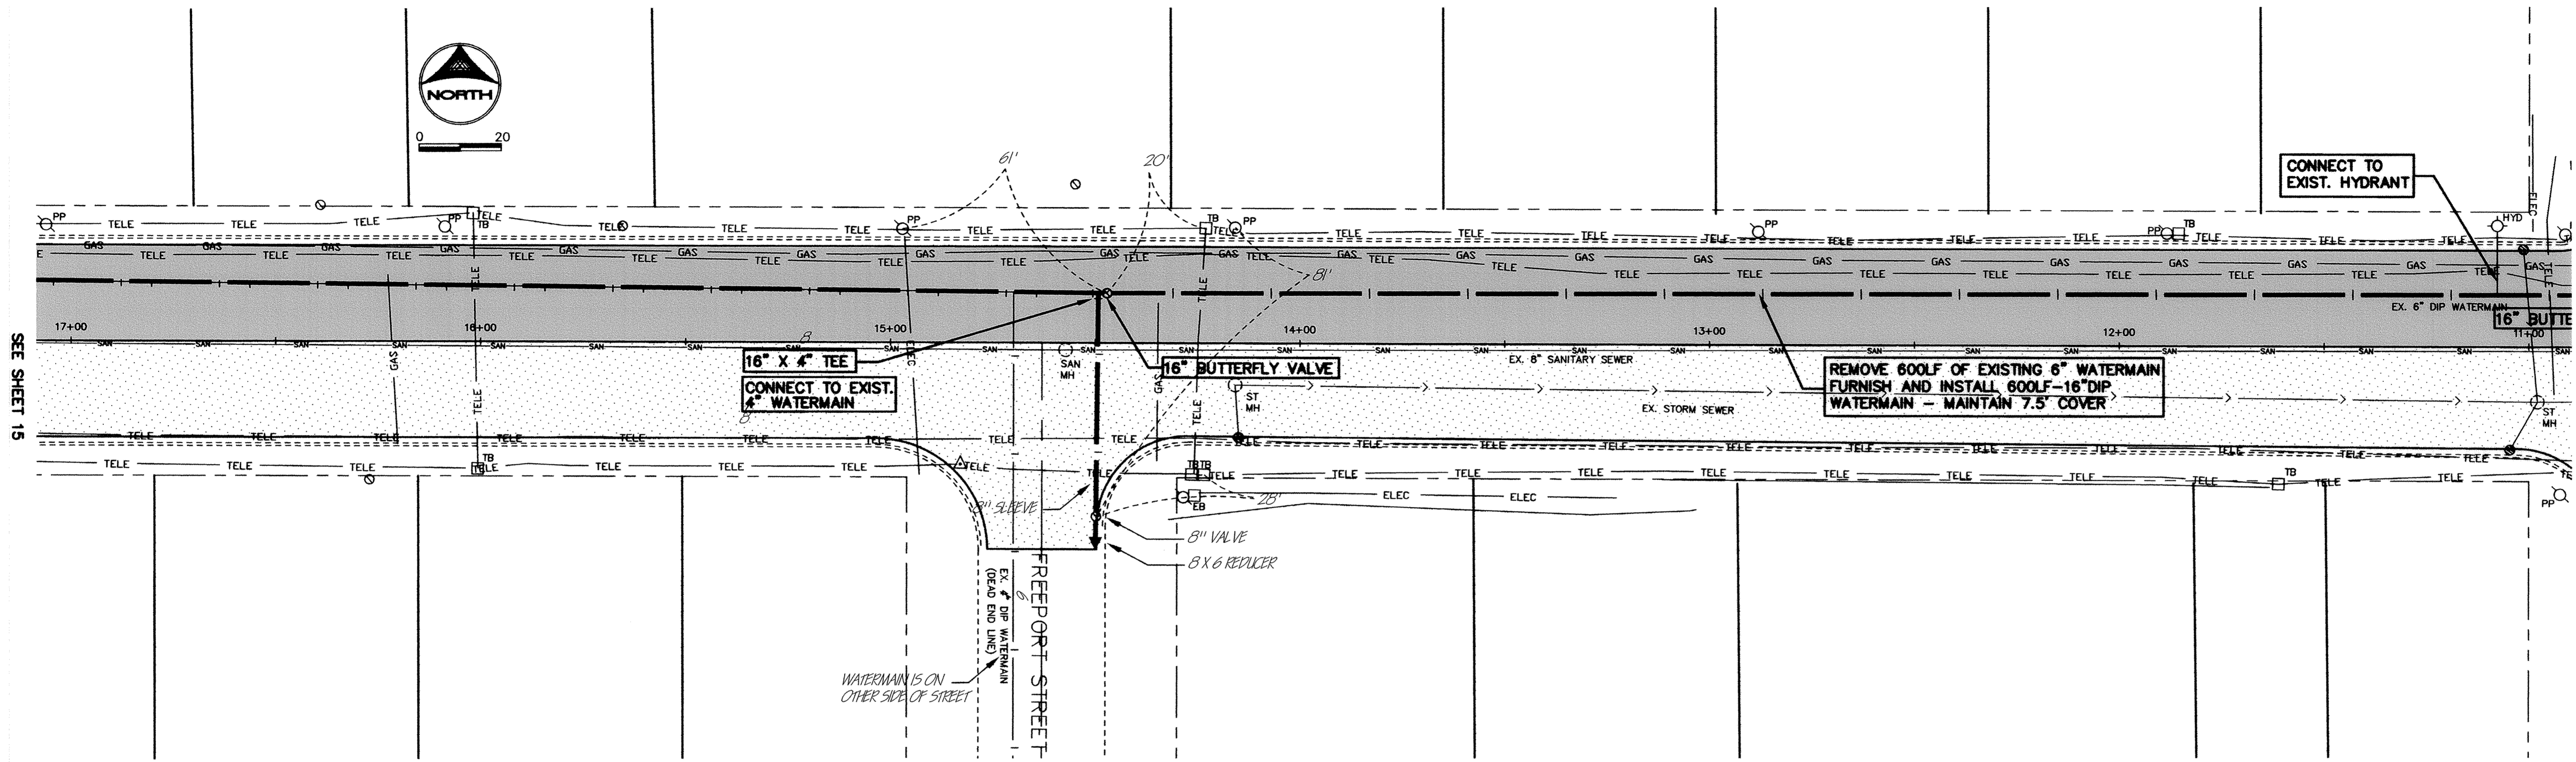

SEE SHEET 15

SEE BELOW

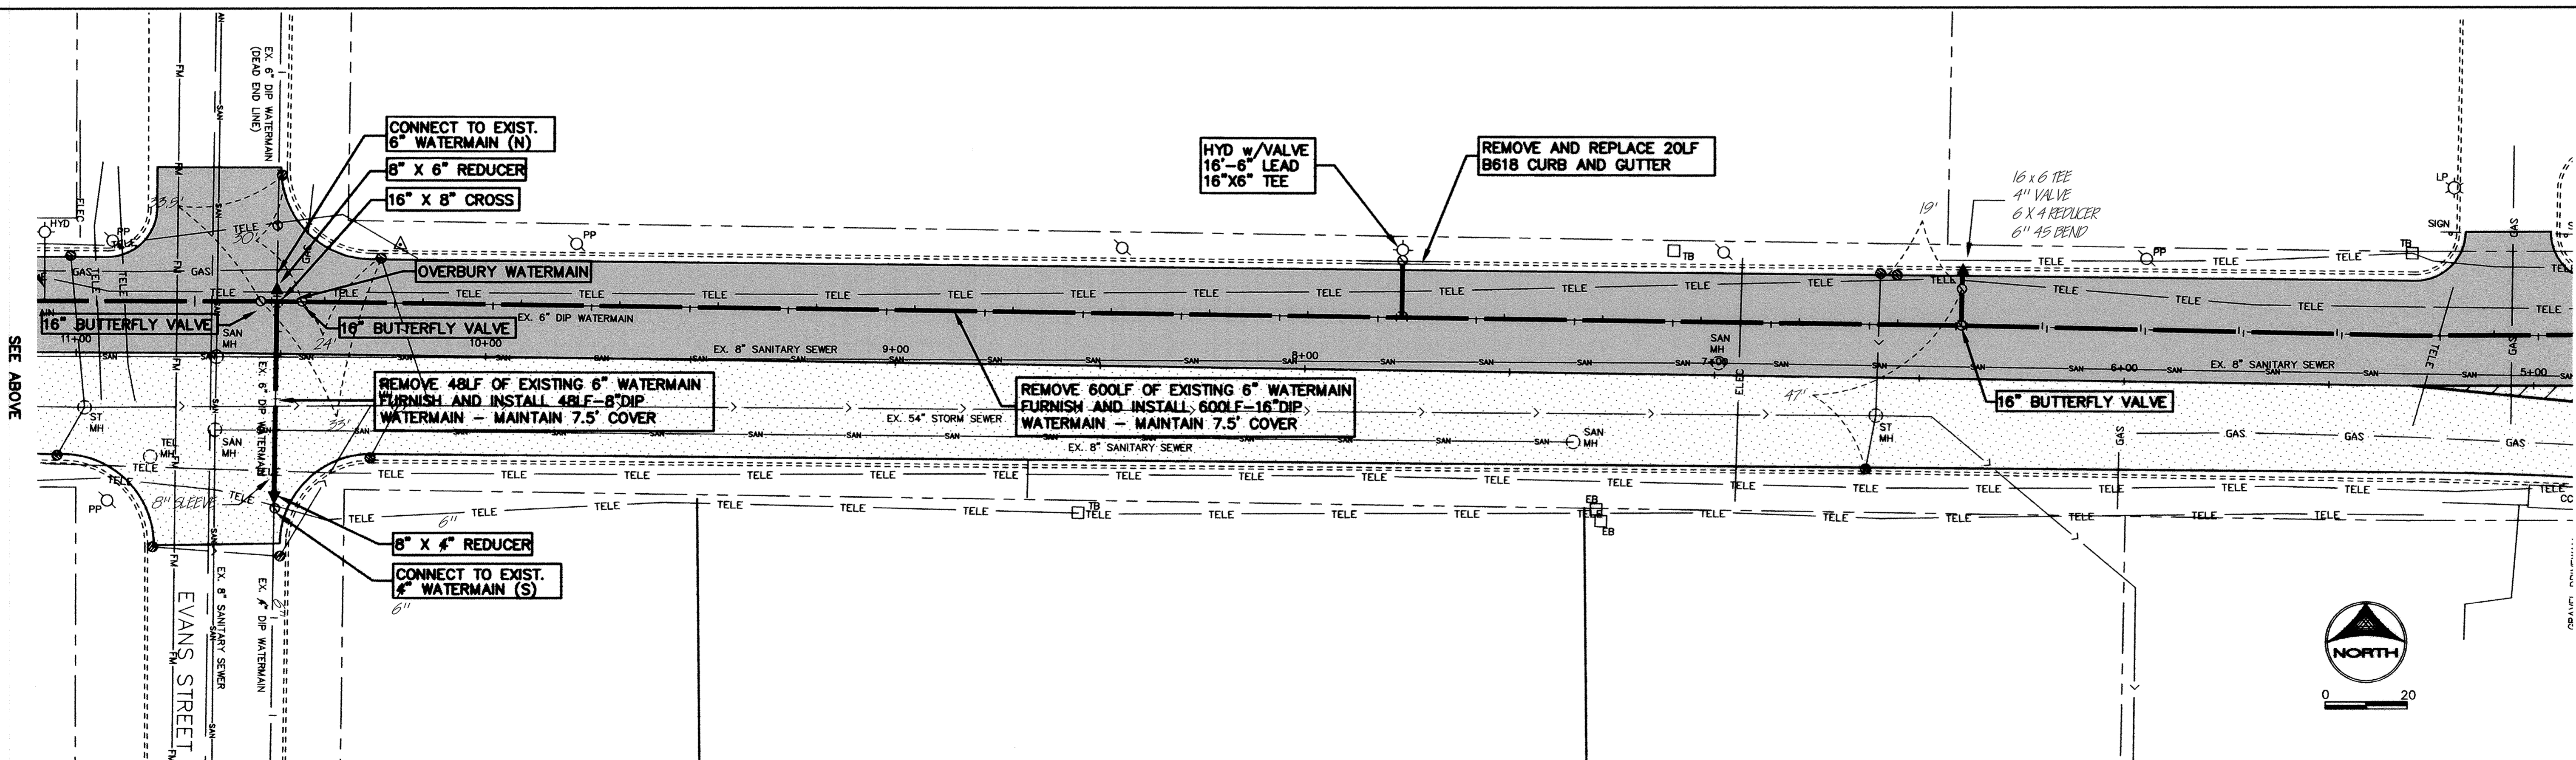

SEE ABOVE

SEE SHEET 17



DESIGNED BY: DESIGNED_BY DRAWN BY: EY
 APPROVED BY: APPROVED_BY JOB NUMBER 808200
 CAD DATE: June 23, 2000 5:20:13 a.m.
 CAD FILE: 808200j_808200P-4A.DWG

I HEREBY CERTIFY THAT THIS PLAN, SPECIFICATION, OR REPORT WAS PREPARED BY ME OR UNDER MY DIRECT SUPERVISION AND THAT I AM A DULY REGISTERED PROFESSIONAL ENGINEER UNDER THE LAWS OF THE STATE OF MINNESOTA.

DATE _____ REG. NO. _____

NO.	DATE	BY	REVISION DESCRIPTION



Howard R. Green Company
 CONSULTING ENGINEERS

1326 ENERGY PARK DRIVE
 ST. PAUL, MINNESOTA 55108
 (651) 644-4389

CITY OF ELK RIVER
 EASTERN AREA PHASE III
 STREET AND UTILITY IMPROVEMENTS

WATERMAIN IMPROVEMENTS AND STREET RECONSTRUCTION
 WEST MAIN STREET
 17+00 TO 5+00

SHEET NO.
16
 OF
46

DRAWING NUMBER



MAINS.00
5




