Fed. Proj. No.

MAIN STREET

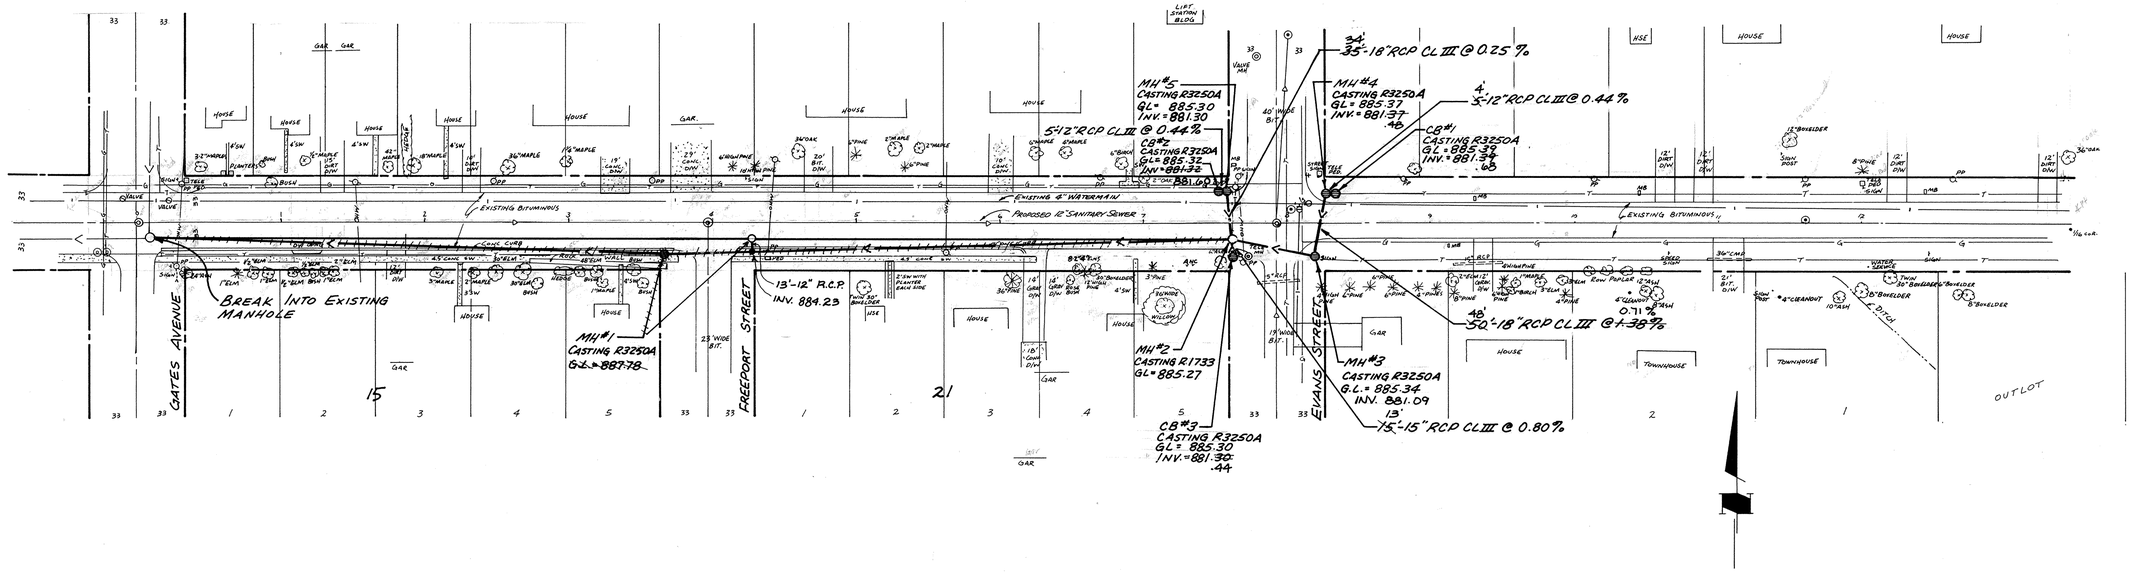

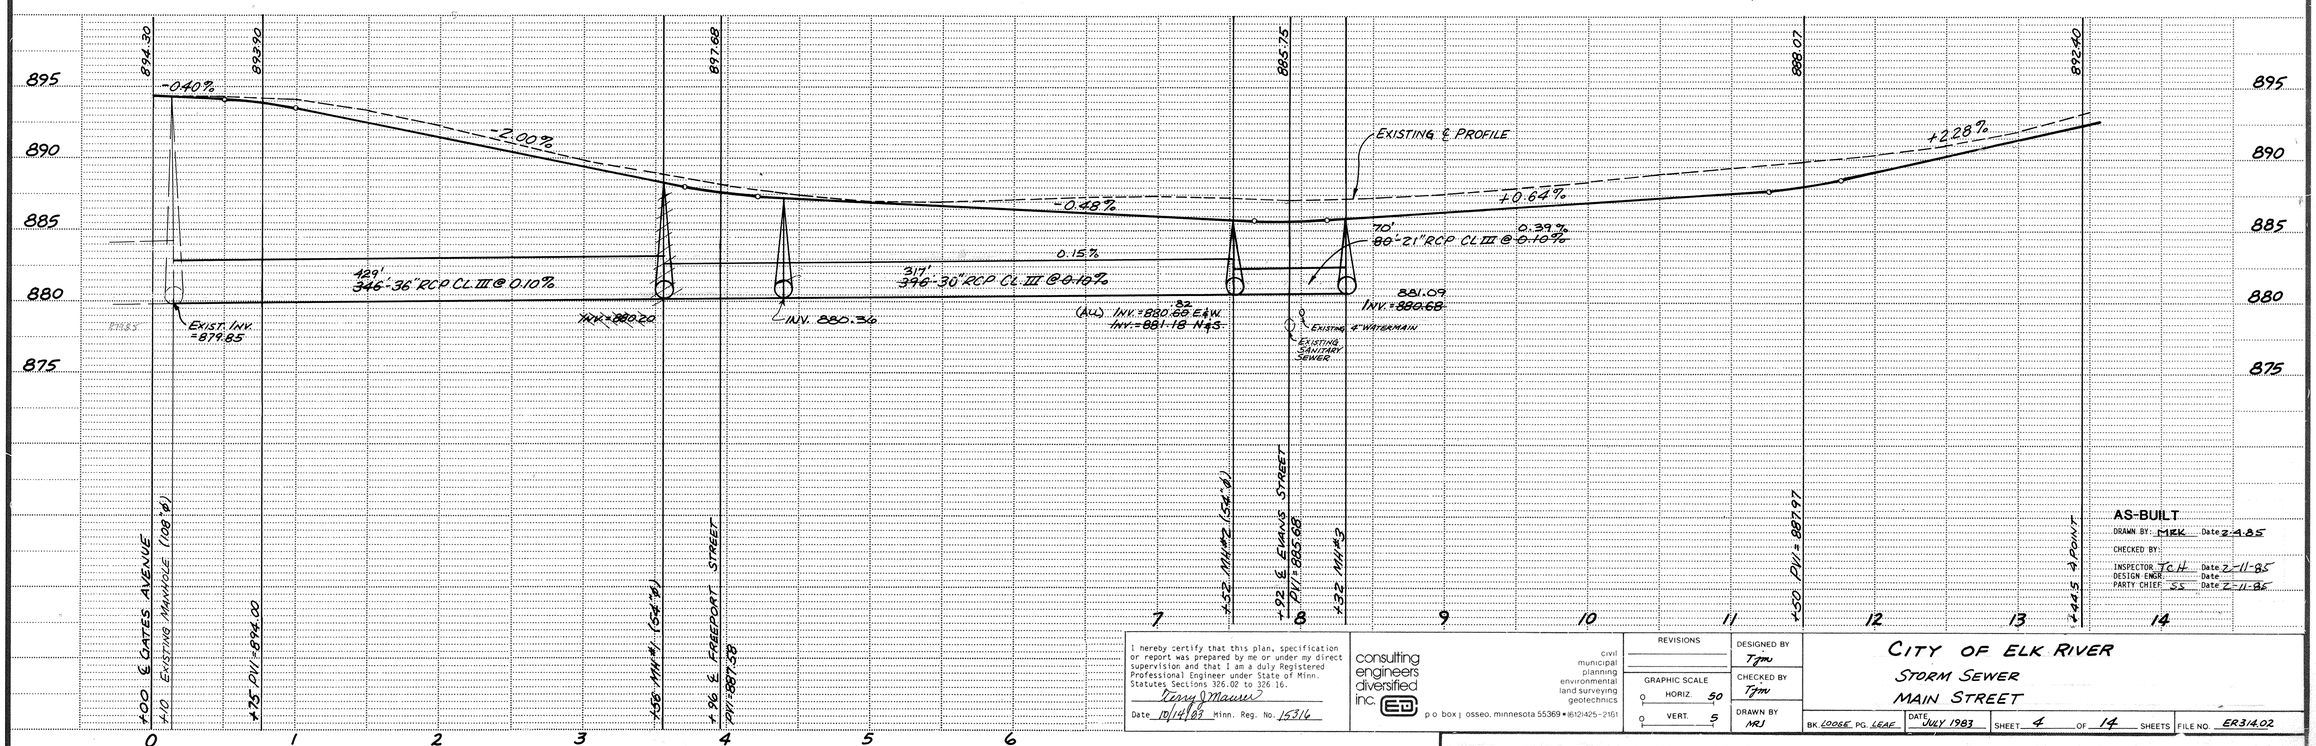

I hereby certify that this plan, specification or report was prepared by me or under my direct supervision and that I am a duly Registered Professional Engineer under State of Minn. Statutes Sections 326.02 to 326.16.

Date 10/14/83 Minn. Reg. No. 15316

consulting engineers diversified inc.
civil, municipal, planning, environmental, land surveying, geotechnics
p o box | osseo, minnesota 55369 • (612) 425-2161

REVISIONS

GRAPHIC SCALE: HORIZ. 50; VERT. 5

DESIGNED BY Tjm
CHECKED BY Tjm
DRAWN BY MRJ

CITY OF ELK RIVER
STORM SEWER
MAIN STREET

BK. LOOSE PG. LEAF | DATE JULY 1983 | SHEET 4 OF 14 SHEETS | FILE NO. ER314.02

STATE AID PROJECT NO. 204-113-01

108

DRAWING NUMBER
SAFCO PRODUCTS • NEW HOPE, MINNESOTA
REORDER BY PART NUMBER 65533

DRAWING NUMBER
SAFCO PRODUCTS • NEW HOPE, MINNESOTA
REORDER BY PART NUMBER 65533

DRAWING NUMBER
SAFCO PRODUCTS • NEW HOPE, MINNESOTA
REORDER BY PART NUMBER 65533

DRAWING NUMBER MAINS.83 4
SAFCO PRODUCTS • NEW HOPE, MINNESOTA
REORDER BY PART NUMBER 65533