Fed. Proj. No.

MAIN STREET

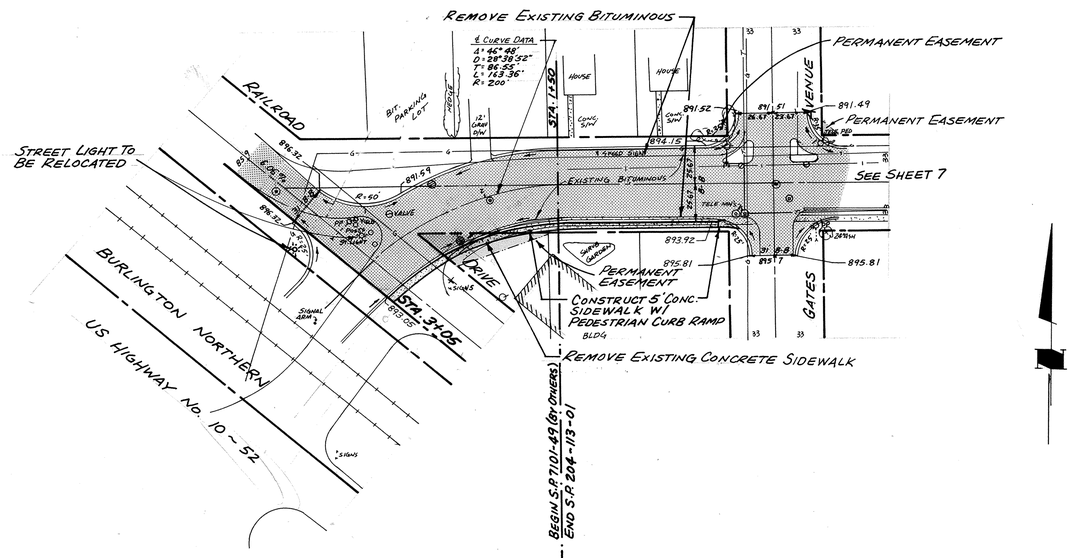

AS-BUILT
DRAWN BY: MRK Date 2-4-85
CHECKED BY:
INSPECTOR TLH Date 2-11-85
DESIGN ENGR. Date
PARTY CHIEF SS Date 2-11-85

I hereby certify that this plan, specification or report was prepared by me or under my direct supervision and that I am a duly Registered Professional Engineer under State of Minn. Statutes Sections 326.02 to 326.16.
Terry J. Mauer
Date 11/14/85 Minn. Reg. No. 15316

consulting engineers diversified inc.
civil
municipal
planning
environmental
land surveying
geotechnics
p o box j osseo, minnesota 55369 • (612)425-2151

REVISIONS

GRAPHIC SCALE
HORIZ. 0 50
VERT. 0 5

DESIGNED BY TJM
CHECKED BY TJM
DRAWN BY MRJ

CITY OF ELK RIVER
STREET GRADES
MAIN STREET

BK. LOOSE PG. LEAF | DATE JULY 1983 | SHEET 5 OF 14 SHEETS | FILE NO. ER 314.02

STATE AID PROJ. NO. 204-113-01

107

DRAWING NUMBER

DRAWING NUMBER
MAINS 83
5

SAFCO PRODUCTS • NEW HOPE, MINNESOTA
REORDER BY PART NUMBER 6563