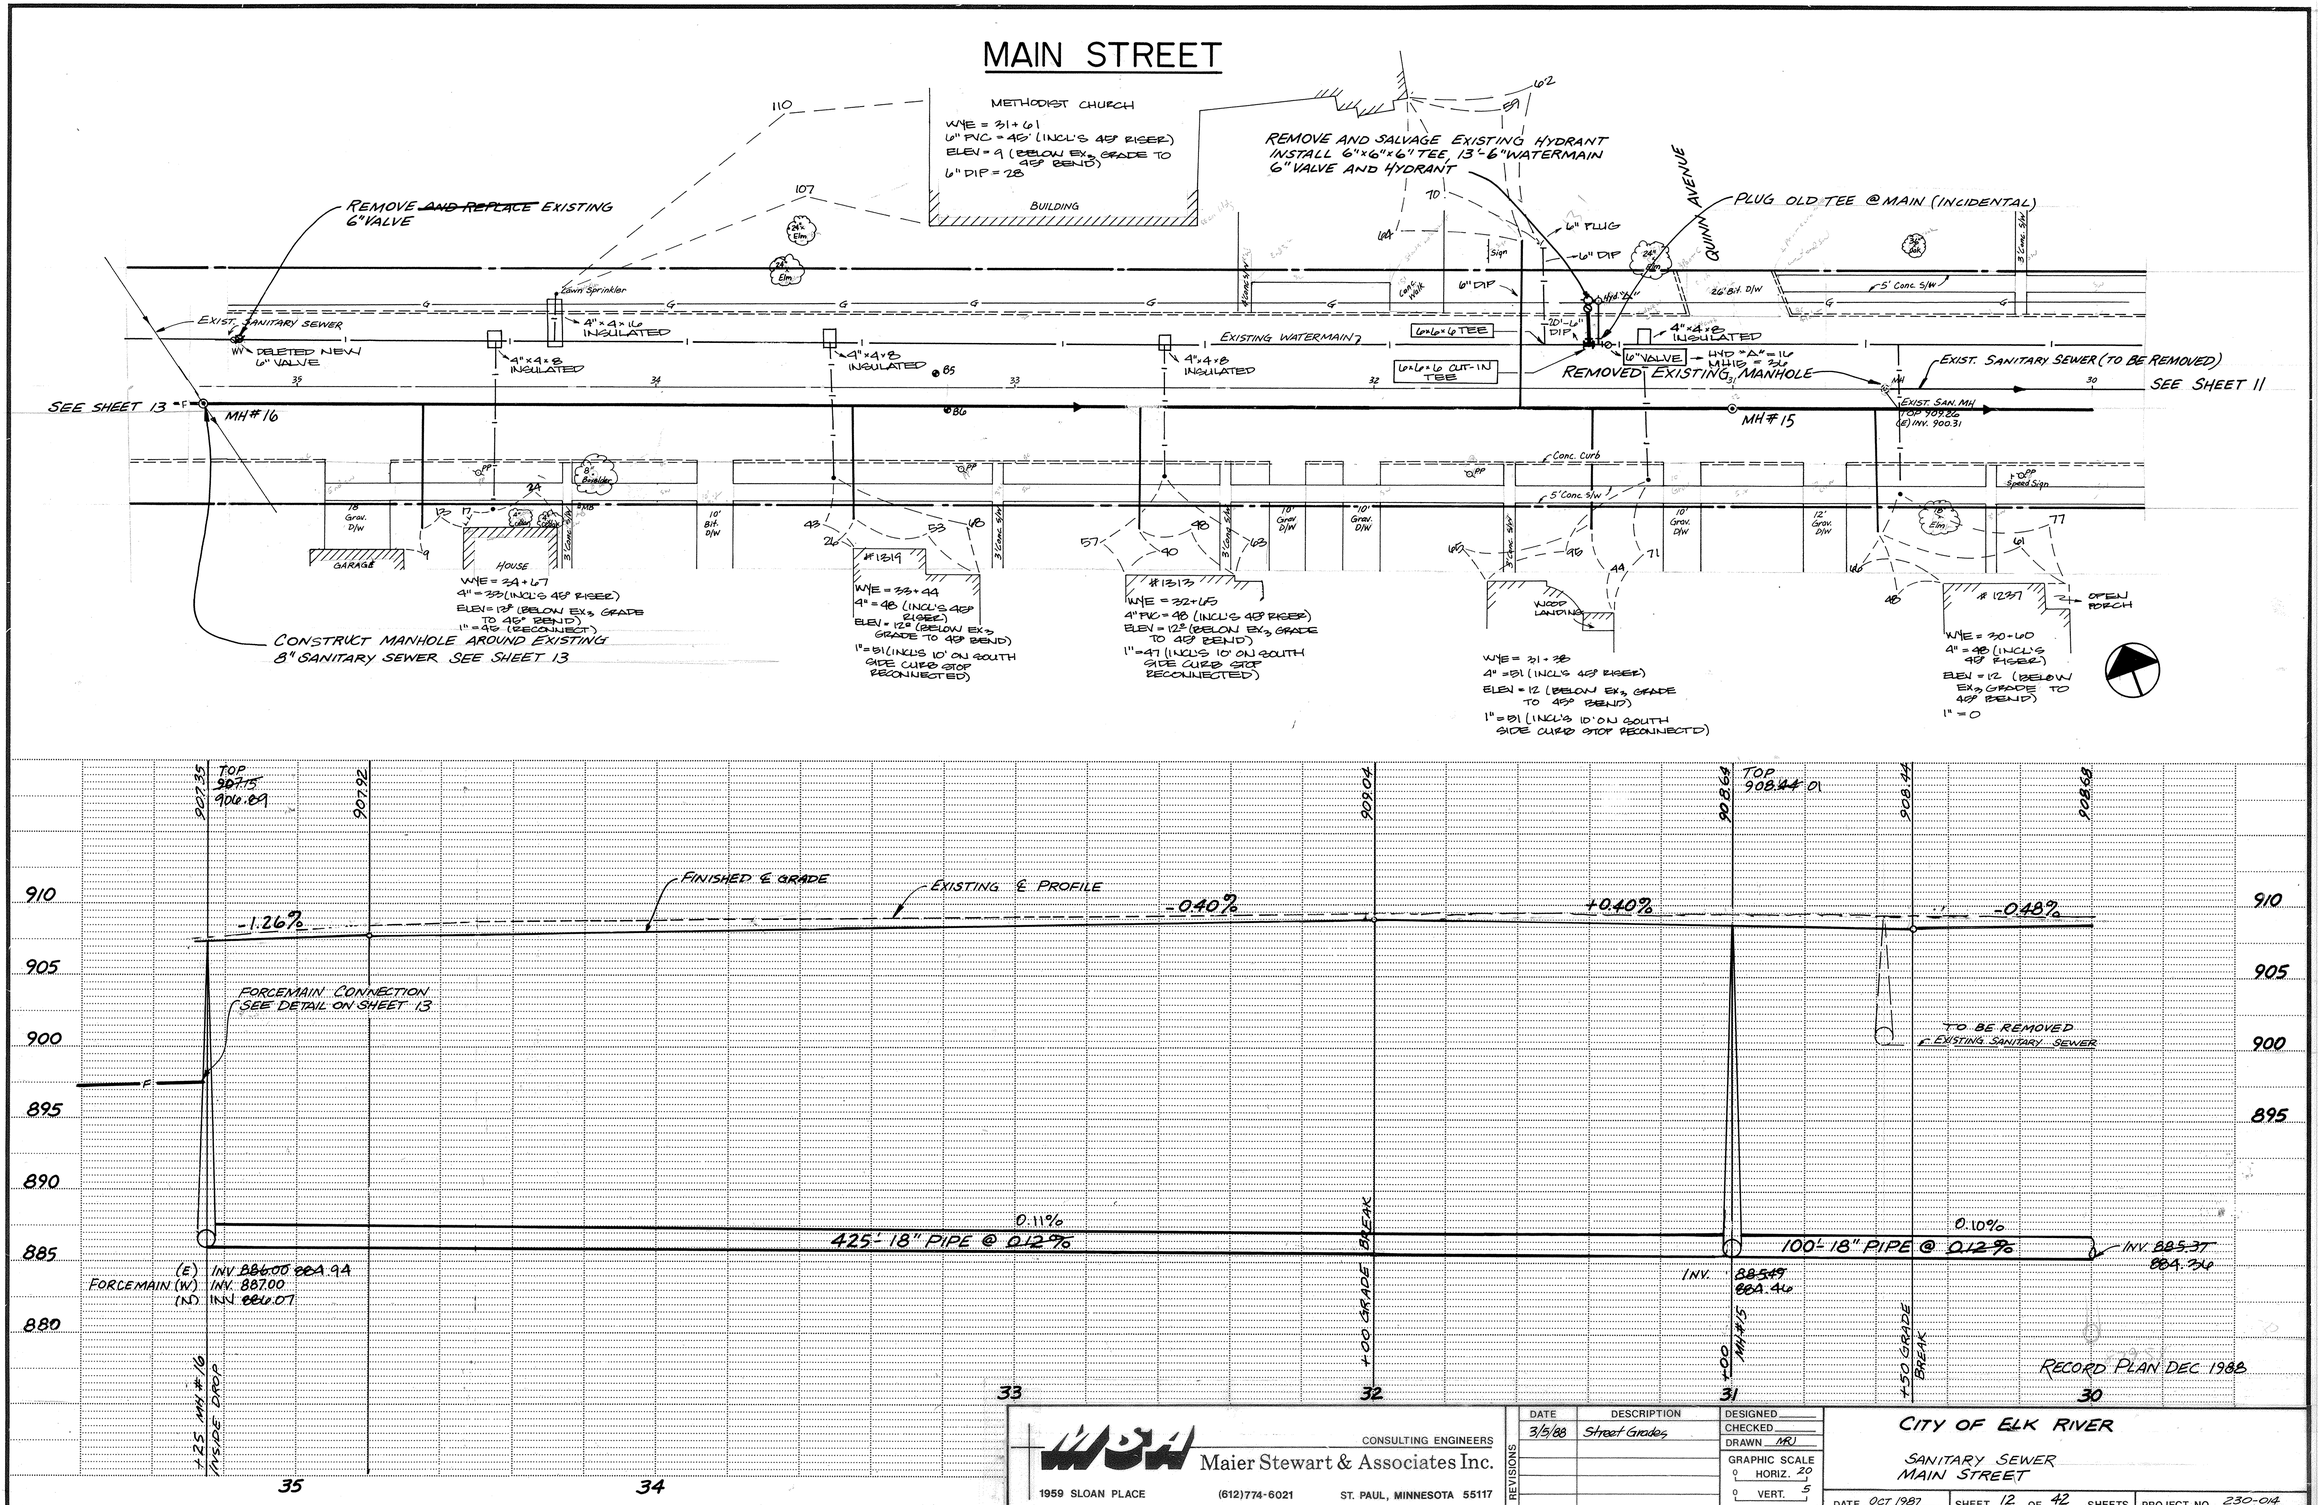

MSA CONSULTING ENGINEERS Maier Stewart & Associates Inc. 1959 SLOAN PLACE (612)774-6021 ST. PAUL, MINNESOTA 55117	REVISIONS: DATE 3/5/88 DESCRIPTION Street Grades	DESIGNED CHECKED DRAWN MRJ GRAPHIC SCALE 0 HORIZ. 20 0 VERT. 5	CITY OF ELK RIVER SANITARY SEWER MAIN STREET DATE OCT 1987 SHEET 12 OF 42 SHEETS PROJECT NO. 230-014

263

DRAWING NUMBER

DRAWING NUMBER

DRAWING NUMBER

DRAWING NUMBER
MAINS.87
12