
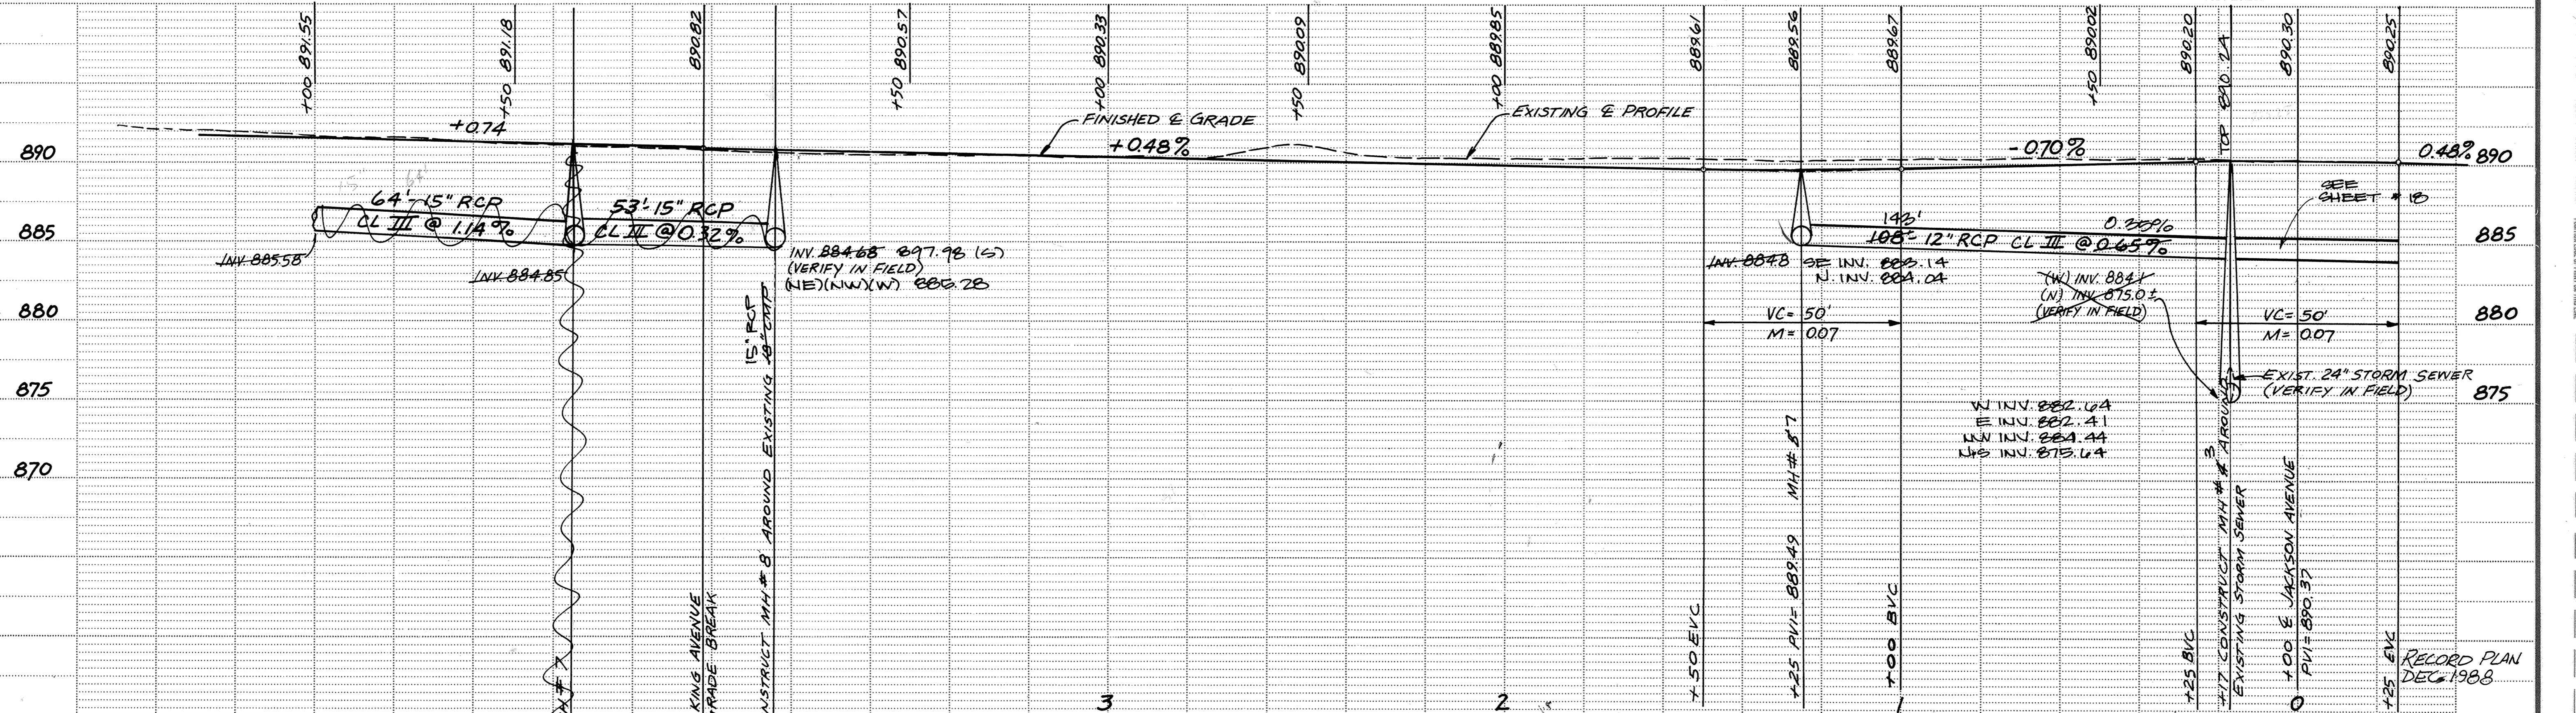


MAIN STREET

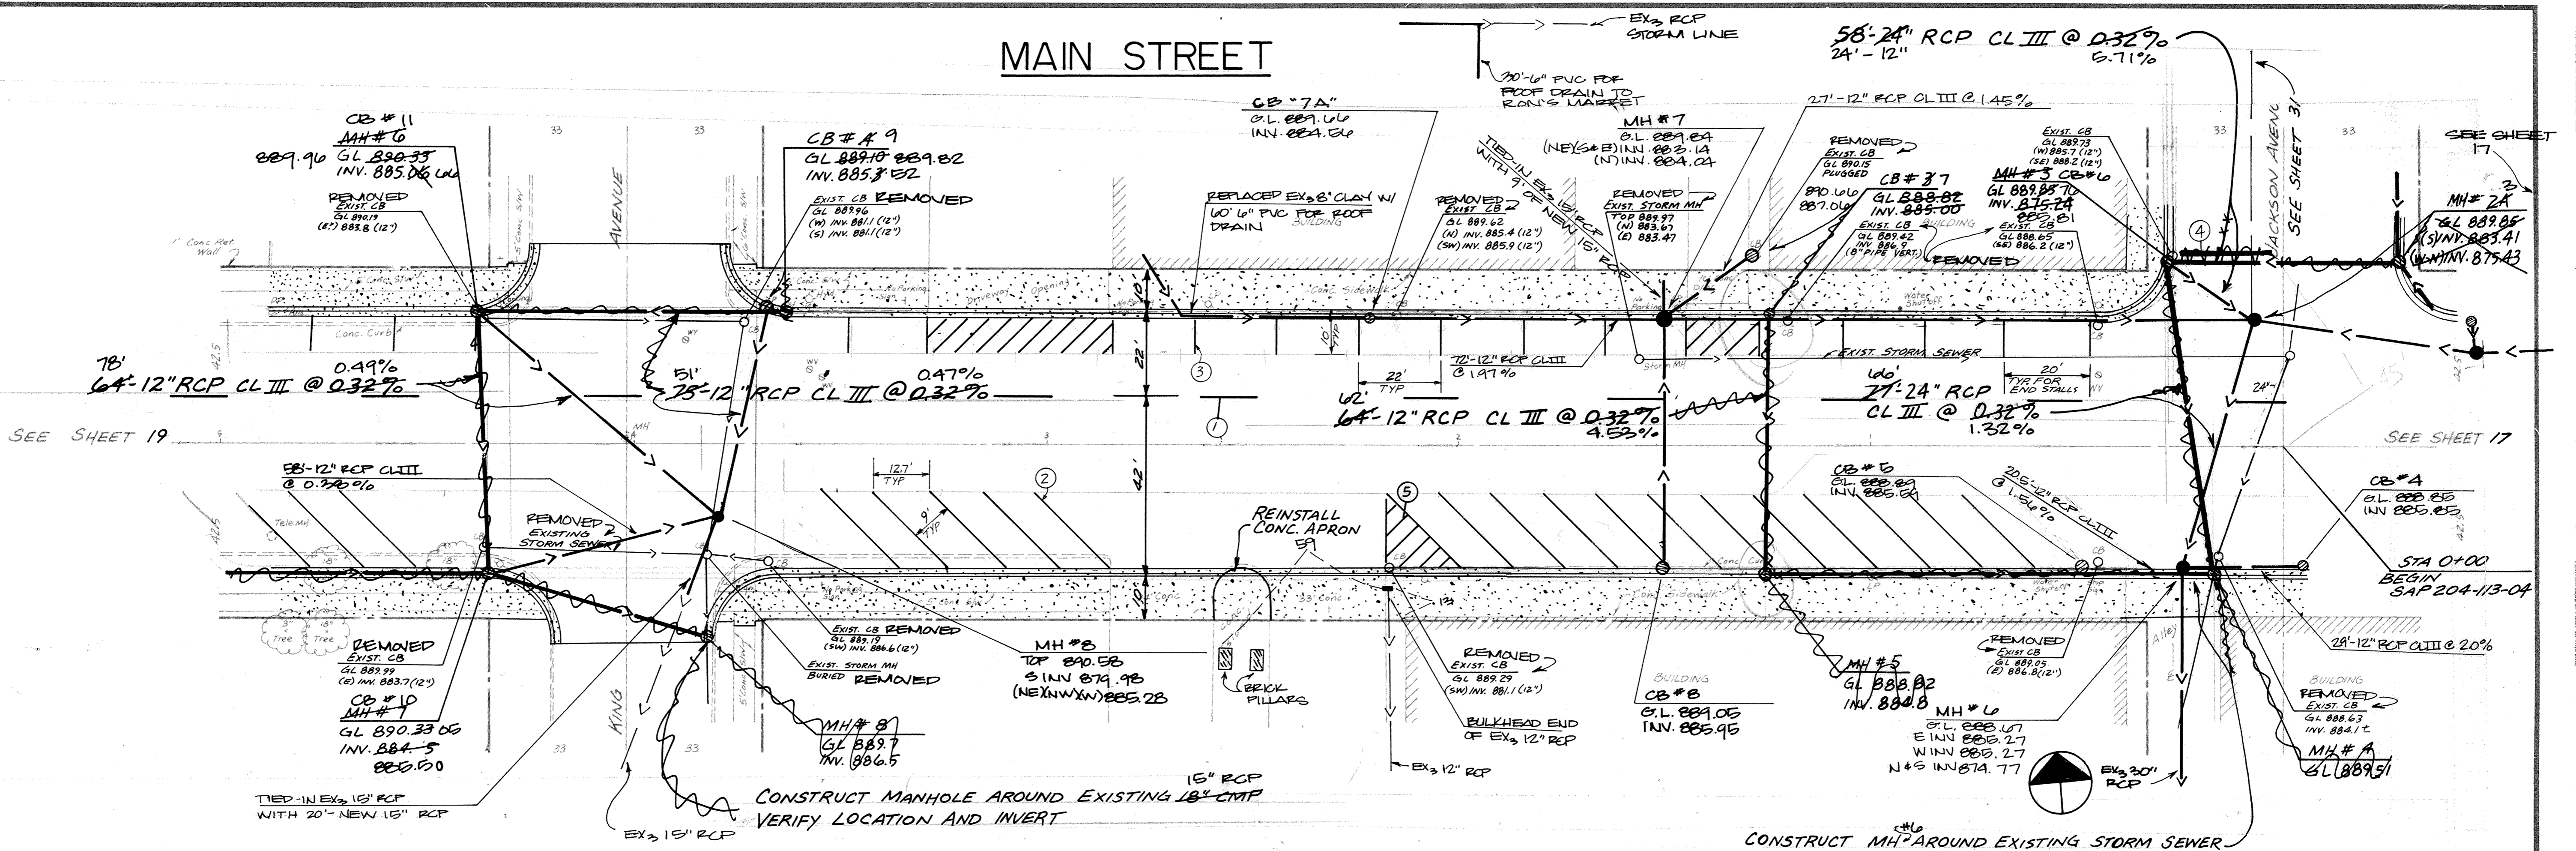

M/S/A
 CONSULTING ENGINEERS
Maier Stewart & Associates Inc.
 1959 SLOAN PLACE (612)774-6021 ST. PAUL, MINNESOTA 55117

REVISIONS	DATE	DESCRIPTION	DESIGNED	CHECKED	DRAWN	CITY OF ELK RIVER
						STREET CONSTRUCTION MAIN STREET
						DATE OCT 1987 SHEET 13 OF 42 SHEETS PROJECT NO. 230-04

SAP 204-113-04 257

DRAWING NUMBER
 MAINS 87
