
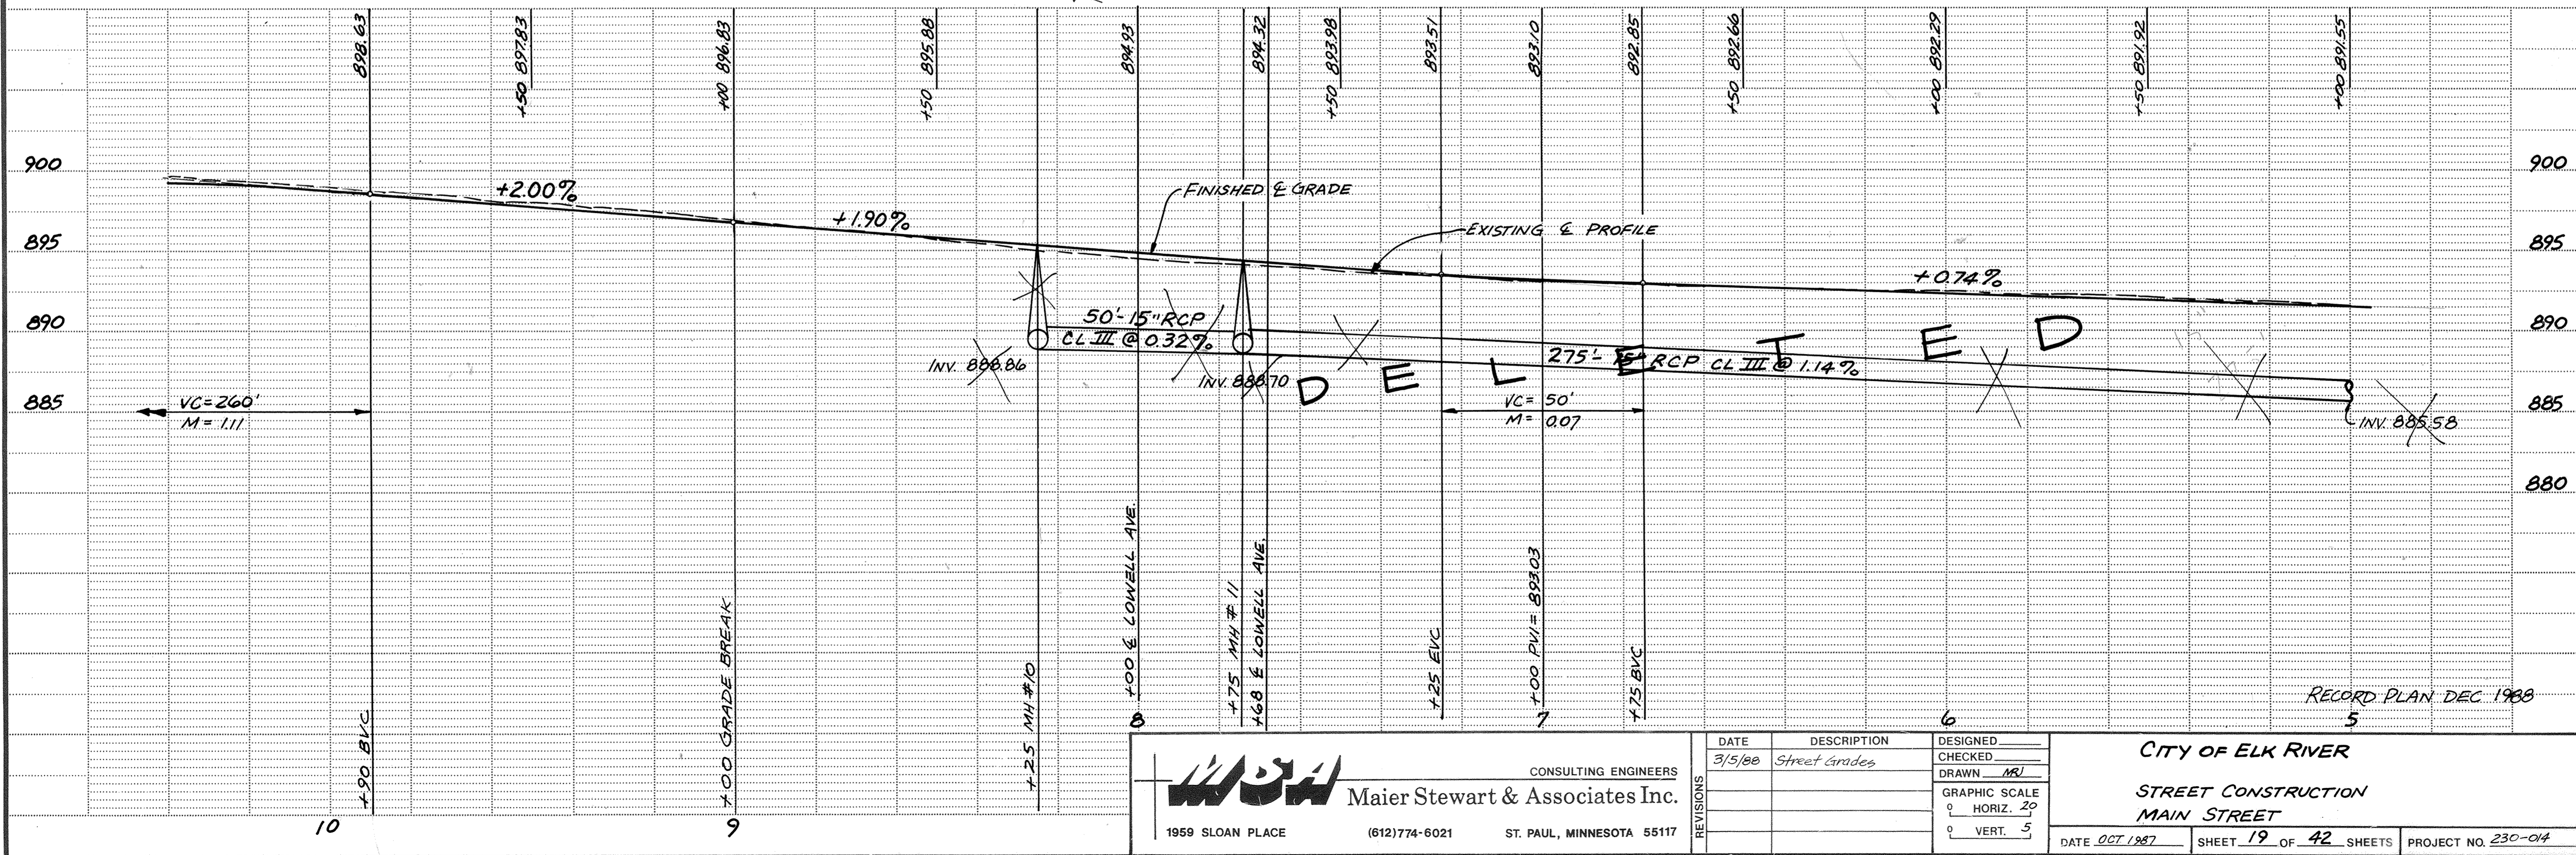


# MAIN STREET

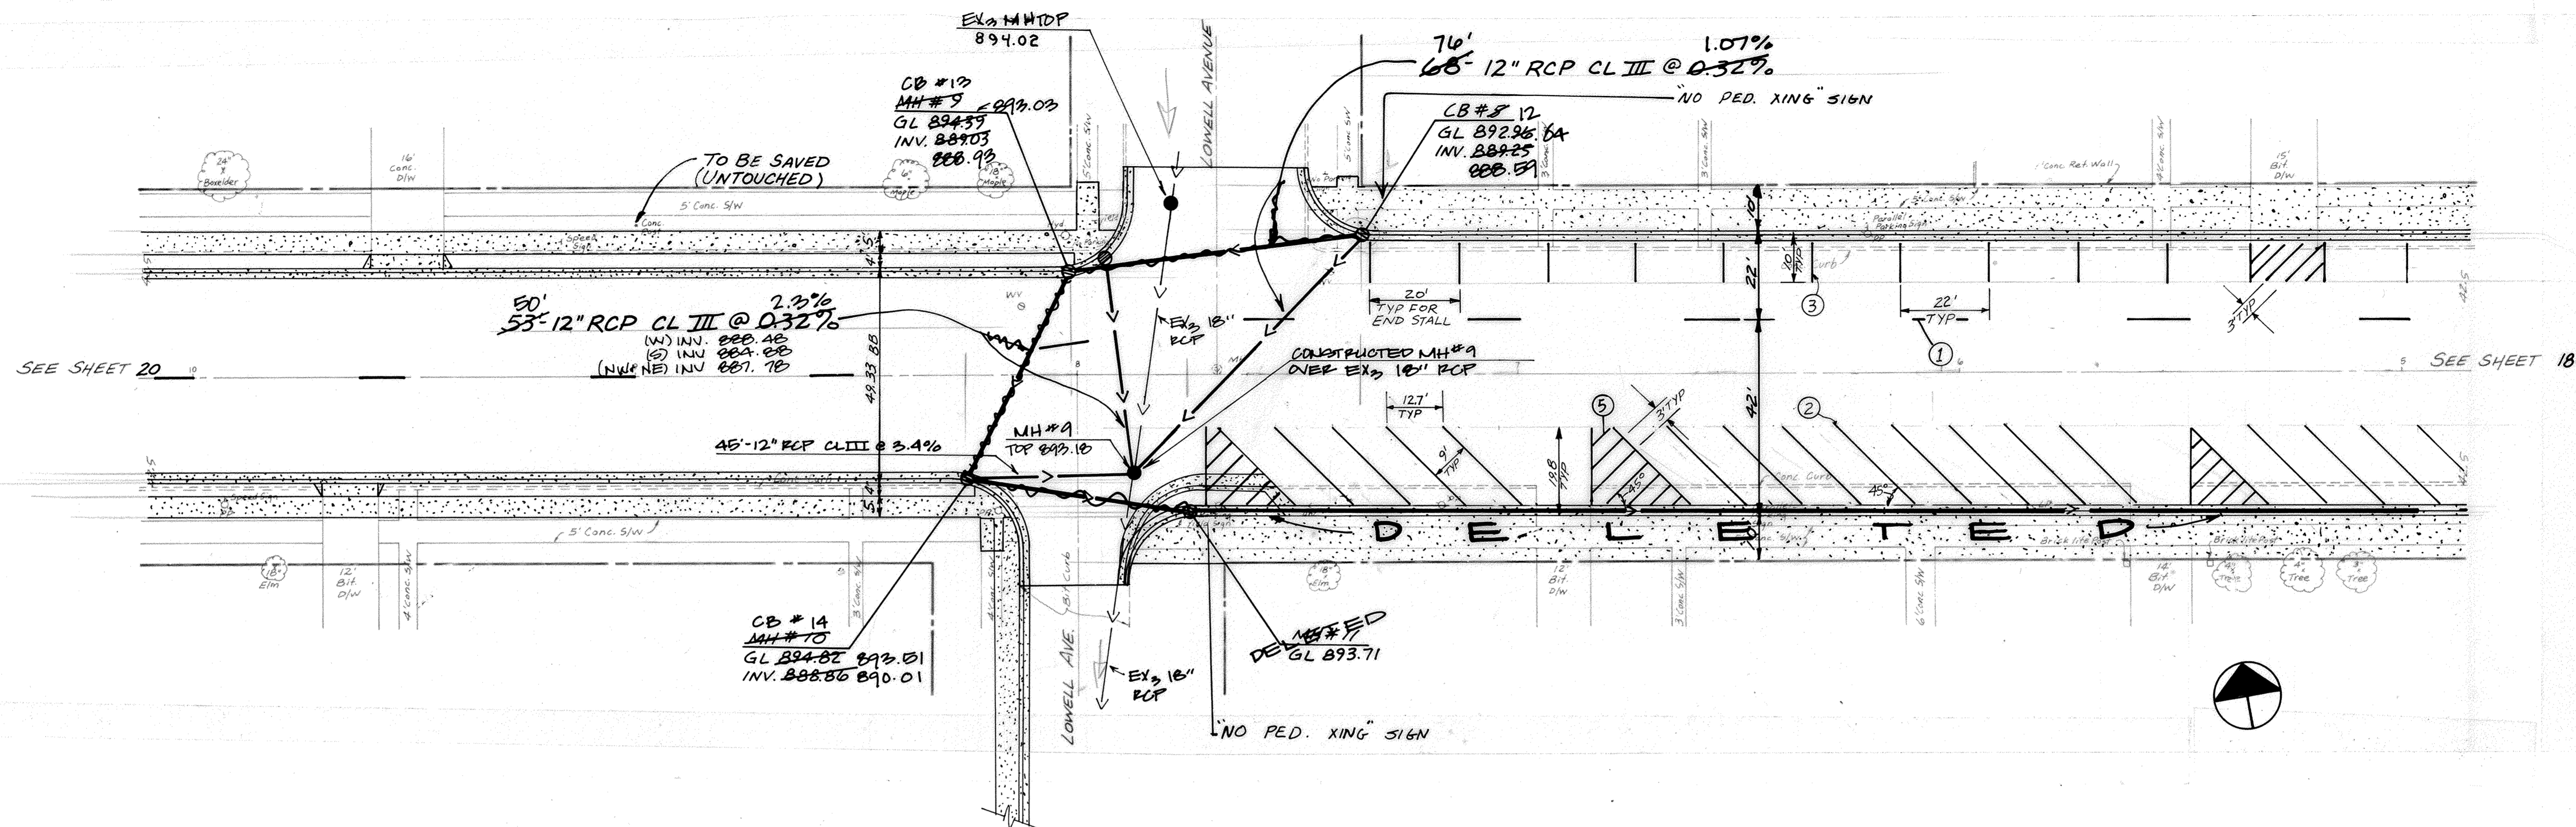

**Maier Stewart & Associates Inc.**  
CONSULTING ENGINEERS  
1959 SLOAN PLACE (612)774-6021 ST. PAUL, MINNESOTA 55117

REVISIONS	DATE	DESCRIPTION
	3/5/88	Street Grades

DESIGNED	_____
CHECKED	_____
DRAWN	MRJ
GRAPHIC SCALE	_____
0 HORIZ. 20	
0 VERT. 5	

**CITY OF ELK RIVER**

**STREET CONSTRUCTION**

**MAIN STREET**

DATE OCT 1987 SHEET 19 OF 42 SHEETS PROJECT NO. 230-014

1170 PVI

DRAWING NUMBER MAINS 87 19