
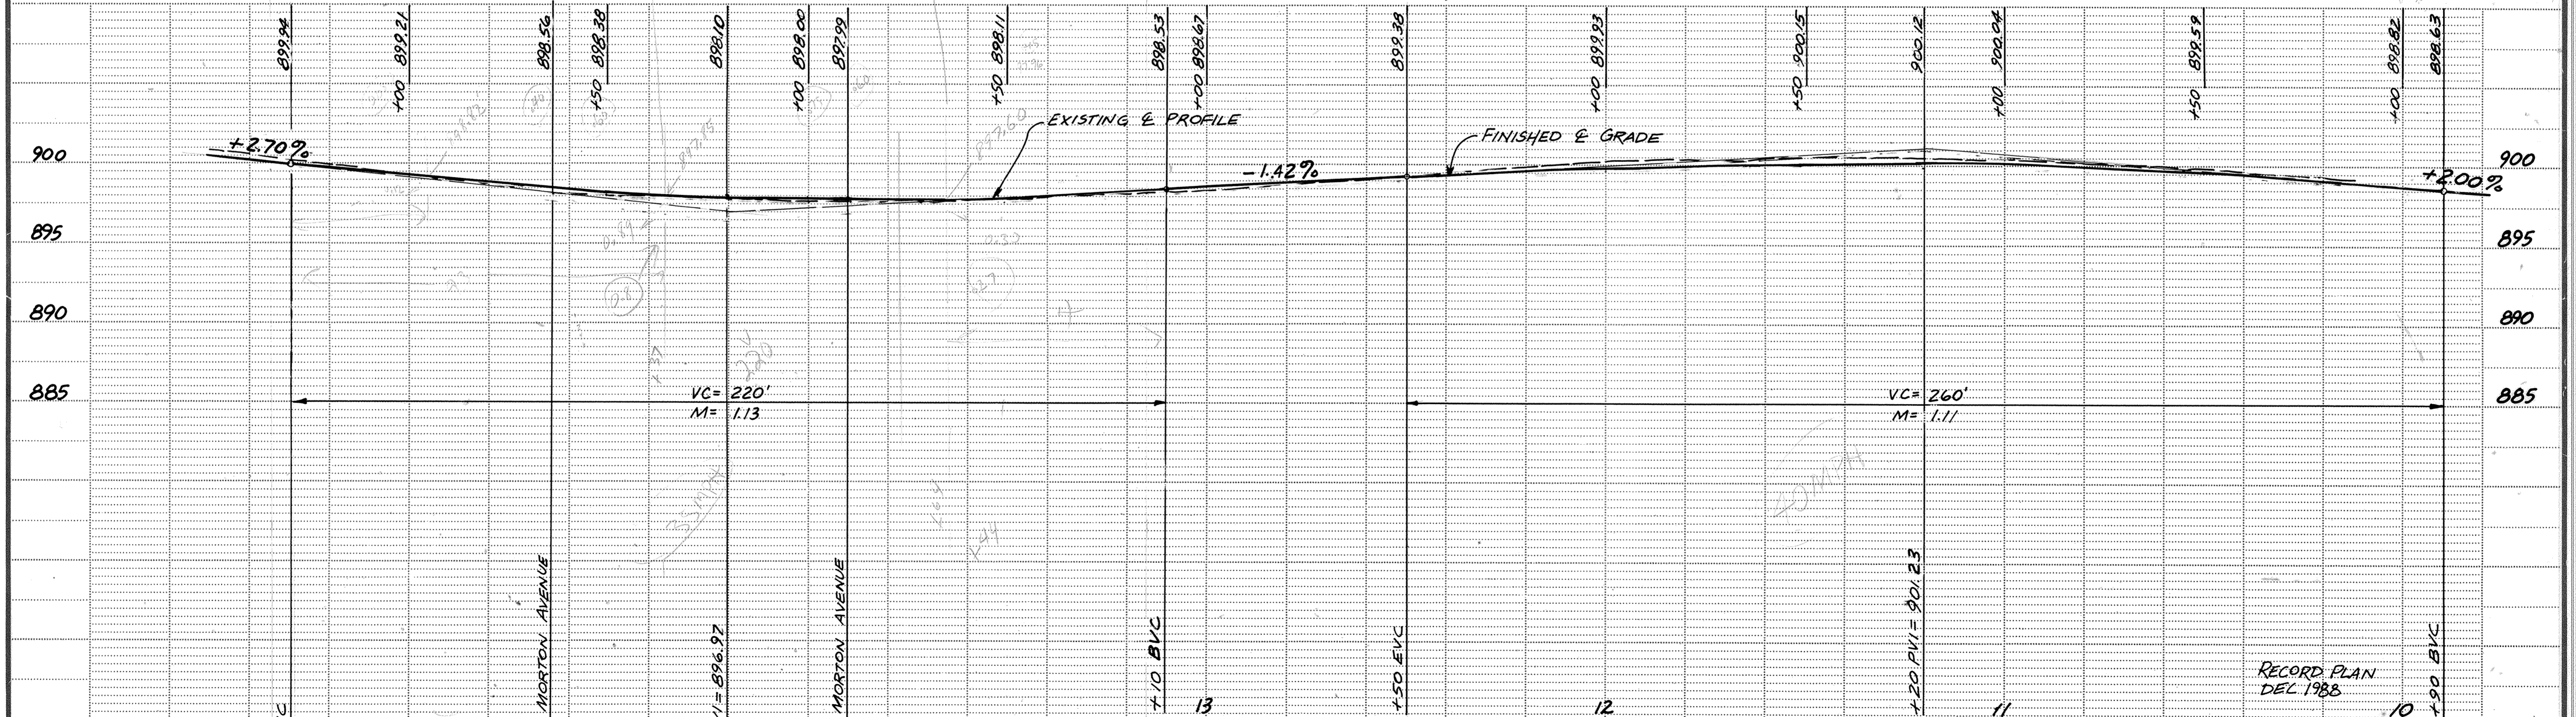


MAIN STREET

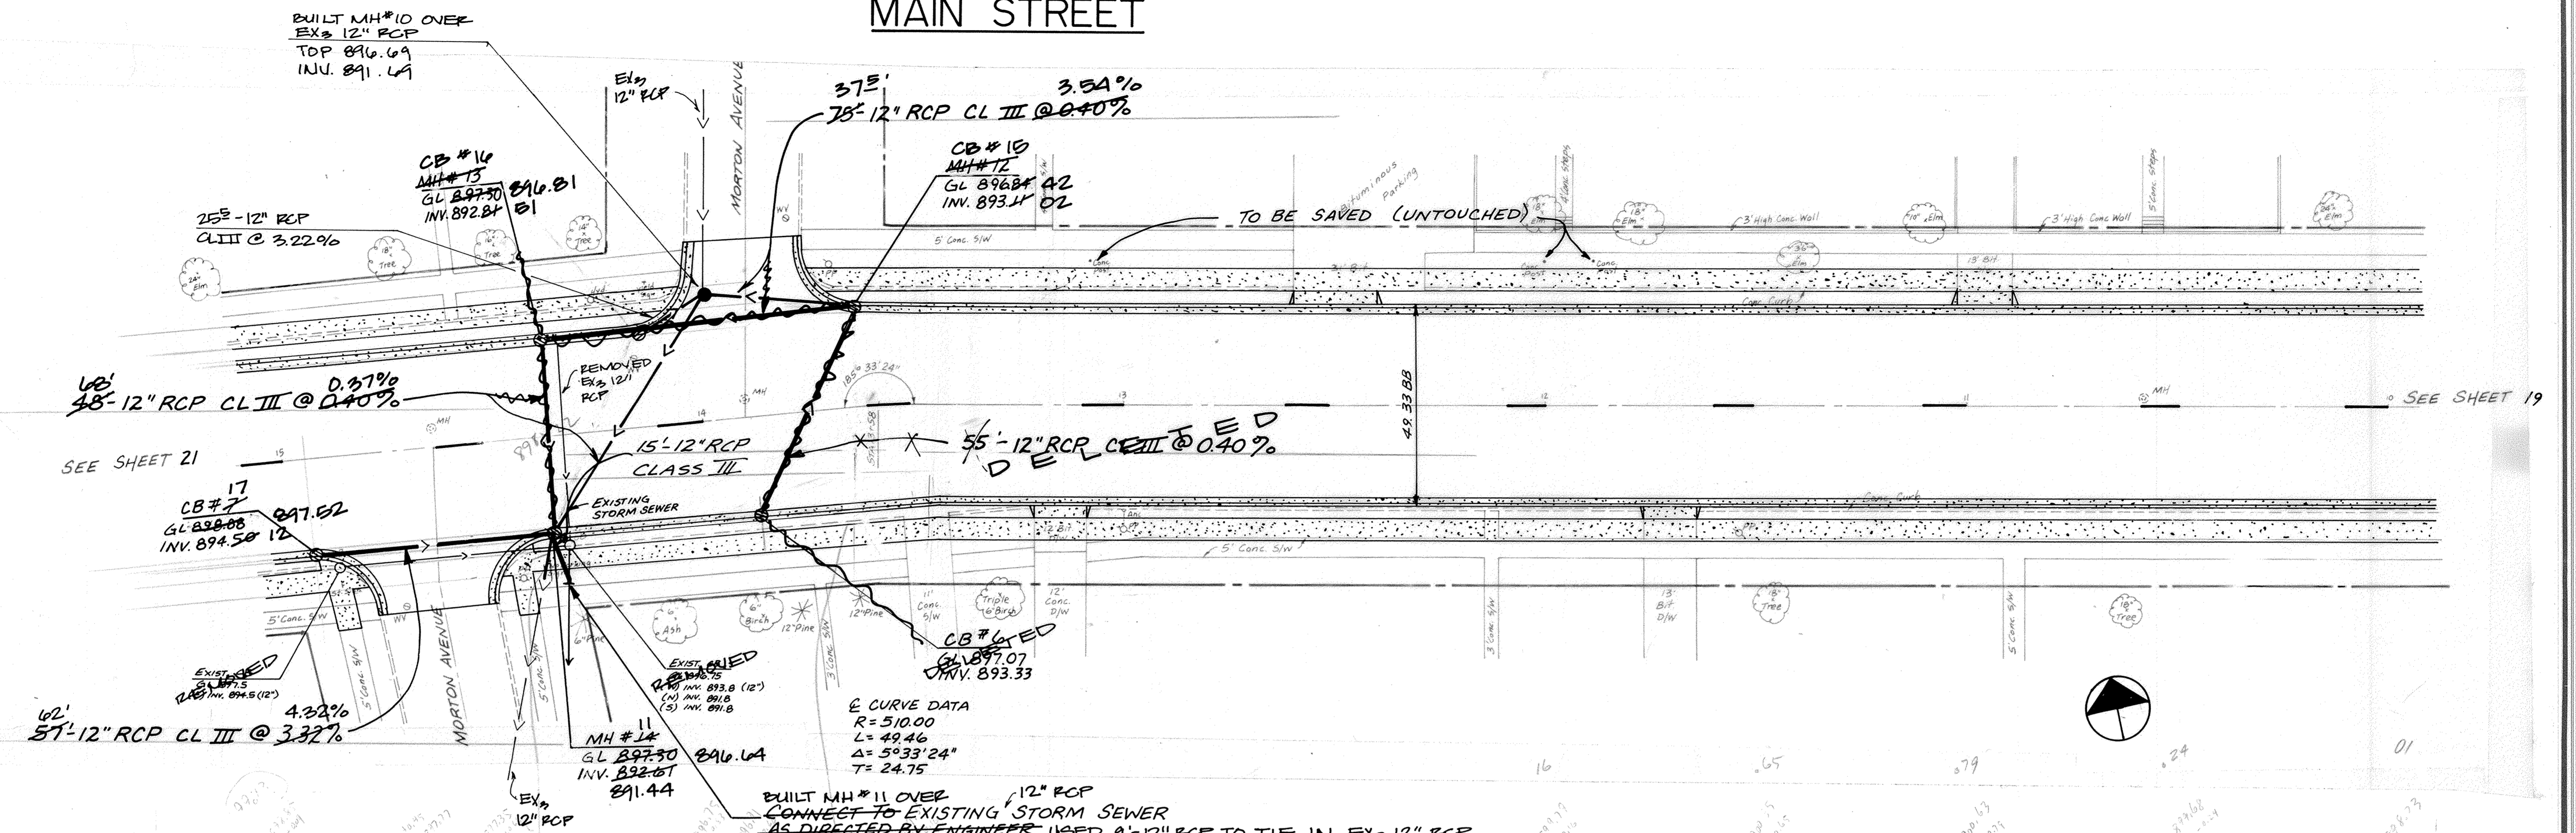

Maier Stewart & Associates Inc.
CONSULTING ENGINEERS
1959 SLOAN PLACE (612)774-6021 ST. PAUL, MINNESOTA 55117

DATE	DESCRIPTION	DESIGNED
3/5/88	Street Grades	CHECKED
		DRAWN <i>MR</i>
		GRAPHIC SCALE
		0 HORIZ. 20
		0 VERT. 5

CITY OF ELK RIVER

STREET CONSTRUCTION

MAIN STREET

DATE OCT 1987 SHEET 20 OF 42 SHEETS PROJECT NO. 230-04