MAIN STREET

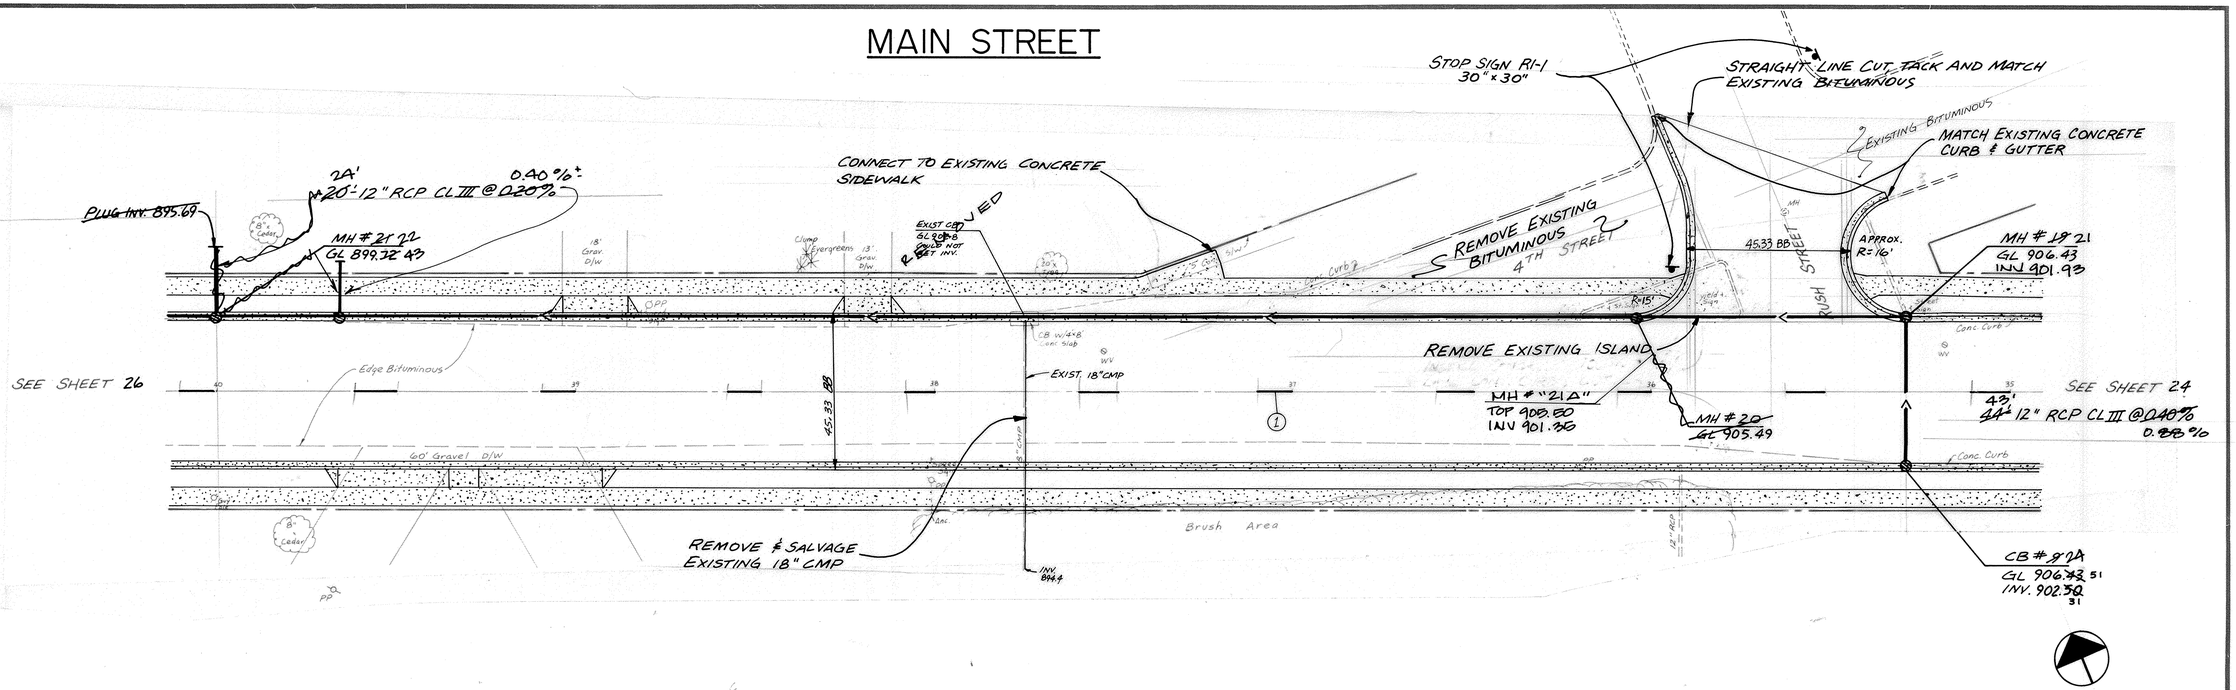

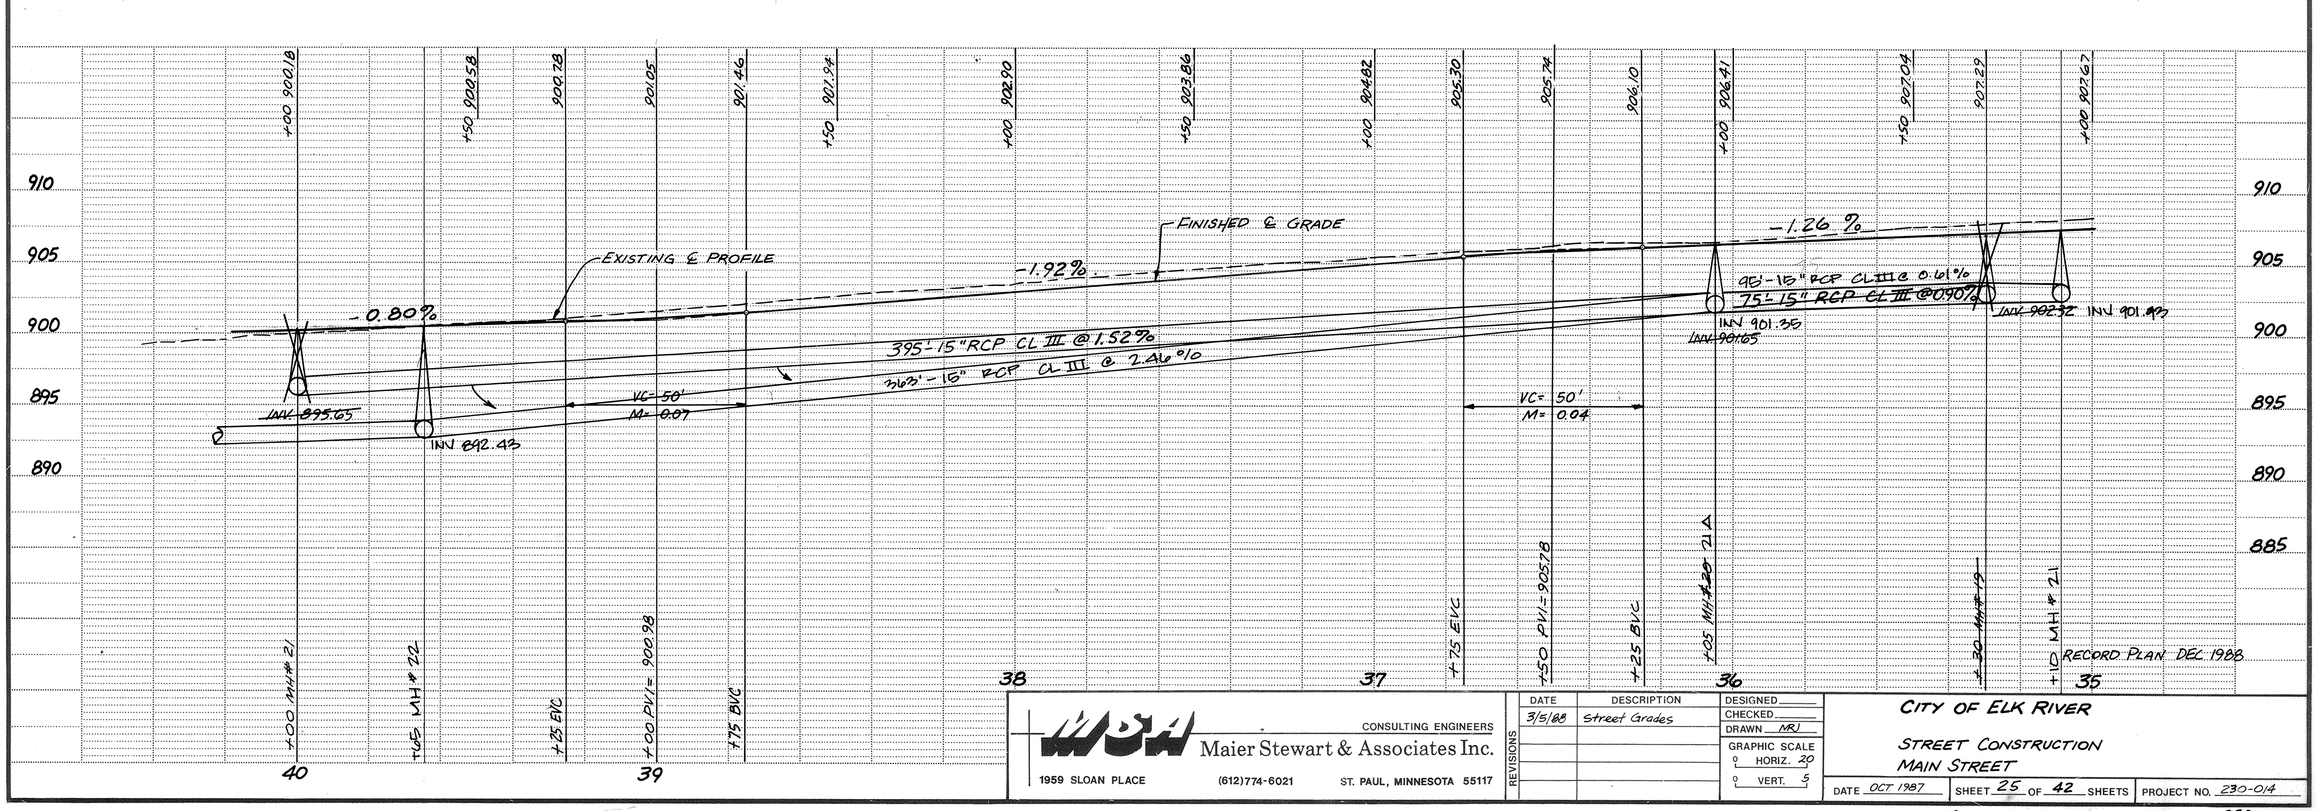

MSA Maier Stewart & Associates Inc. CONSULTING ENGINEERS	CITY OF ELK RIVER	
1959 SLOAN PLACE (612)774-6021 ST. PAUL, MINNESOTA 55117	STREET CONSTRUCTION MAIN STREET	
REVISIONS: DATE 3/5/88 — DESCRIPTION Street Grades	DESIGNED / CHECKED / DRAWN MRJ / GRAPHIC SCALE HORIZ. 20 VERT. 5	DATE OCT 1987 — SHEET 25 OF 42 SHEETS — PROJECT NO. 230-014

SAP 204-113-04

250

DRAWING NUMBER

DRAWING NUMBER

DRAWING NUMBER
MAINS.87
25