



SAICO PRODUCTS • NEW HOPE, MINNESOTA
REPORT BY PART NUMBER 852
SAICO PRODUCTS • NEW HOPE, MINNESOTA
REPORT BY PART NUMBER 852
SAICO PRODUCTS • NEW HOPE, MINNESOTA
REPORT BY PART NUMBER 852
SAICO PRODUCTS • NEW HOPE, MINNESOTA
REPORT BY PART NUMBER 852

MAIN STREET

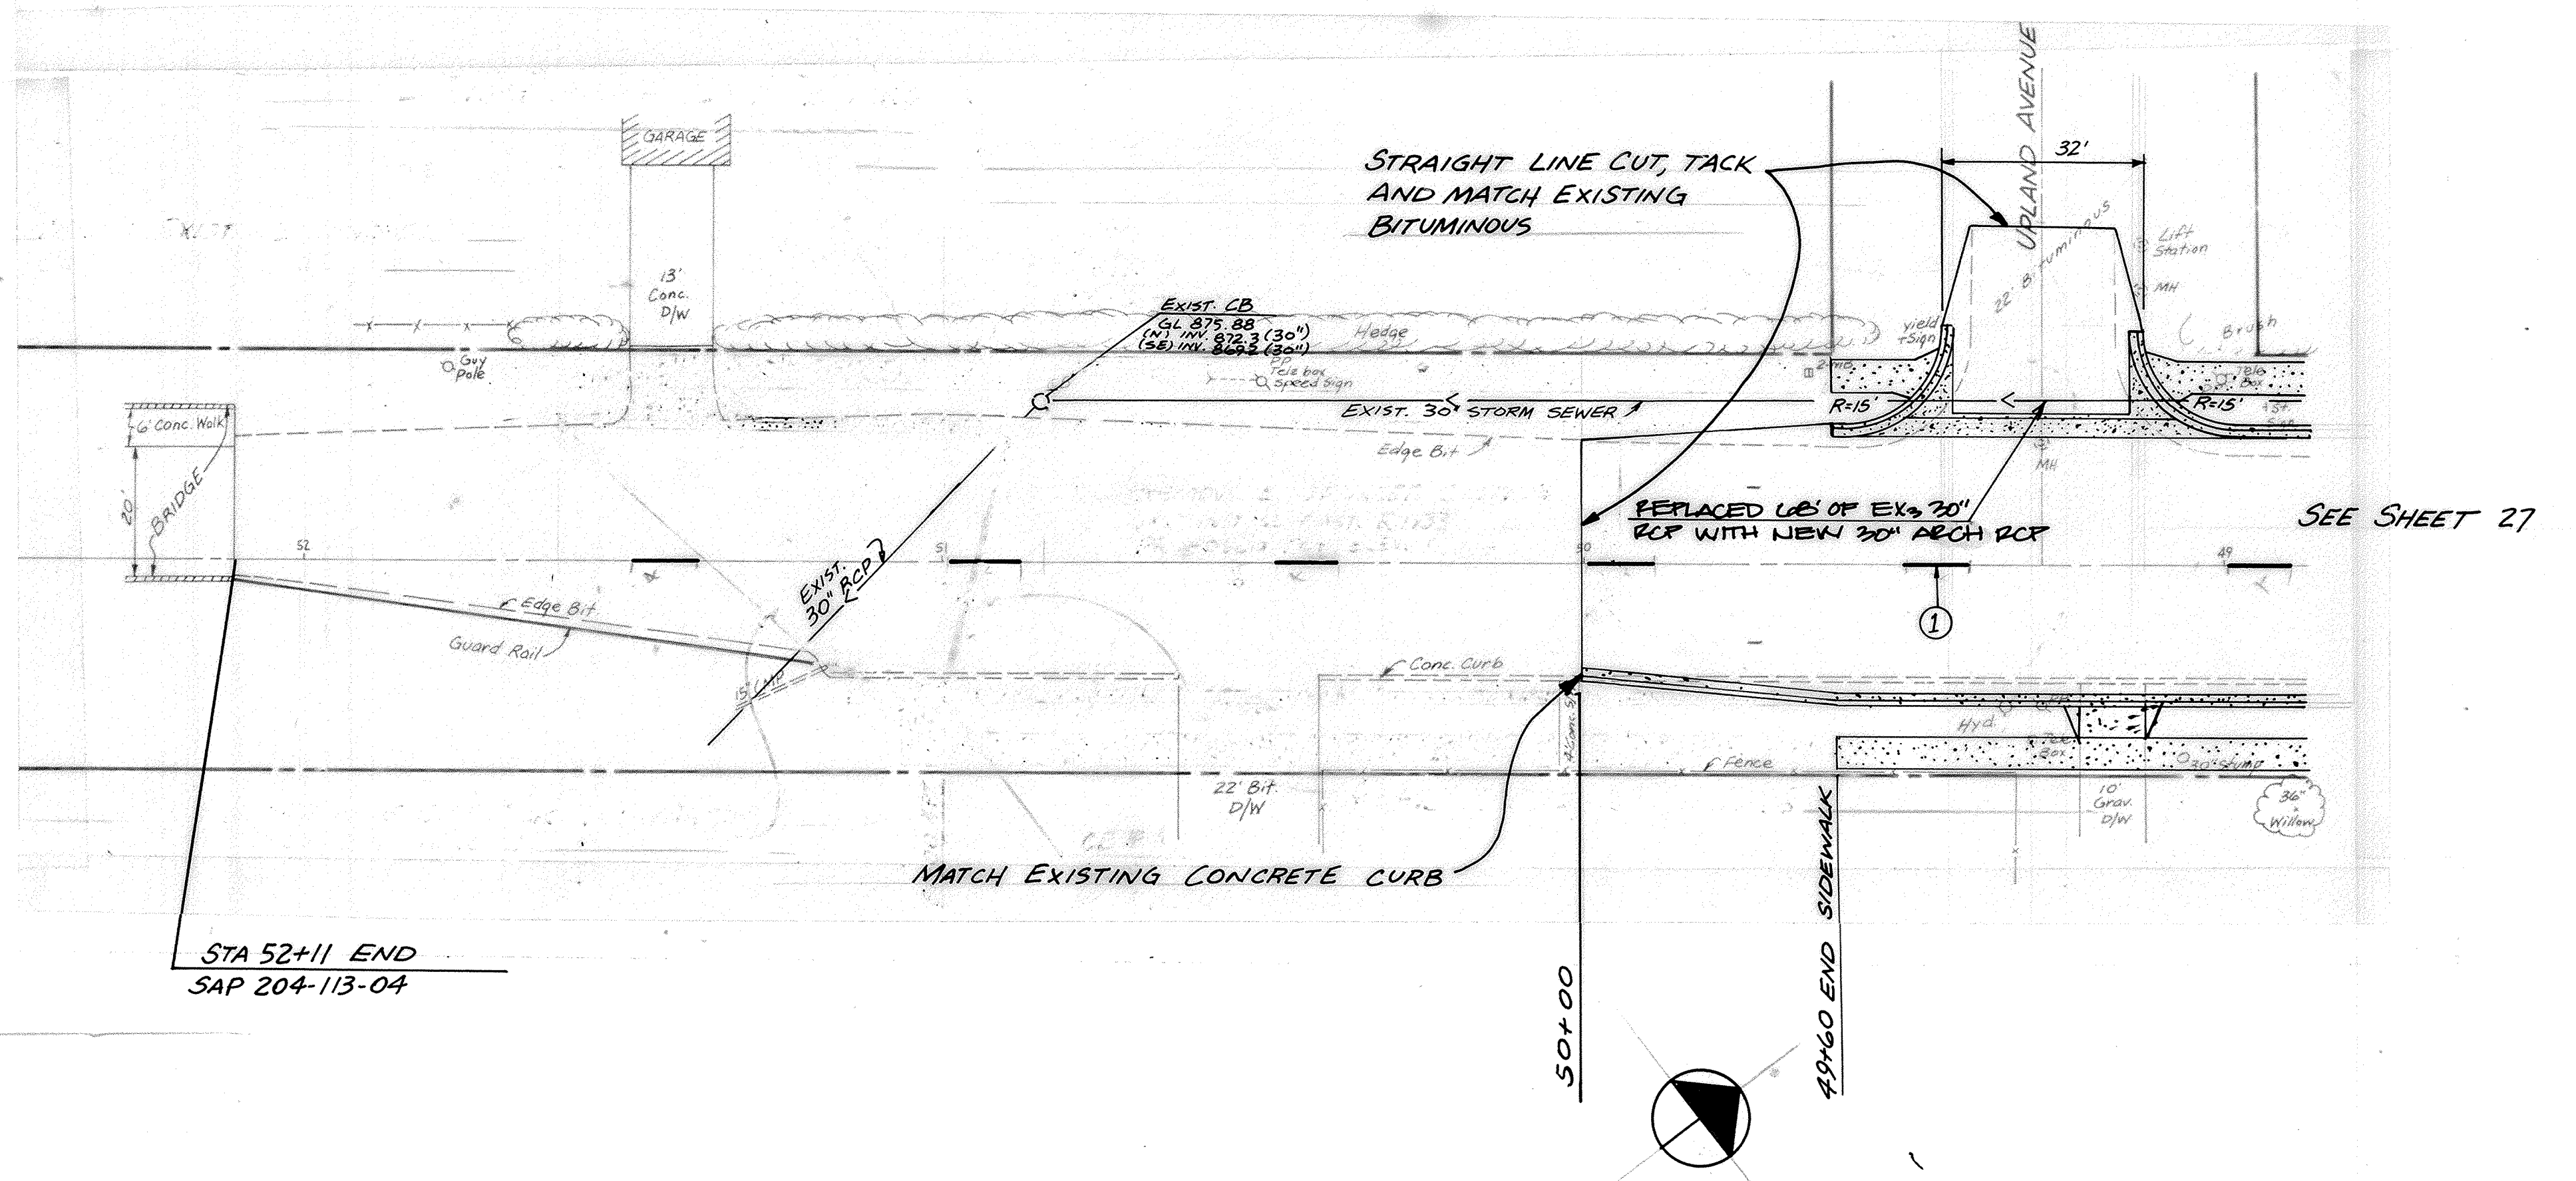

ADDITIONAL SIGN QUANTITIES SEE SHEET 2	
ITEM	QUANTITY
STOP SIGN (R-1)	10
SCHOOL CROSSING SIGN (S2-1)	4
SCHOOL SPEED SIGN (S4-3)	2
SCHOOL SPEED SIGN (S4-2)	2
20 MPH SPEED SIGN (R2-1)	2
SCHOOL ADVANCE SIGN (S1-1)	1
NO PARKING 8:00 AM to 5:00 PM SCHOOL DAYS ONLY	6
SCHOOL BUS LOADING AREA (S3-2)	2
NO PEDESTRIAN CROSSING	2

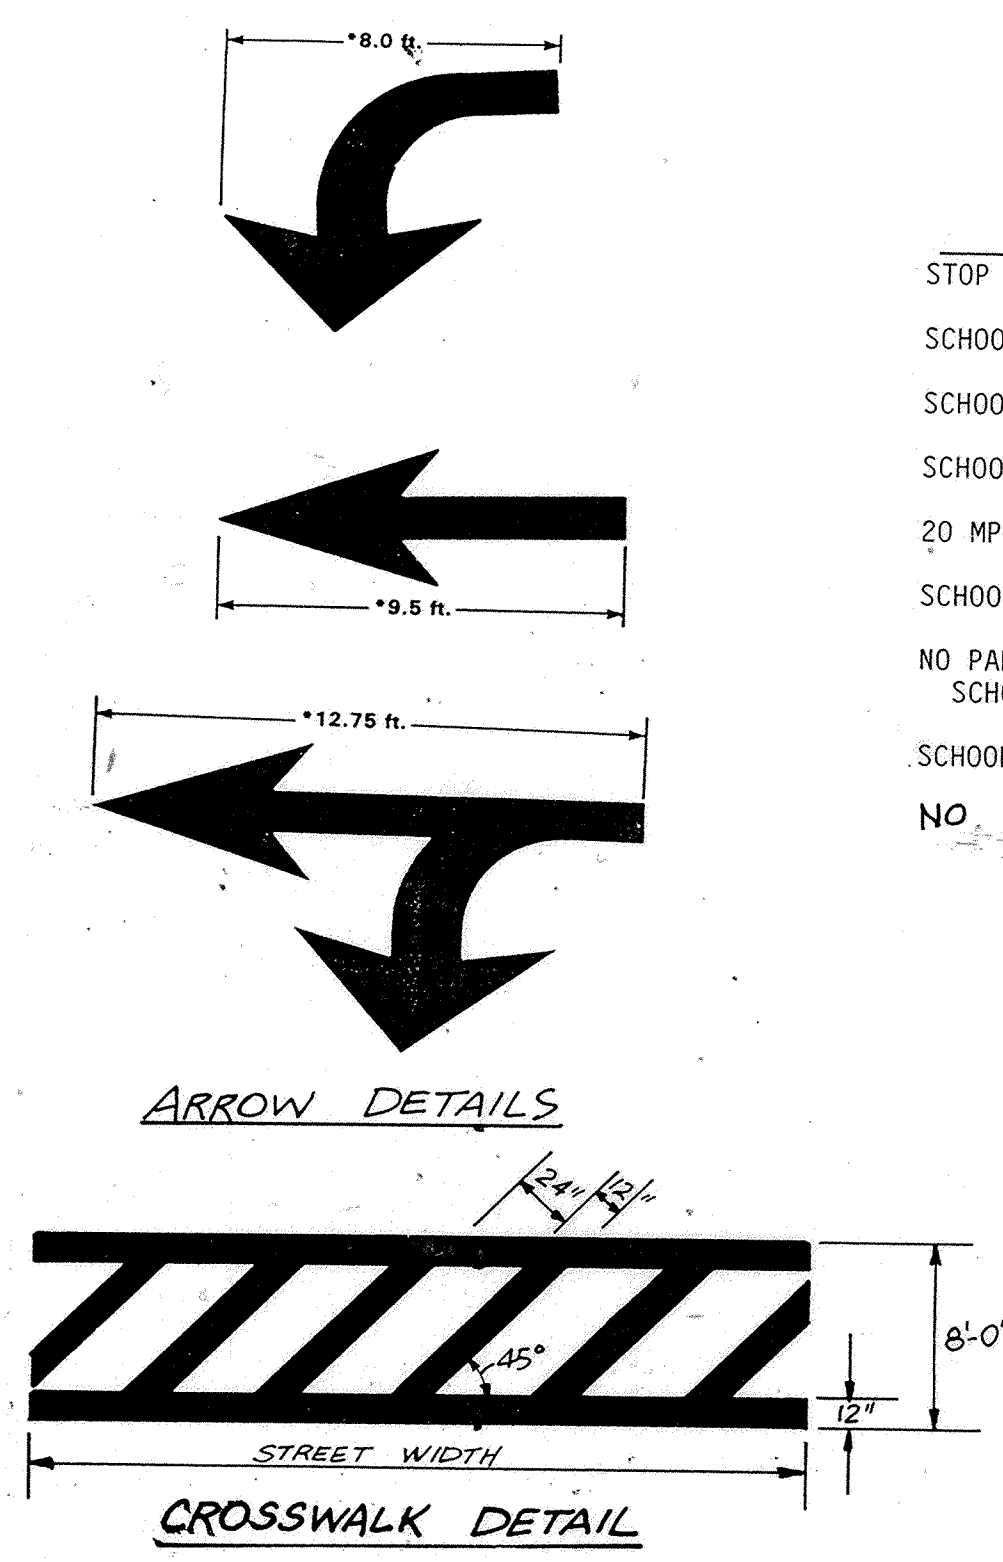

HANDICAP SYMBOL, 4 REQ'D
LOCATION AS PER ENGINEER



CONSULTING ENGINEERS Maier Stewart & Associates Inc. 1959 SLOAN PLACE (612)774-6021 ST. PAUL, MINNESOTA 55117		DATE	DESCRIPTION	DESIGNED	CITY OF ELK RIVER STREET CONSTRUCTION MAIN STREET	
REVISIONS				CHECKED		
				DRAWN <i>MRJ</i>	DATE OCT 1987 SHEET 28 OF 42 SHEETS PROJECT NO. 230-014	
				GRAPHIC SCALE 0 HORIZ. 20' 0 VERT. 5'	SAP 204-113-04	