PROCTOR AVENUE

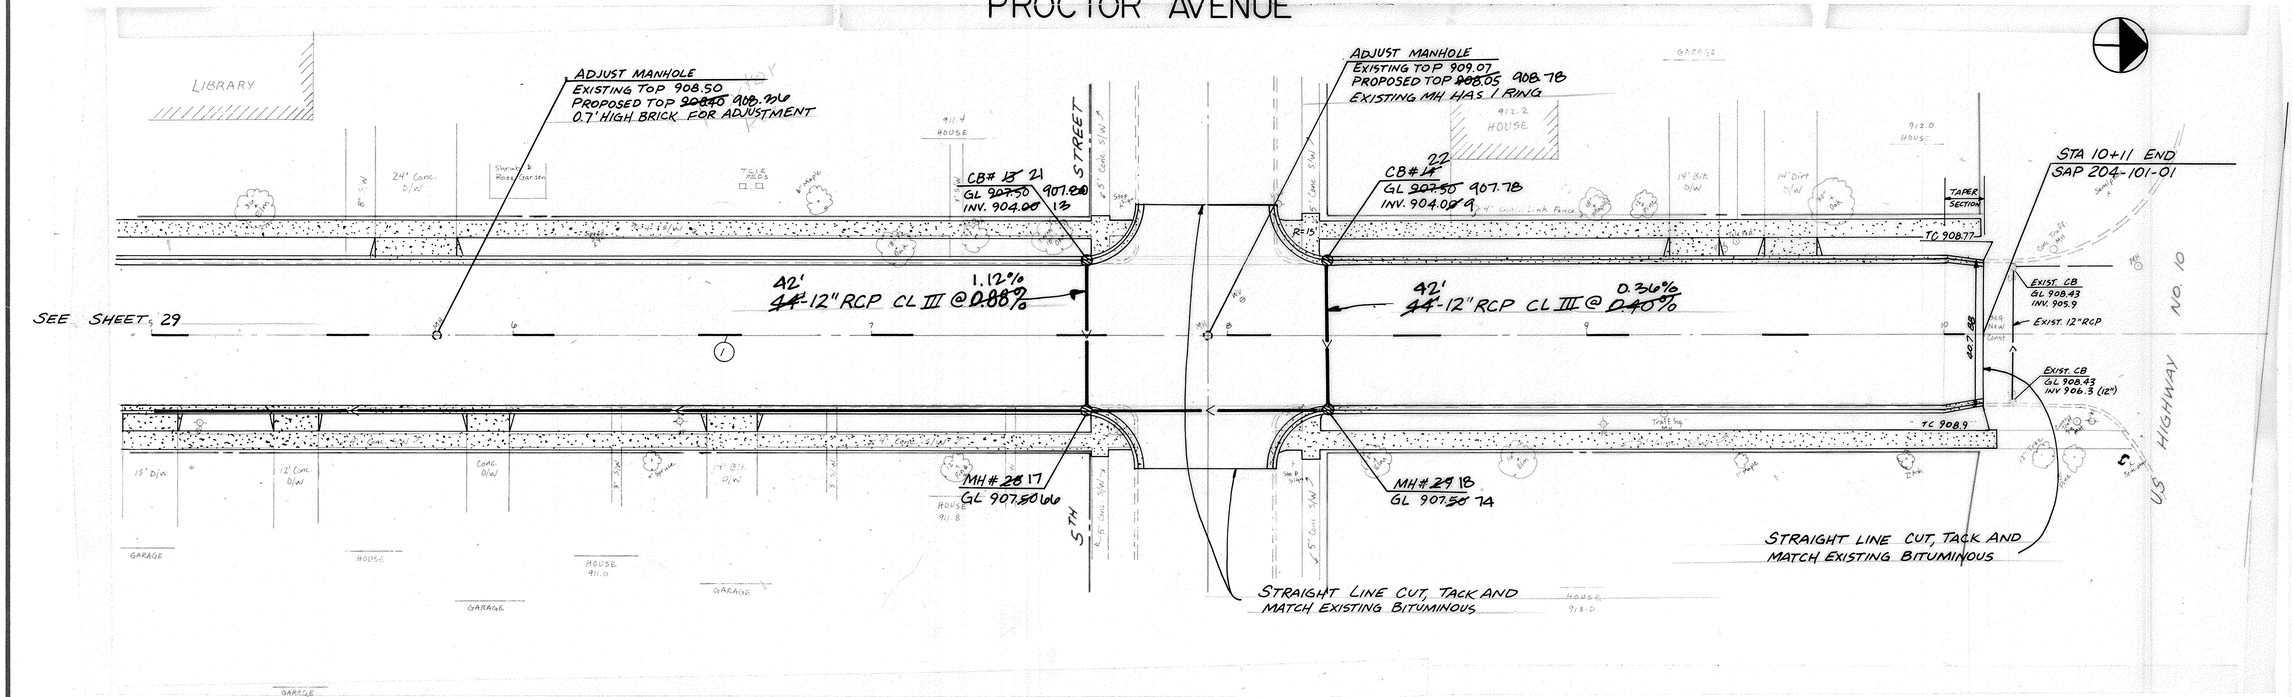

MSA Maier Stewart & Associates Inc. CONSULTING ENGINEERS 1959 SLOAN PLACE (612)774-6021 ST. PAUL, MINNESOTA 55117	REVISIONS: DATE 3/5/88 — DESCRIPTION Gutterline Elev.	DESIGNED / CHECKED / DRAWN MRJ / GRAPHIC SCALE HORIZ. 20 VERT. 5	CITY OF ELK RIVER — STREET CONSTRUCTION PROCTOR AVENUE — DATE NOV. 1987 — SHEET 30 OF 42 SHEETS — PROJECT NO. 230-014

SAP 204-101-01

DRAWING NUMBER
SUTCO PRODUCTS • NEW HOPE, MINNESOTA
PREPARER BY PART NUMBER 55422
DRAWING NUMBER
DRAWING NUMBER
MAINS.87
30