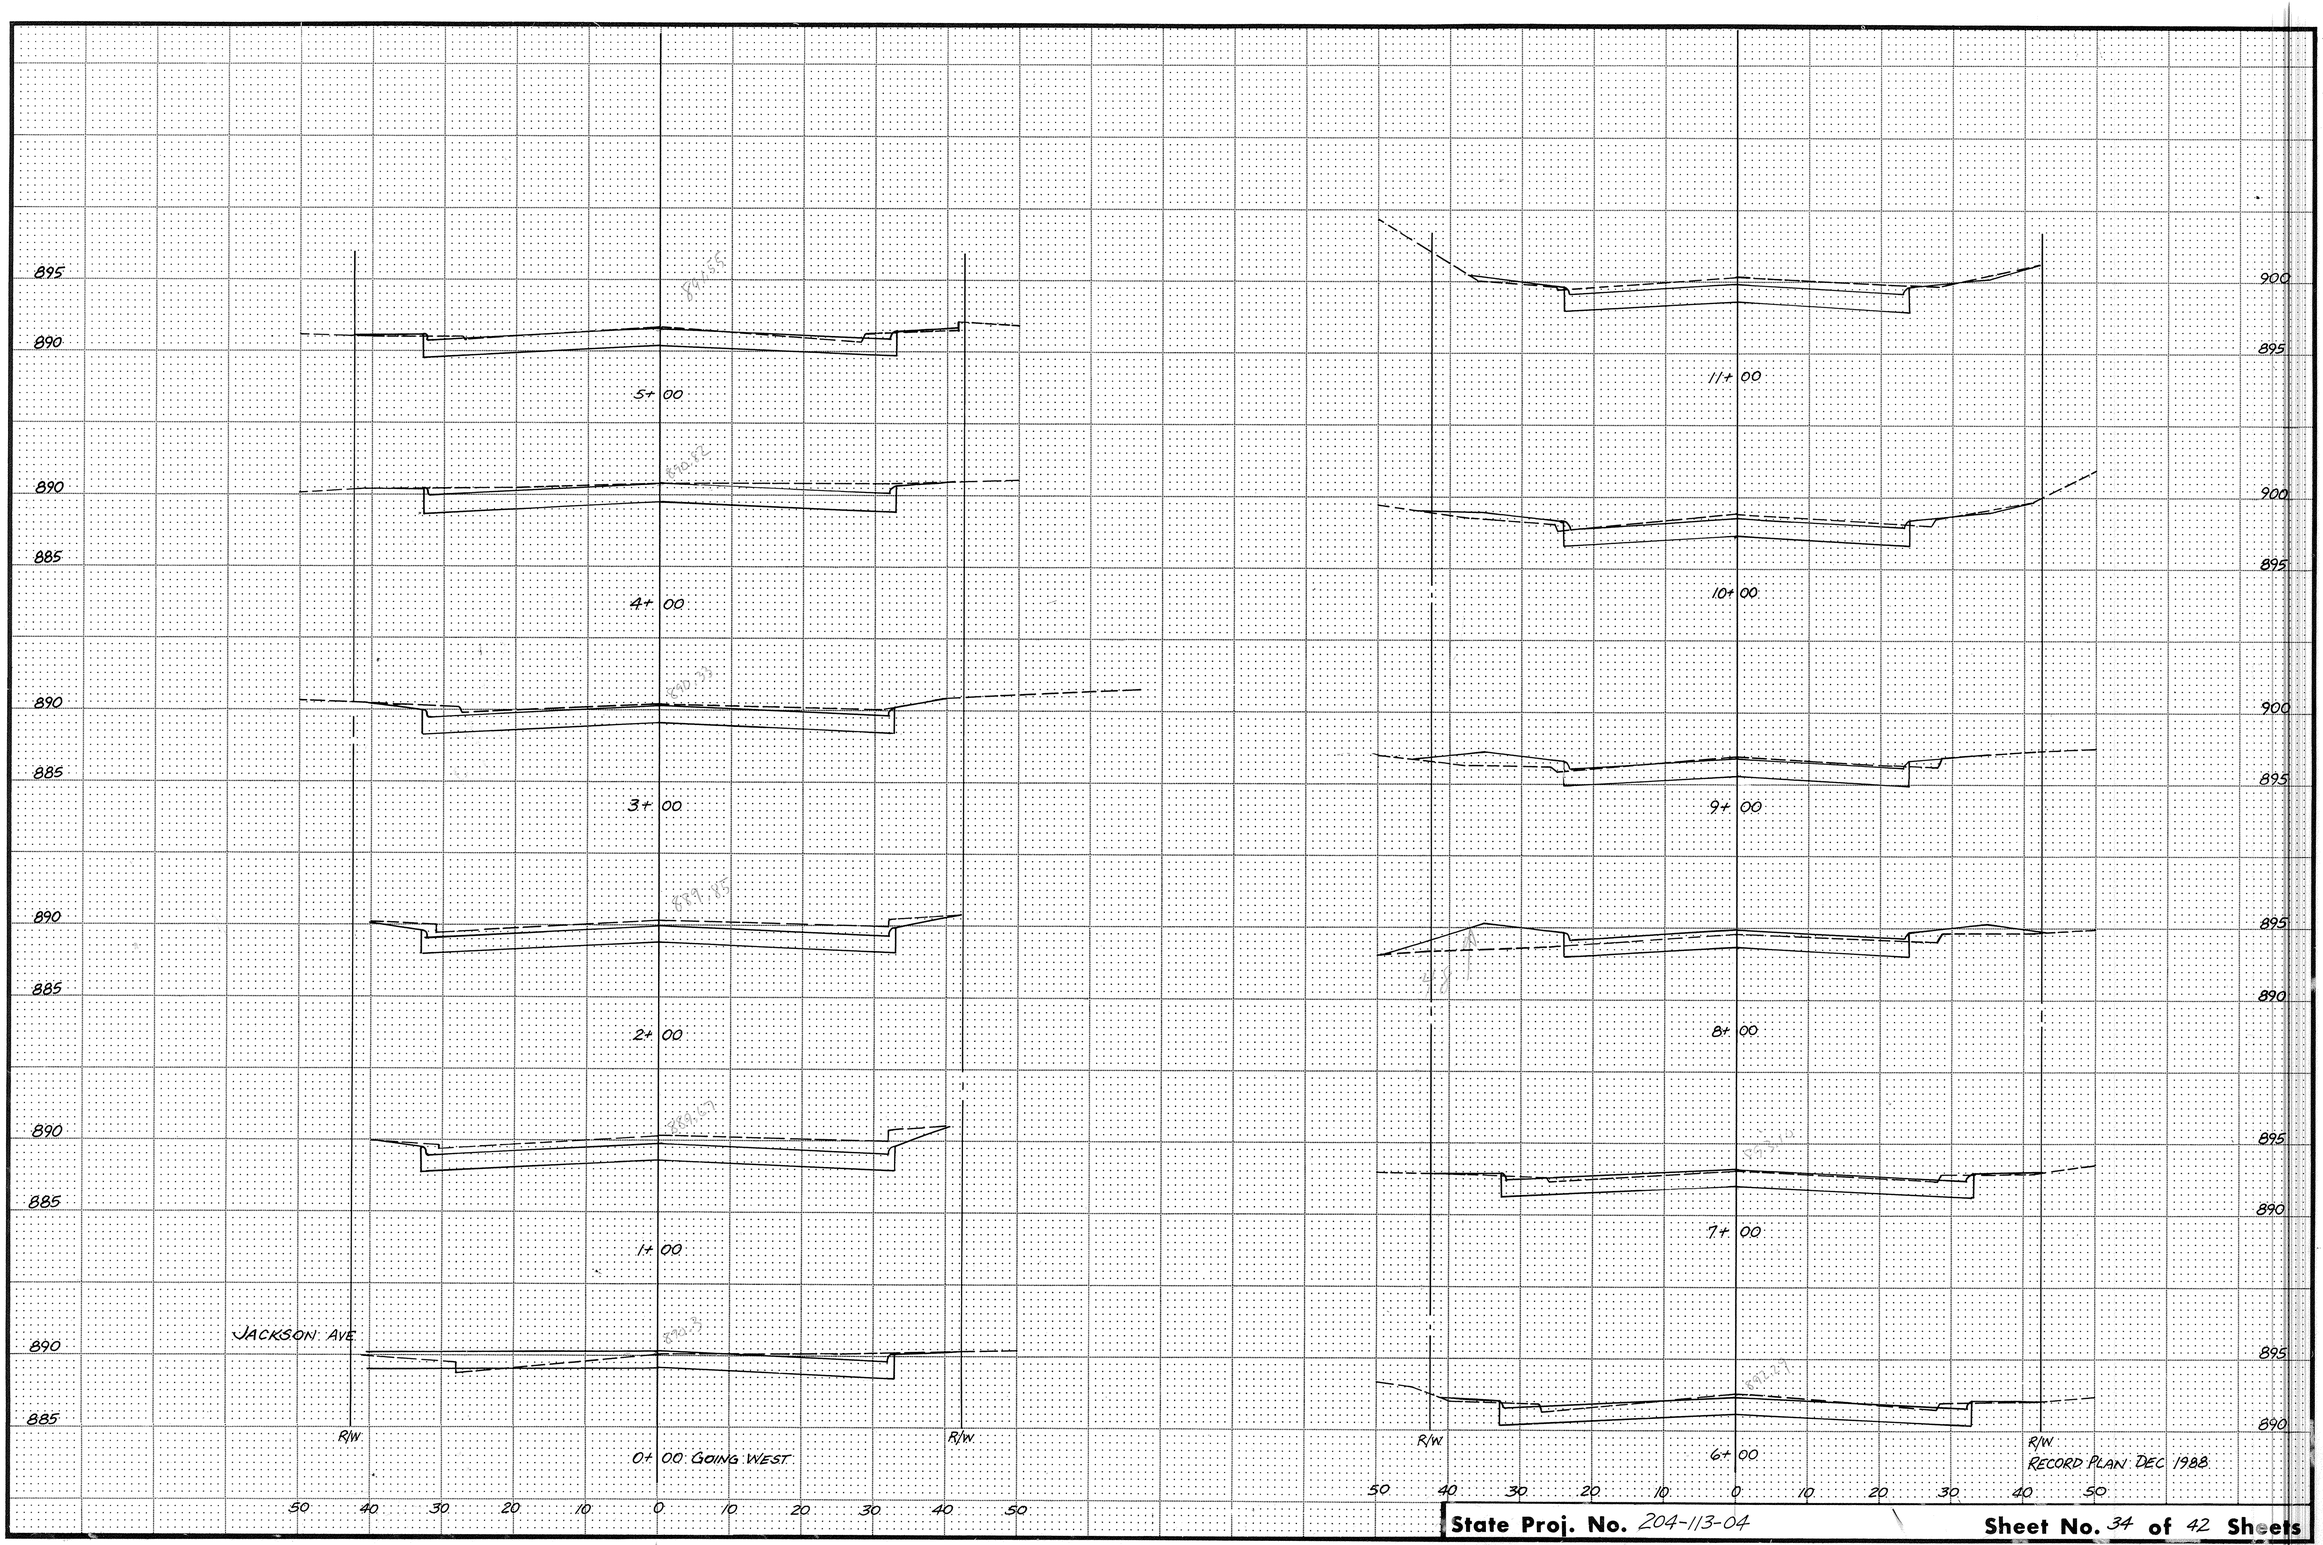

State Proj. No. 204-113-04 **Sheet No.** 34 **of** 42 **Sheets**

SCALE HORIZ 1"=10' VERT 1"=5'

MAIN STREET

241

230-014

MAINS.87
34

SAFCO PRODUCTS • NEW ULM, MINNESOTA
RECORDED BY PART NUMBER 65502
PRINTING MADE BY PART NUMBER 65502
