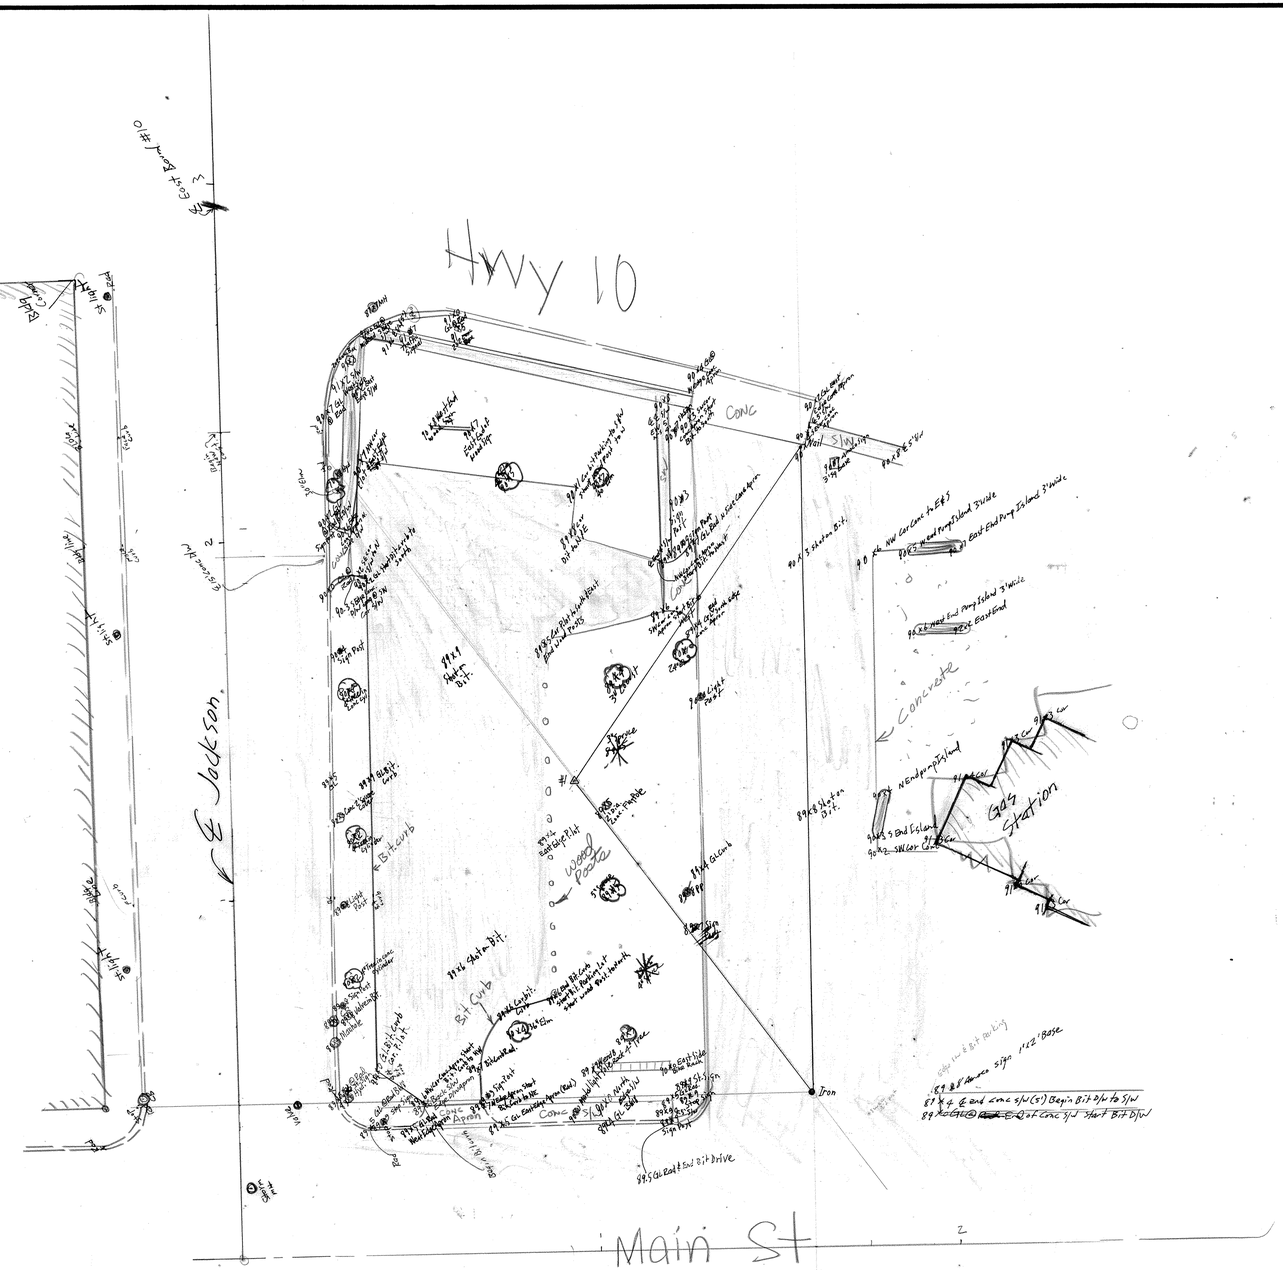

Pencil Topo from Notes from 11/16/85

Maier Stewart & Associates Inc. CONSULTING ENGINEERS 1959 SLOAN PLACE (612)774-6021 ST. PAUL, MINNESOTA 55117	REVISIONS: DATE / DESCRIPTION	DESIGNED ____ CHECKED ____ DRAWN MRJ GRAPHIC SCALE HORIZ. 20 VERT.

City of Elk River
Topo City Property Between Main St & HWY 10 East of Jackson

DATE July 1987 | SHEET 1 OF 1 SHEETS | PROJECT NO. 230-014

233C

DRAWING NUMBER

SAFCO PRODUCTS • NEW HOPE, MINNESOTA
REORDER BY PART NUMBER 65502
FRONTISH SIDE OF PAPER ONLY





DRAWING NUMBER
MAINS.87
44

SAFCO PRODUCTS • NEW HOPE, MINNESOTA
REORDER BY PART NUMBER 65502
FRONTISH SIDE OF PAPER ONLY