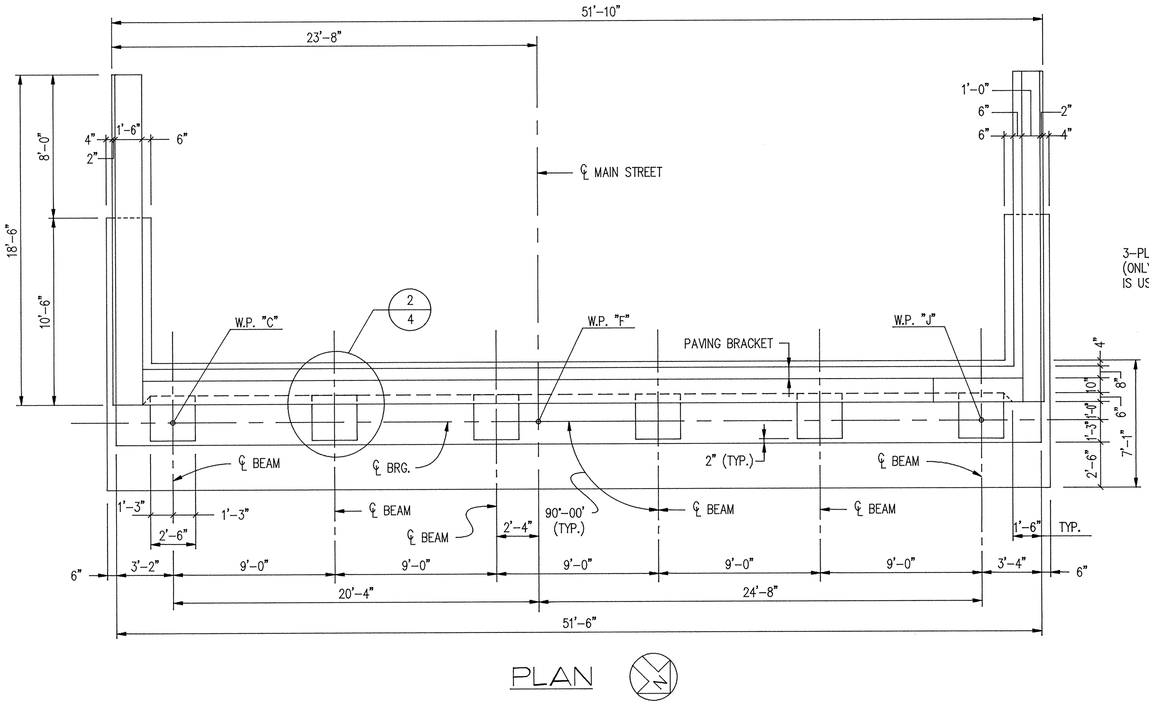

PLAN

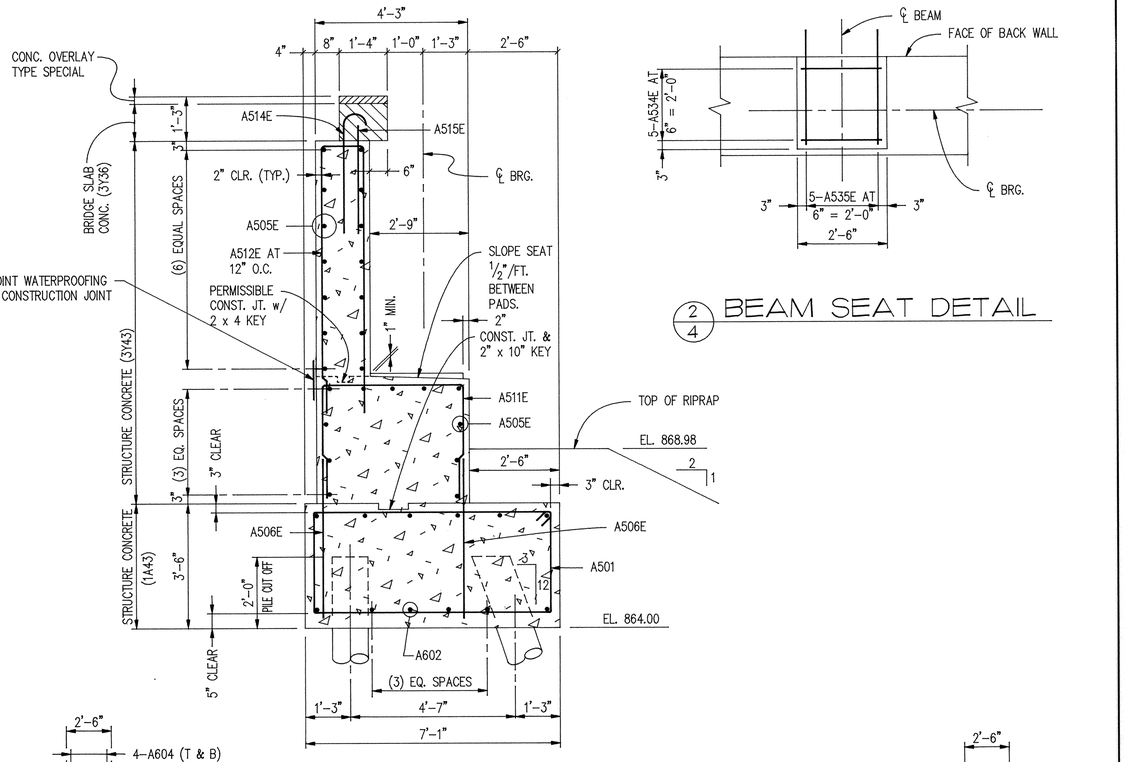

SECTION

2 / 4 BEAM SEAT DETAIL

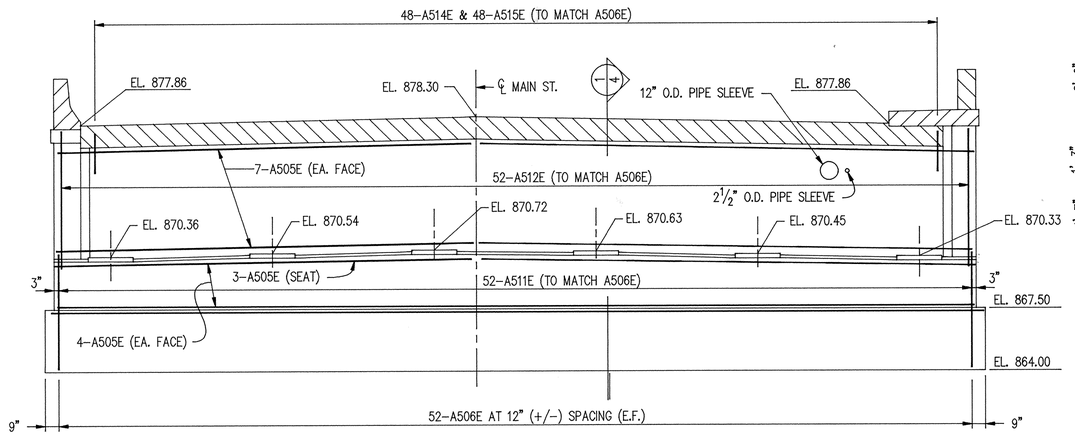

ELEVATION

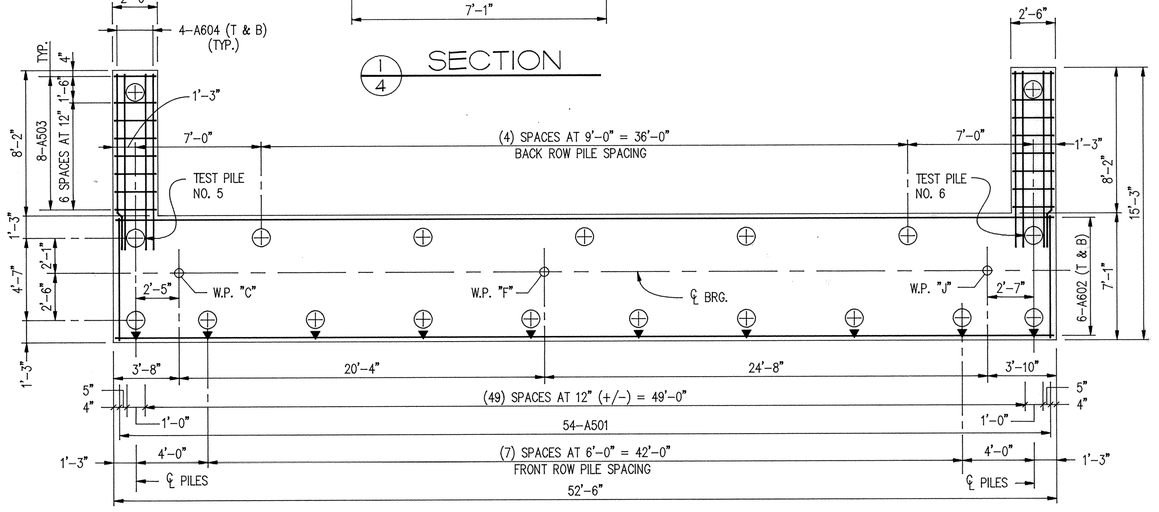

PILE PLAN

Larson
ENGINEERING OF MINNESOTA
3524 LABORE ROAD
WHITE BEAR LAKE, MN. 55110
612–481–9120

S.P. 204–113–03

RECORD PLAN OCT. 1993

SOUTH ABUTMENT

DES : DRM	DR : GLA	APPROVED : 7-2-92	Bridge No. 71517
CHK : RLD	CHK : RLD		
Sheet No. 4 of 24 Sheets			

DRAWING NUMBER
SAFCO PRODUCTS • NEW HOPE, MINNESOTA
REORDER BY PART NUMBER 6502
DRAWING NUMBER
DRAWING NUMBER 4 MAINS.91