Fed. Proj. No.

LIMITS OF RIPRAP SHOWN ARE APPROXIMATE ONLY. EXACT LIMITS TO BE DETERMINED BY ENGINEER IN FIELD.

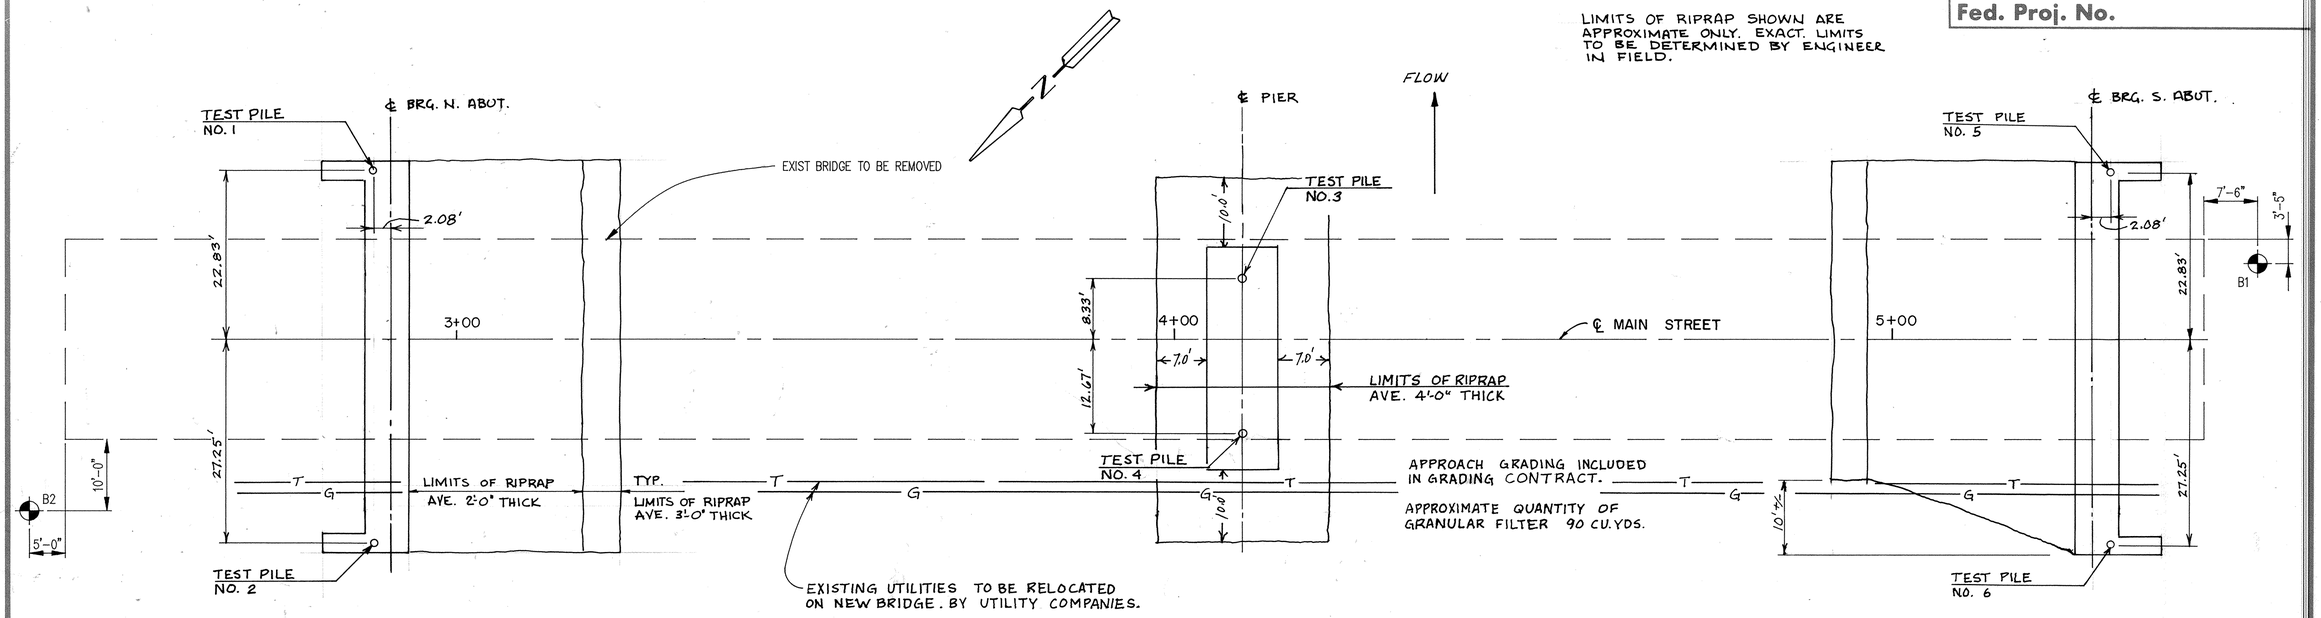

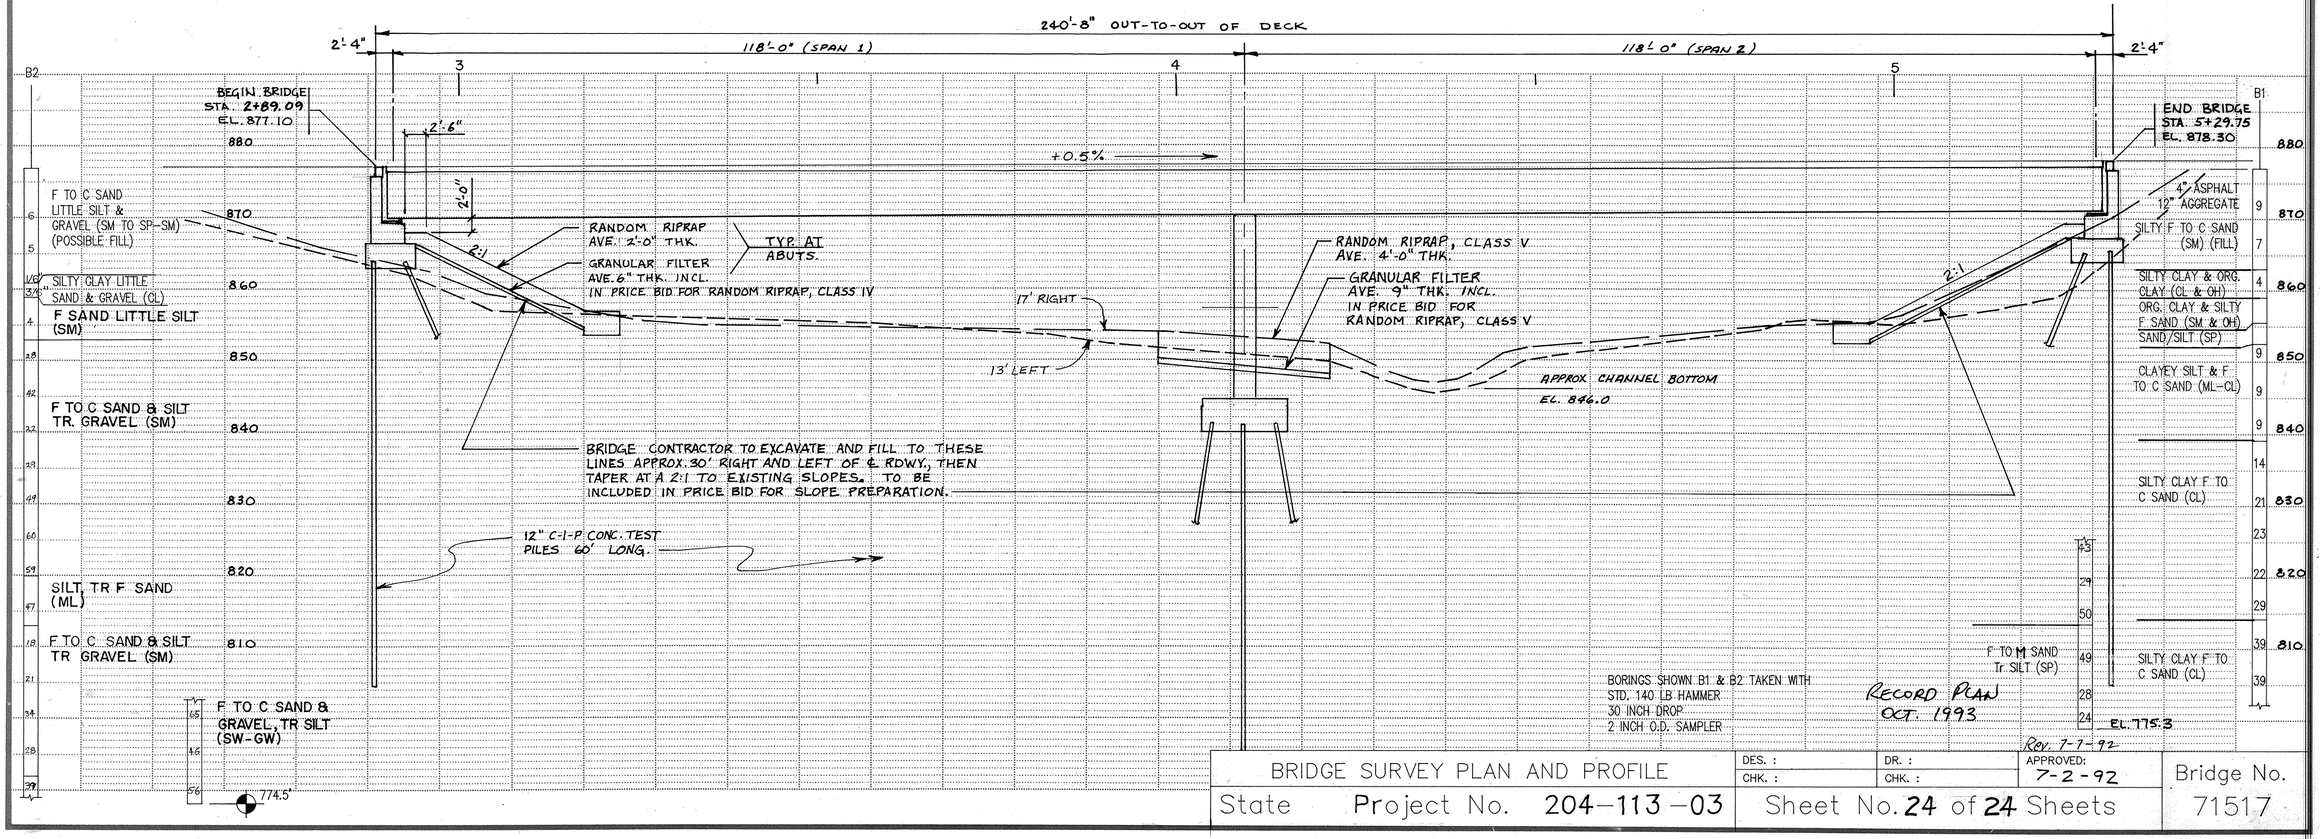

BORINGS SHOWN B1 & B2 TAKEN WITH STD. 140 LB HAMMER 30 INCH DROP 2 INCH O.D. SAMPLER

RECORD PLAN OCT. 1993

REV. 7-7-92

BRIDGE SURVEY PLAN AND PROFILE	DES. :	DR. :	APPROVED: 7-2-92	Bridge No.
	CHK. :	CHK. :		
State Project No. 204-113-03	Sheet No. 24 of 24 Sheets			71517

Copy Equipment Form #2

DRAWING NUMBER

DRAWING NUMBER

DRAWING NUMBER MAINS.91 24

STOCK PRODUCTS • NEW HOPE, MINNESOTA REORDER BY PART NUMBER 6992