


MAIN STREET

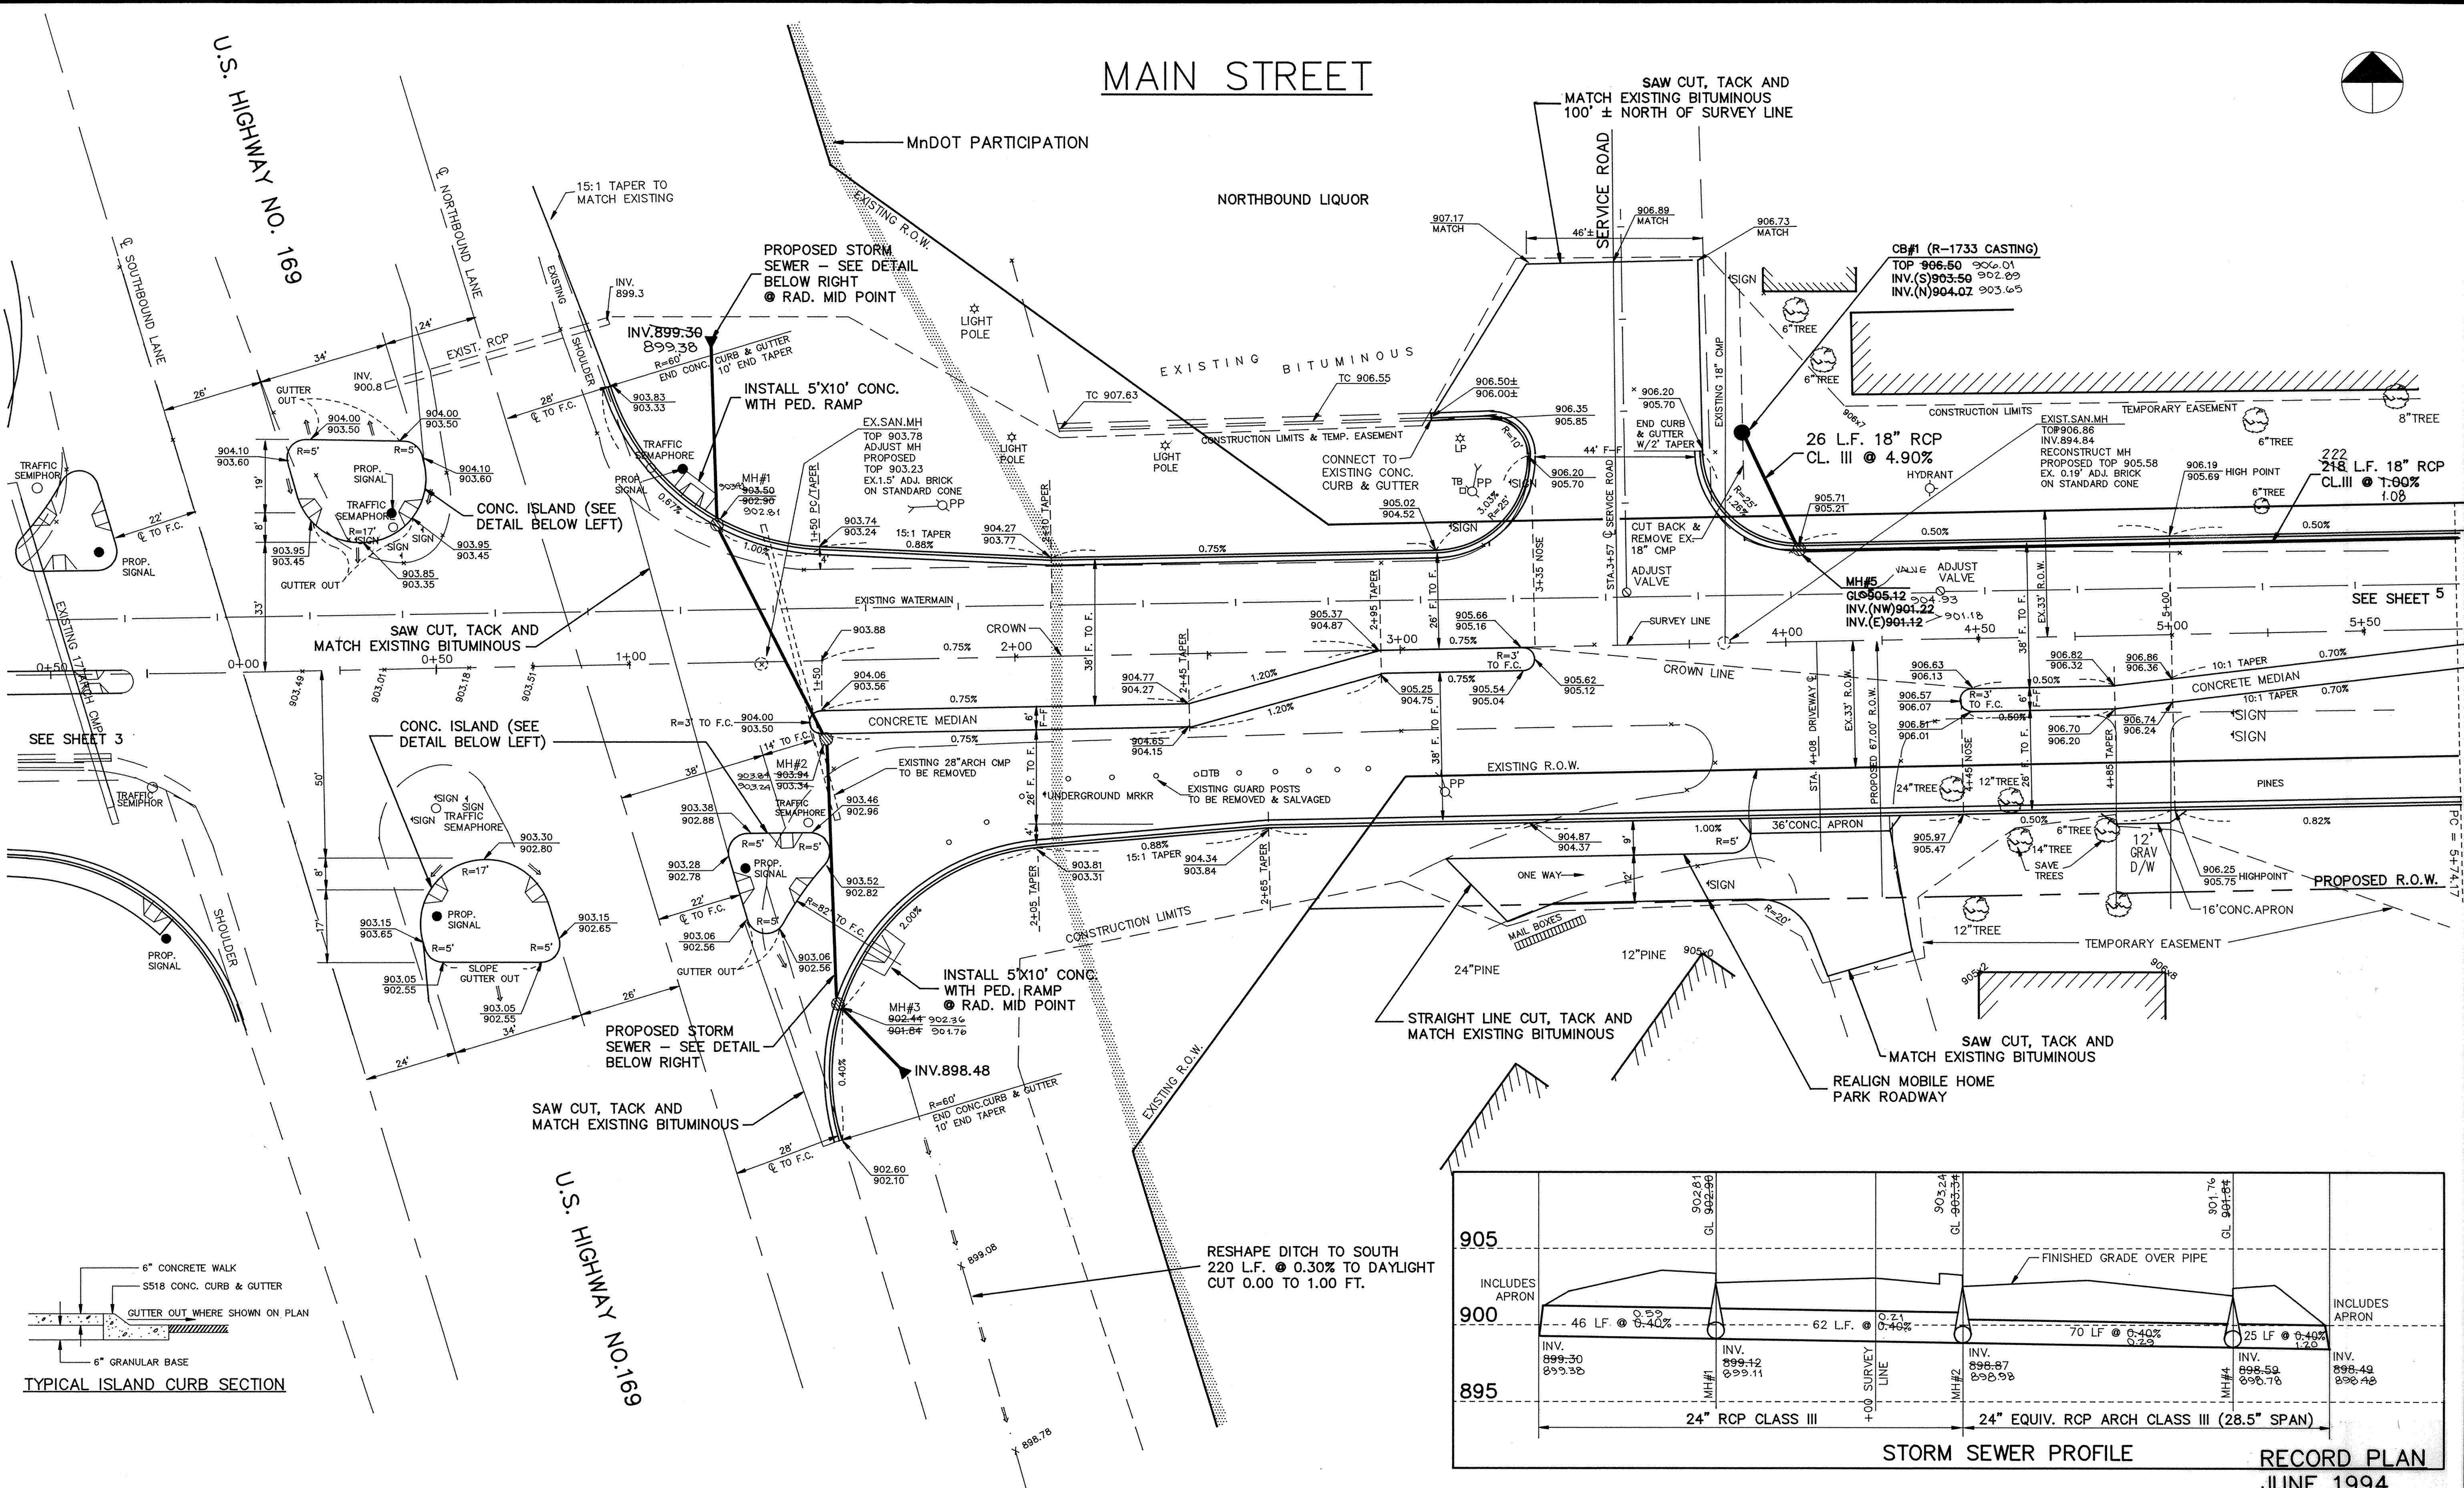

I HEREBY CERTIFY THAT THIS PLAN, SPECIFICATION, OR REPORT WAS PREPARED BY ME OR UNDER MY DIRECT SUPERVISION AND THAT I AM A DULY REGISTERED PROFESSIONAL ENGINEER UNDER THE LAWS OF THE STATE OF MINNESOTA.

Paul Bruth

DATE 4-3-92 REG. NO. 13929

Maier Stewart & Associates Inc.

CONSULTING ENGINEERS

9800 SHELARD PARKWAY (612) 546-0432 MINNEAPOLIS, MINNESOTA 55441
1959 SLOAN PLACE (612) 774-6021 ST. PAUL, MINNESOTA 55117

DATE	DESCRIPTION	DESIGNED	CHECKED
1/28/92	MnDOT PARTICIPATION	PEB	JEJ
REVISIONS	DESCRIPTION	DRAWN	GRAPHIC SCALE
4/3/92	PLANS ENGINEER COMMENTS		0 HORIZ. 20 0 VERT. 5

CITY OF ELK RIVER
STREET CONSTRUCTION
MAIN STREET AT TH 169
S.A.P. 204-113-05

0+00 TO 5+50 EAST

DATE MARCH, 1991 SHEET 4 OF 17 SHEETS PROJECT NO. 230-099

