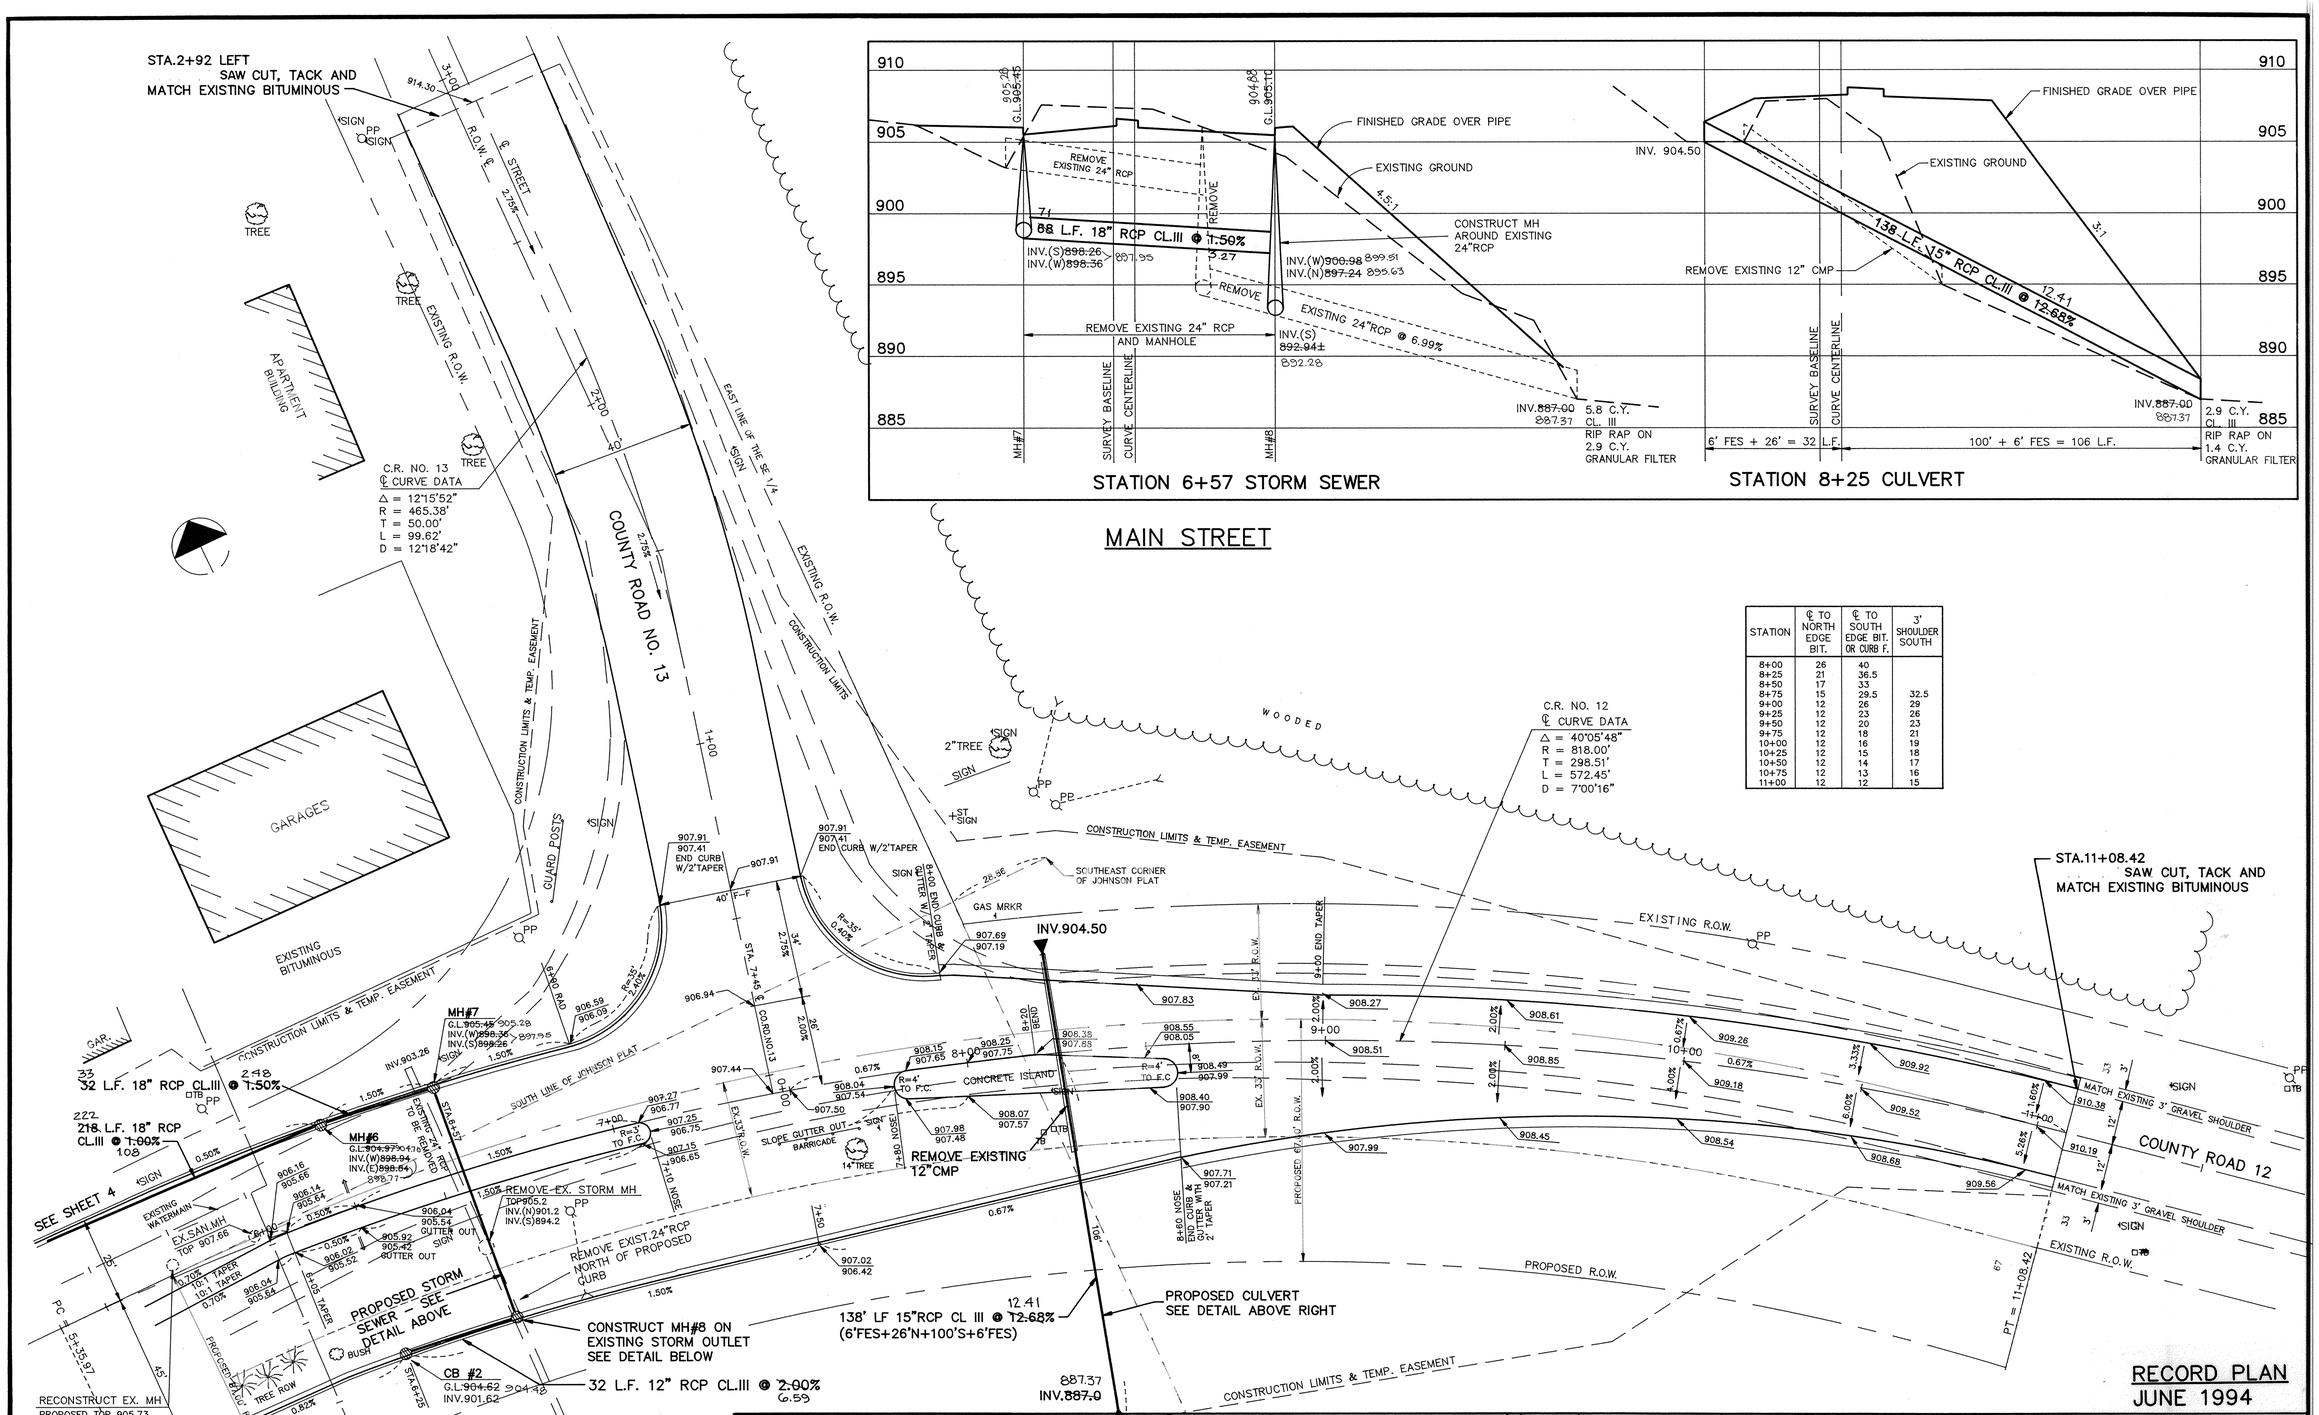

STATION	℄ TO NORTH EDGE BIT.	℄ TO SOUTH EDGE BIT. OR CURB F.	3' SHOULDER SOUTH
8+00	26	40	
8+25	21	36.5	
8+50	17	33	
8+75	15	29.5	32.5
9+00	12	26	29
9+25	12	23	26
9+50	12	20	23
9+75	12	18	21
10+00	12	16	19
10+25	12	15	18
10+50	12	14	17
10+75	12	13	16
11+00	12	12	15

RECORD PLAN
JUNE 1994

I HEREBY CERTIFY THAT THIS PLAN, SPECIFICATION, OR REPORT WAS PREPARED BY ME OR UNDER MY DIRECT SUPERVISION AND THAT I AM A DULY REGISTERED PROFESSIONAL ENGINEER UNDER THE LAWS OF THE STATE OF MINNESOTA.

Paul Bertsche

DATE 4-3-92 REG. NO. 13929

CONSULTING ENGINEERS
Maier Stewart & Associates Inc.
9800 SHELARD PARKWAY (612) 546-0432 MINNEAPOLIS, MINNESOTA 55441
1959 SLOAN PLACE (612) 774-6021 ST. PAUL, MINNESOTA 55117

REVISIONS	DATE	DESCRIPTION
	2/26/92	REVISED PER STATE AID PLANS ENGINEER COMMENTS

DESIGNED PEB
CHECKED JEJ
DRAWN GG
GRAPHIC SCALE
0 HORIZ. 20
0 VERT. 5

CITY OF ELK RIVER
STREET CONSTRUCTION
MAIN STREET AT TH 169
S.A.P. 204-113-05
STA.5+50 TO 11+00 EAST

DATE MARCH 1991 | SHEET 5 OF 17 SHEETS | PROJECT NO. 230-099

DRAWING NUMBER
DRAWING NUMBER
DRAWING NUMBER
DRAWING NUMBER
MAINS.92
5