MAIN STREET

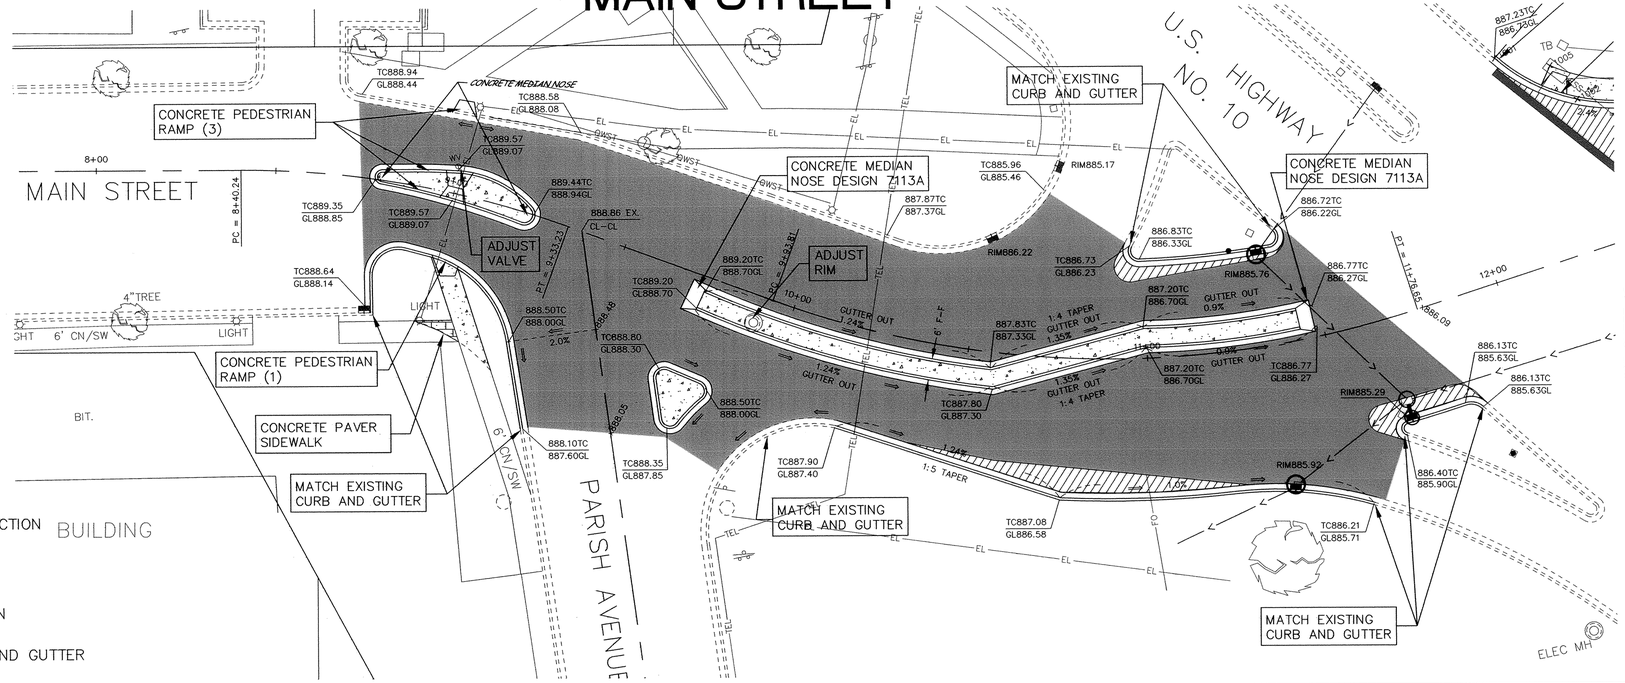

— DENOTES CONCRETE PAVEMENT SECTION

— DENOTES FULL PAVEMENT SECTION

— DENOTES BITUMINOUS MILL SECTION

— DENOTES B618 CONCRETE CURB AND GUTTER

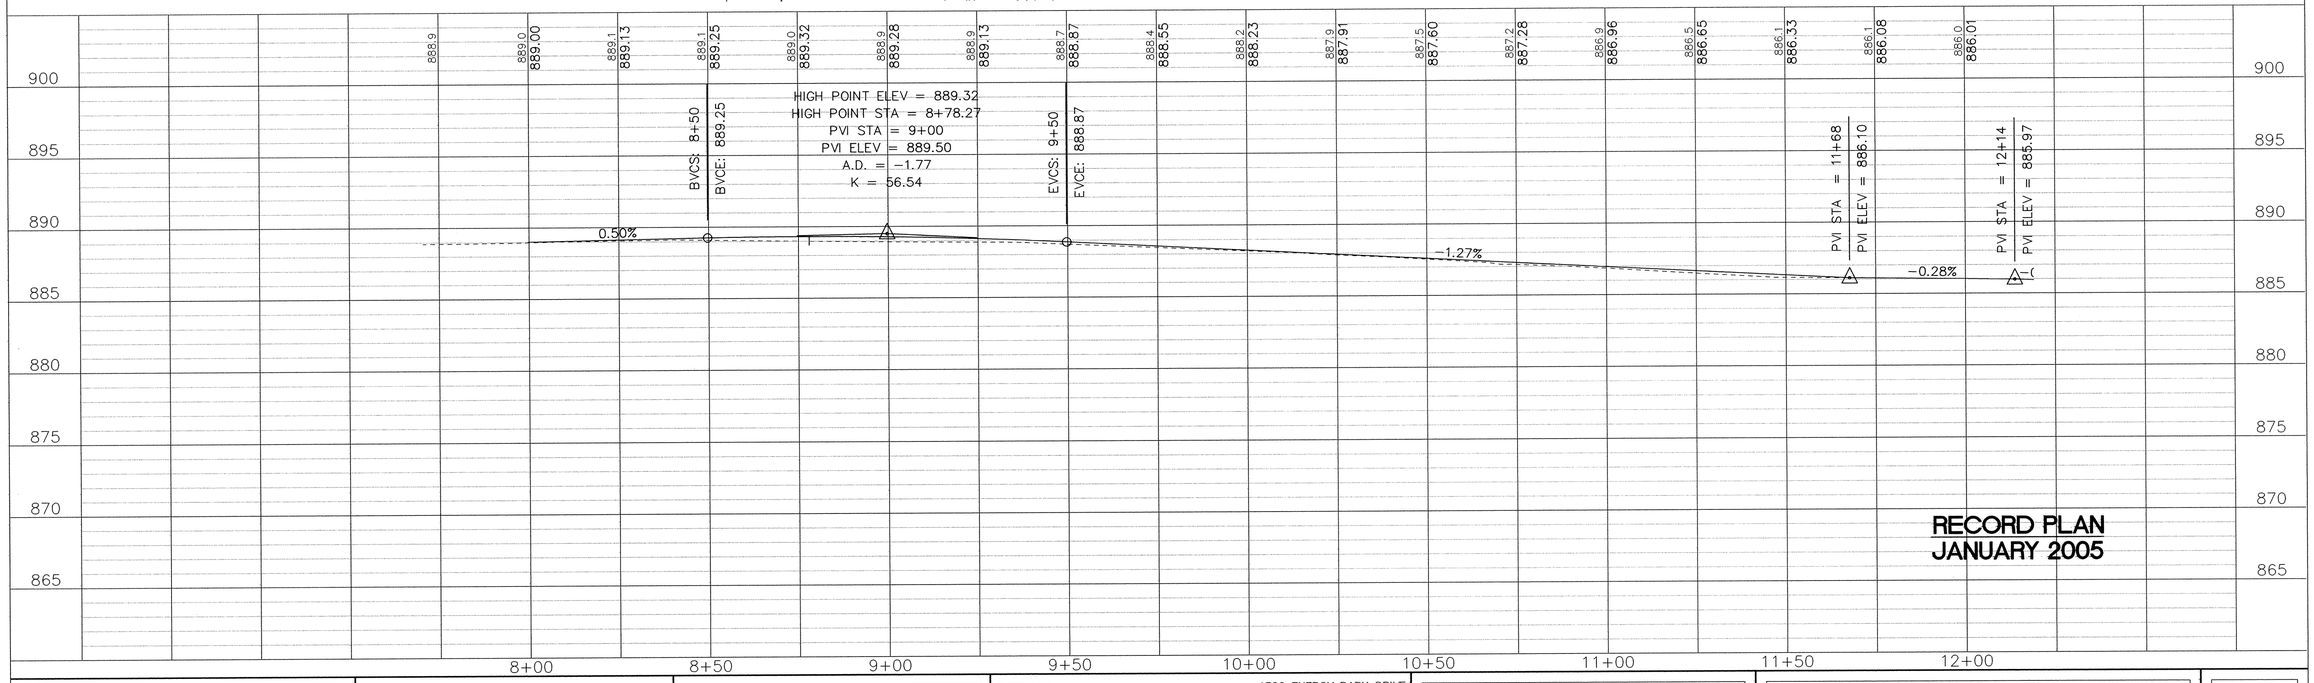

RECORD PLAN
JANUARY 2005

Xrefs: XCT-BASE.DWG

DESIGNED BY: EY DRAWN BY: EY
APPROVED BY: JOB NUMBER 816600J
CAD DATE: January 06, 2005 11:05:17 a.m.
CAD FILE: 816600j\ASBUILT\816600P-P.DWG (JCUNNIN)

I HEREBY CERTIFY THAT THIS PLAN, SPECIFICATION, OR REPORT WAS PREPARED BY ME OR UNDER MY DIRECT SUPERVISION AND THAT I AM A DULY LICENSED PROFESSIONAL ENGINEER UNDER THE LAWS OF THE STATE OF MINNESOTA.
SIGNATURE _____ DATE 2/2/05
PRINTED NAME JOHN ANDERSON LIC.NO. 25889

NO.	DATE	BY	REVISION DESCRIPTION
1.	9-3-03	RM	REVISE PROFILE SETTINGS

Howard R. Green Company
1326 ENERGY PARK DRIVE
ST. PAUL, MINNESOTA 55108
(651) 644-4389

MAIN STREET/U.S. HIGHWAY NO. 10
CITY OF ELK RIVER

S.P. 204-113-12
STREET IMPROVEMENTS
8+00 TO 12+00

SHEET NO. 11

SAFCO PRODUCTS • NEW HOPE, MINNESOTA
RECHECK BY PART NUMBER 6552
POSITION EDGE OF PRINT ON THIS LINE