MAIN STREET

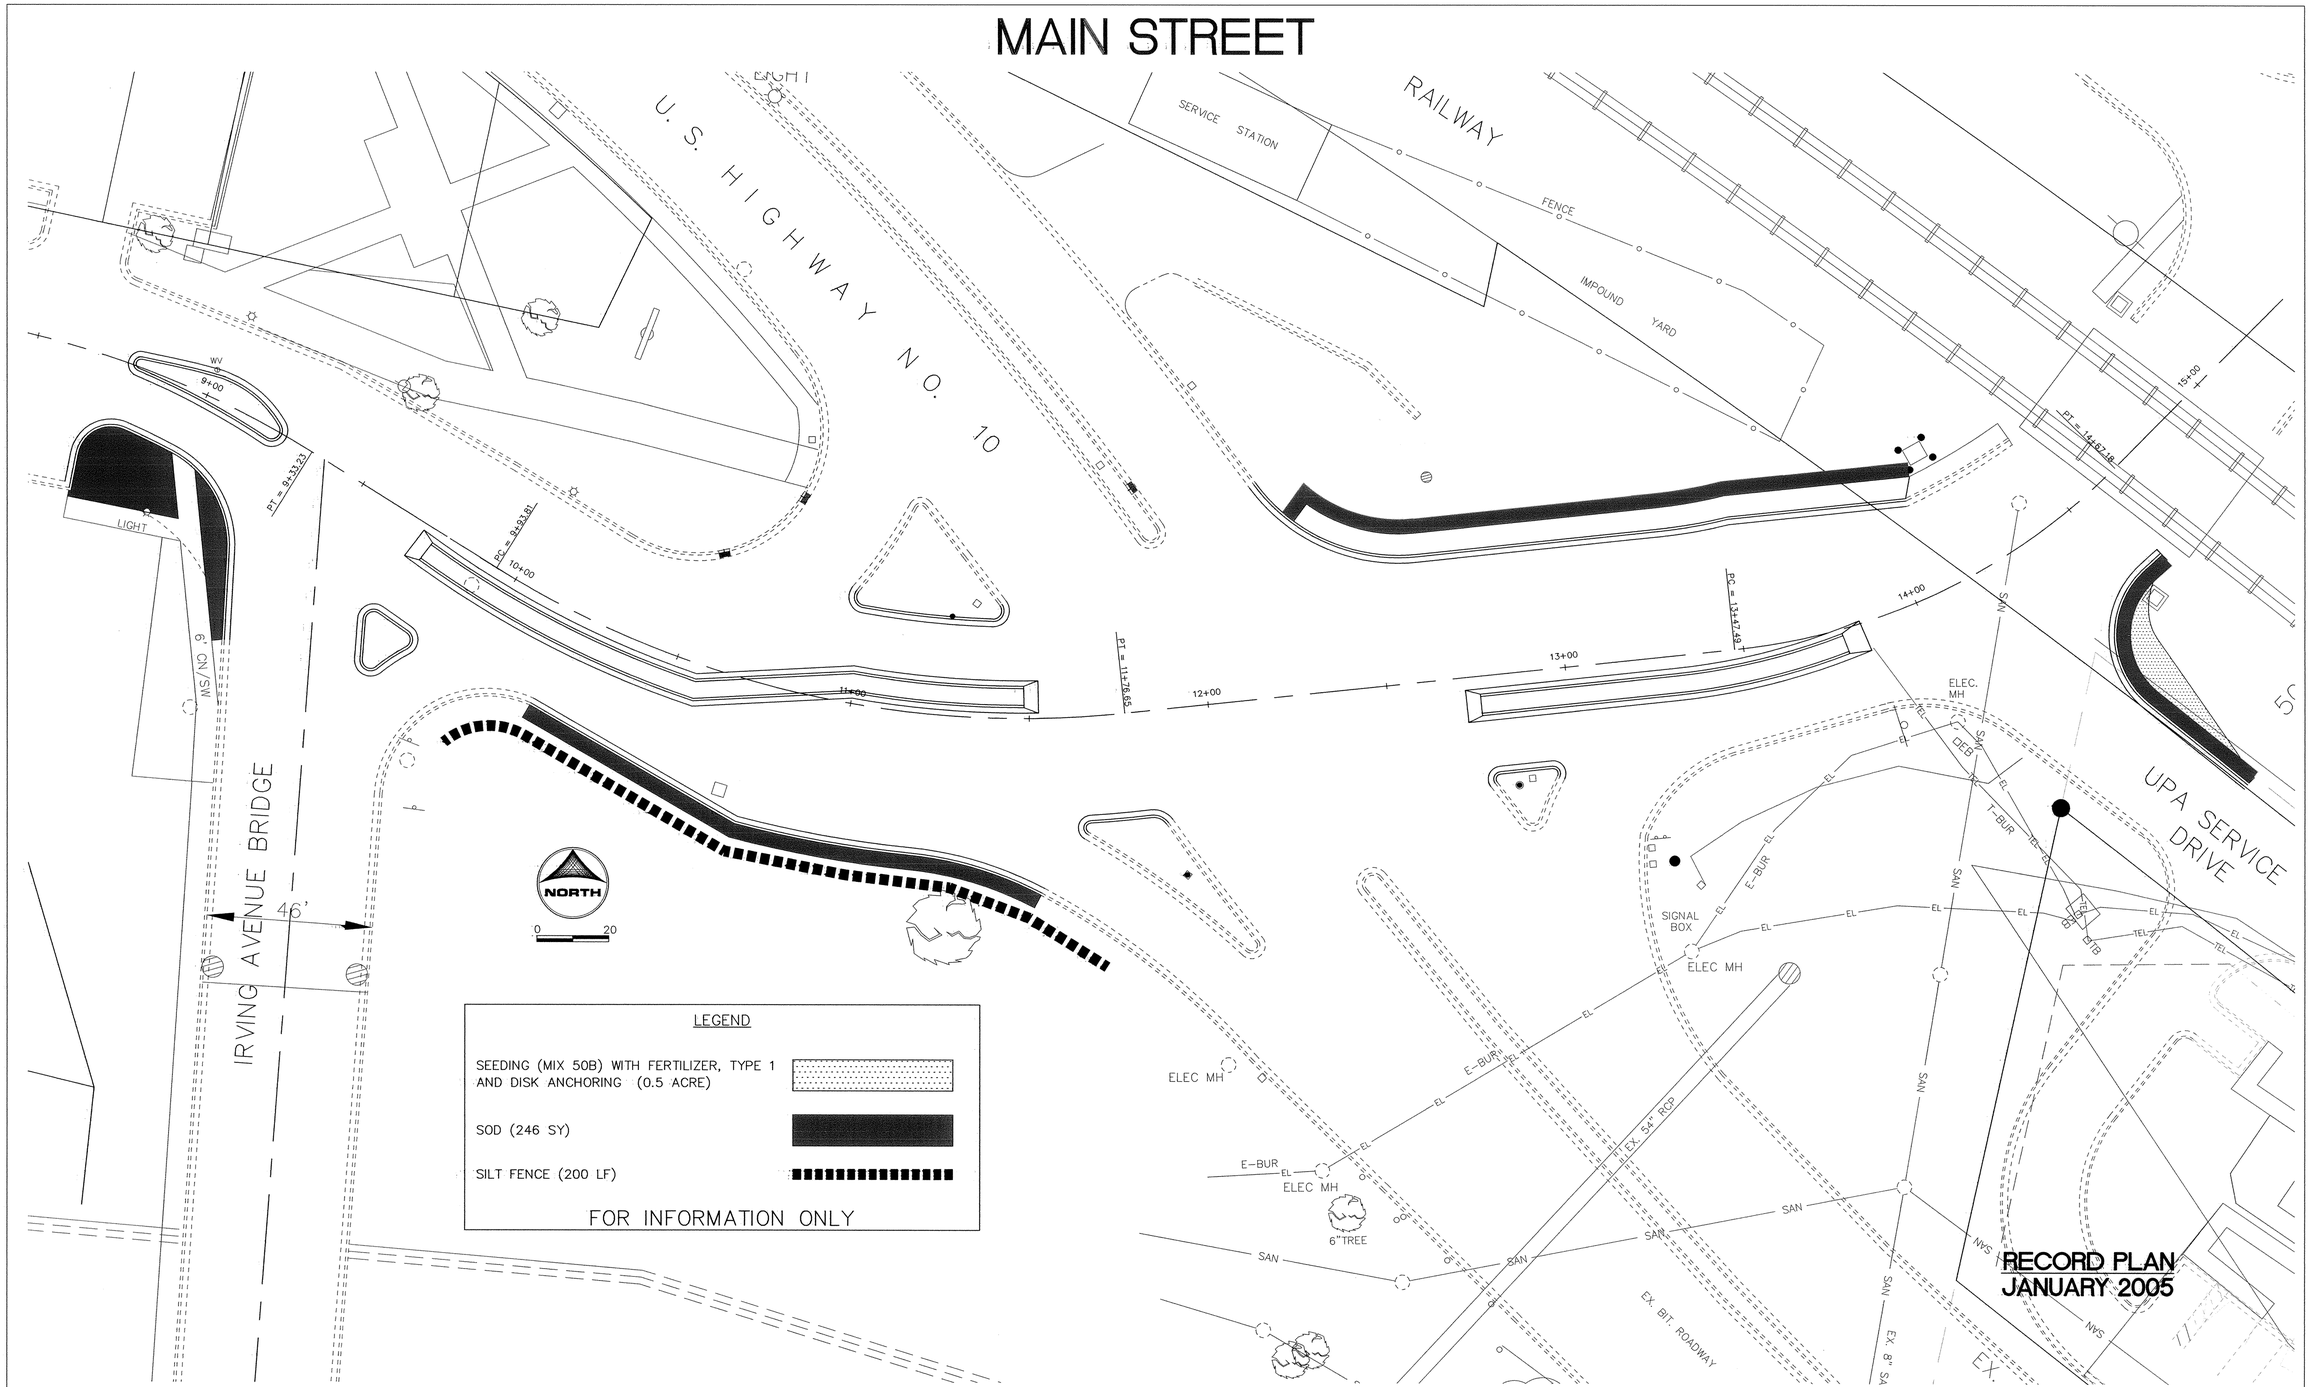

LEGEND

SEEDING (MIX 50B) WITH FERTILIZER, TYPE 1 AND DISK ANCHORING (0.5 ACRE)

SOD (246 SY)

SILT FENCE (200 LF)

FOR INFORMATION ONLY

DESIGNED BY: EY DRAWN BY: EY
APPROVED BY: JOB NUMBER 816600J
CAD DATE: January 11, 2005 10:05:06 a.m.
CAD FILE: 816600j\ASBUILT\MISC\XCT-EROSION.DWG (JCUNNIN)

I HEREBY CERTIFY THAT THIS PLAN, SPECIFICATION, OR REPORT WAS PREPARED BY ME OR UNDER MY DIRECT SUPERVISION AND THAT I AM A DULY LICENSED PROFESSIONAL ENGINEER UNDER THE LAWS OF THE STATE OF MINNESOTA.

SIGNATURE _____ DATE _____
PRINTED NAME JOHN ANDERSON LIC.NO. 25889

NO.	DATE	BY	REVISION DESCRIPTION

1326 ENERGY PARK DRIVE
ST. PAUL, MINNESOTA 55108
(651) 644-4389
Howard R. Green Company

MAIN STREET/U.S. HIGHWAY NO. 10
CITY OF ELK RIVER

S.P.204-113-12
EROSION CONTROL AND TURF ESTABLISHMENT PLAN
8+40 TO 14+70

SHEET NO.
13

MAINS.05
14

SAFCO PRODUCTS • NEW HOPE, MINNESOTA
REORDER BY PART NUMBER 60302
POSITION EDGE OF PRINT ON THIS LINE