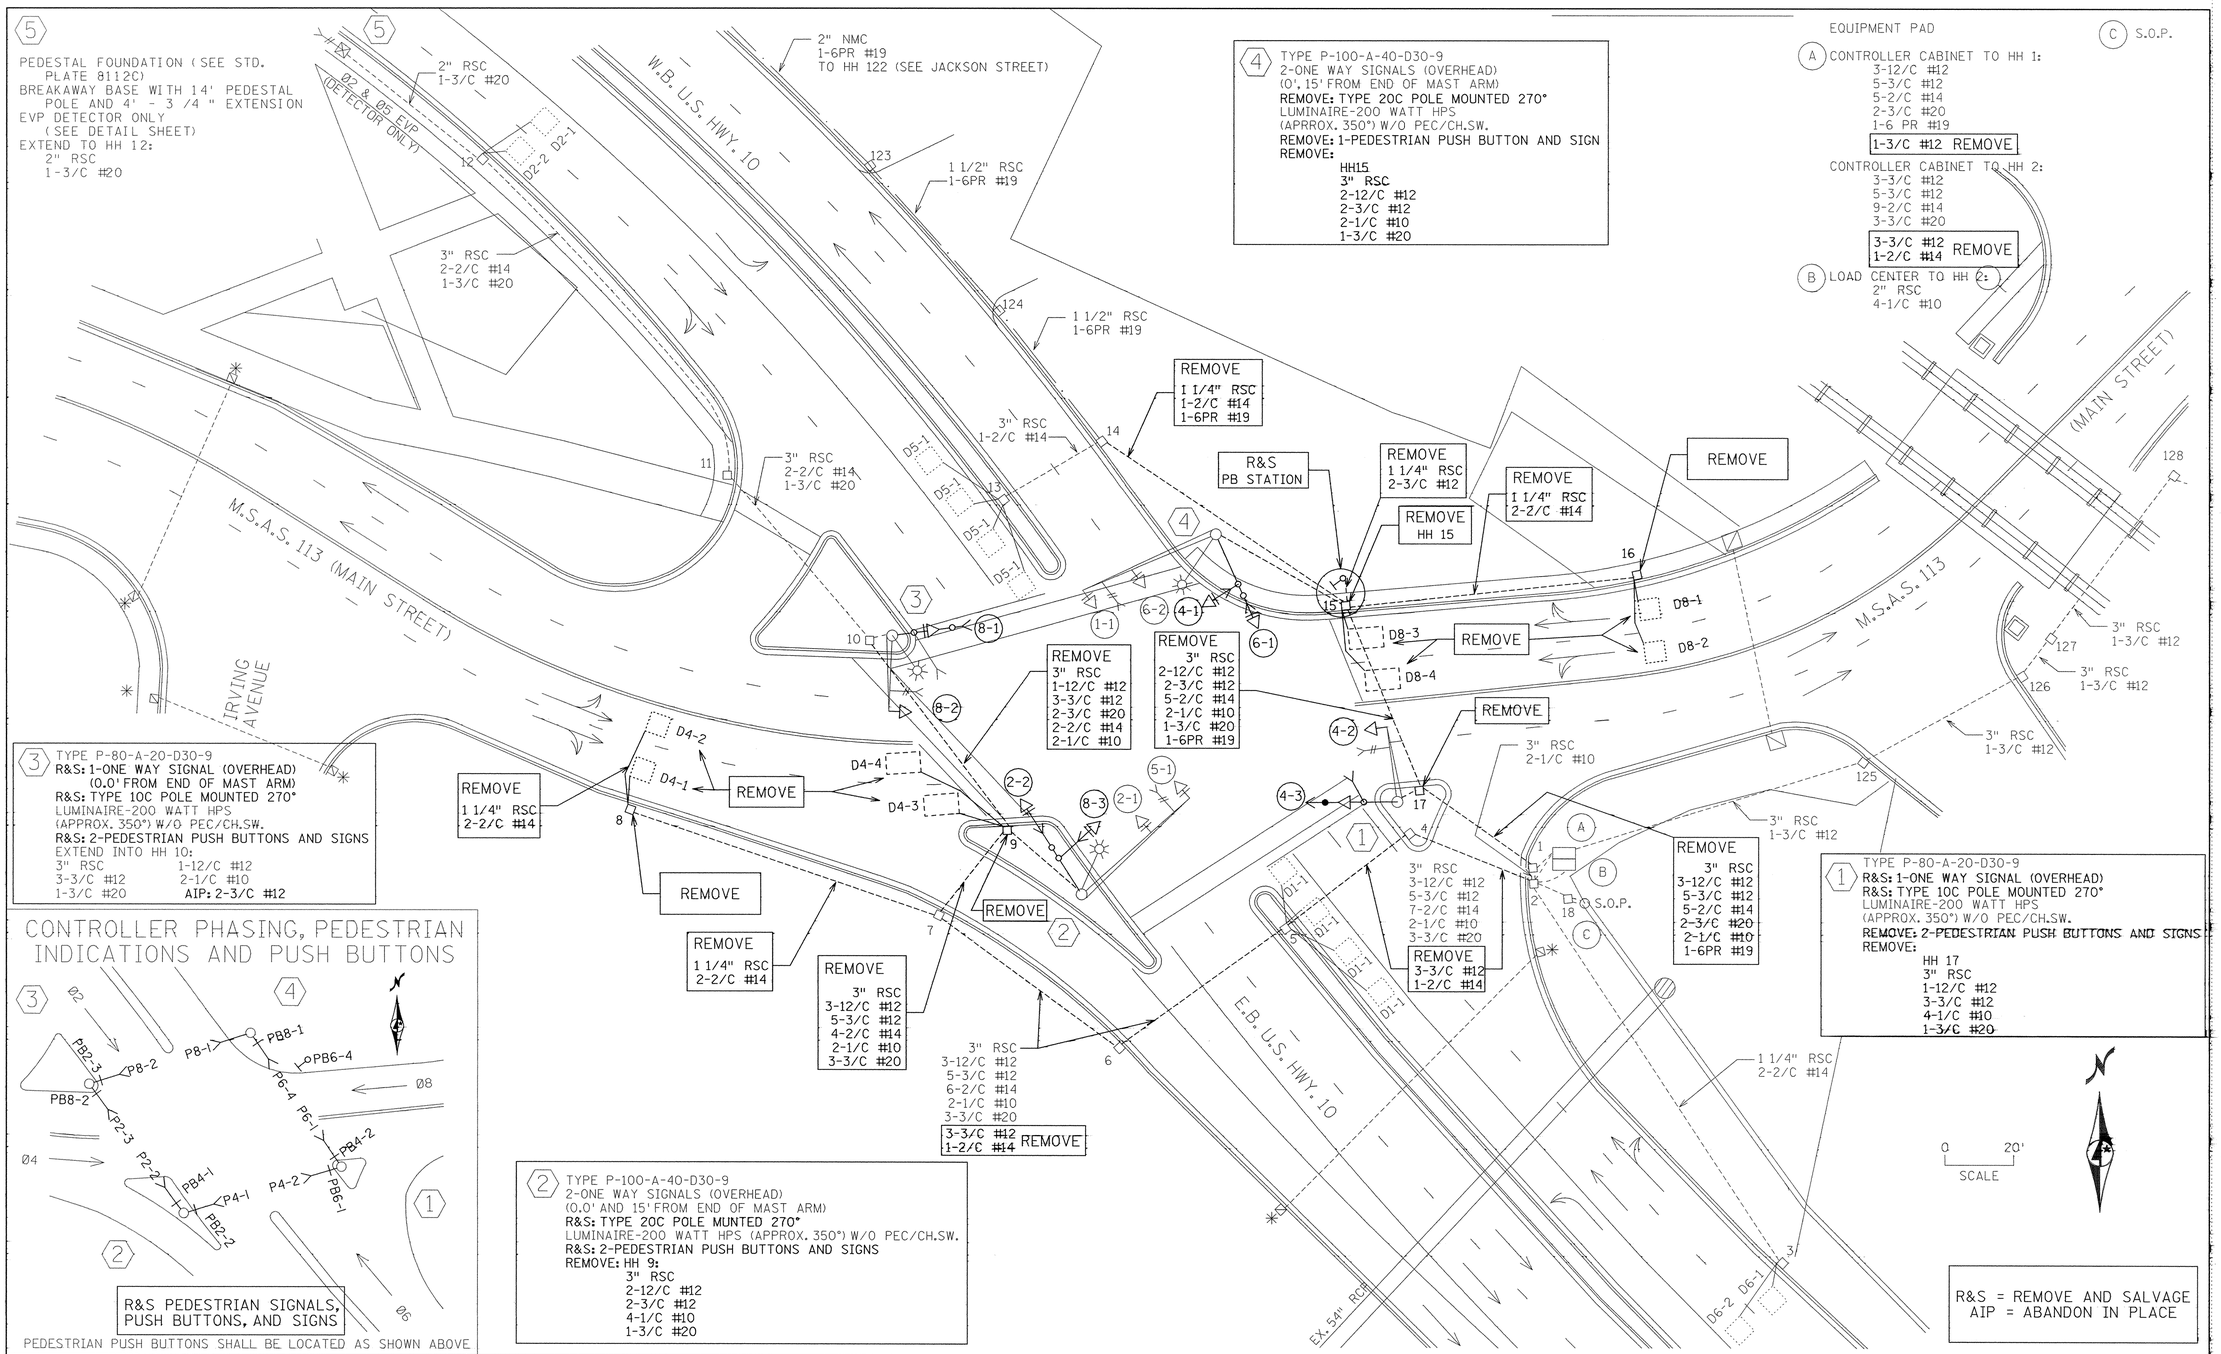

DESIGNED BY: TWS DRAWN BY: RJS
APPROVED BY: BAO JOB NUMBER 816600J
CAD DATE: 01/31/2005 11:16:42 AM
CAD FILE: o:\cad\816600J\dgn\TH10-Main Traffic Removal.dgn

I HEREBY CERTIFY THAT THIS PLAN, SPECIFICATION, OR REPORT WAS PREPARED BY ME OR UNDER MY DIRECT SUPERVISION AND THAT I AM A DULY LICENSED PROFESSIONAL ENGINEER UNDER THE LAWS OF THE STATE OF MINNESOTA

SIGNATURE _____ DATE 3-28-2003

PRINTED NAME BRIAN C. JOHNSON LIC. NO. 26815

NO.	DATE	BY	REVISION DESCRIPTION
1	2/10/05	SJM	AS-BUILTS

Howard R. Green Company
1326 ENERGY PARK DRIVE
ST. PAUL, MINNESOTA 55108
(651) 644-4389

MAIN ST./U.S. HIGHWAY NO. 10
CITY OF ELK RIVER

REMOVAL PLAN FOR INTERSECTION
TRAFFIC CONTROL

S.P. 204-113-12
T.E #3165
SYS. ID ~~20198~~

SHEET NO. 17

DRAWING NUMBER
MAINS.05
18

SAFCO PRODUCTS • NEW HOPE, MINNESOTA
REORDER BY PART NUMBER 65552
POSITION EDGE OF PRINT ON THIS LINE