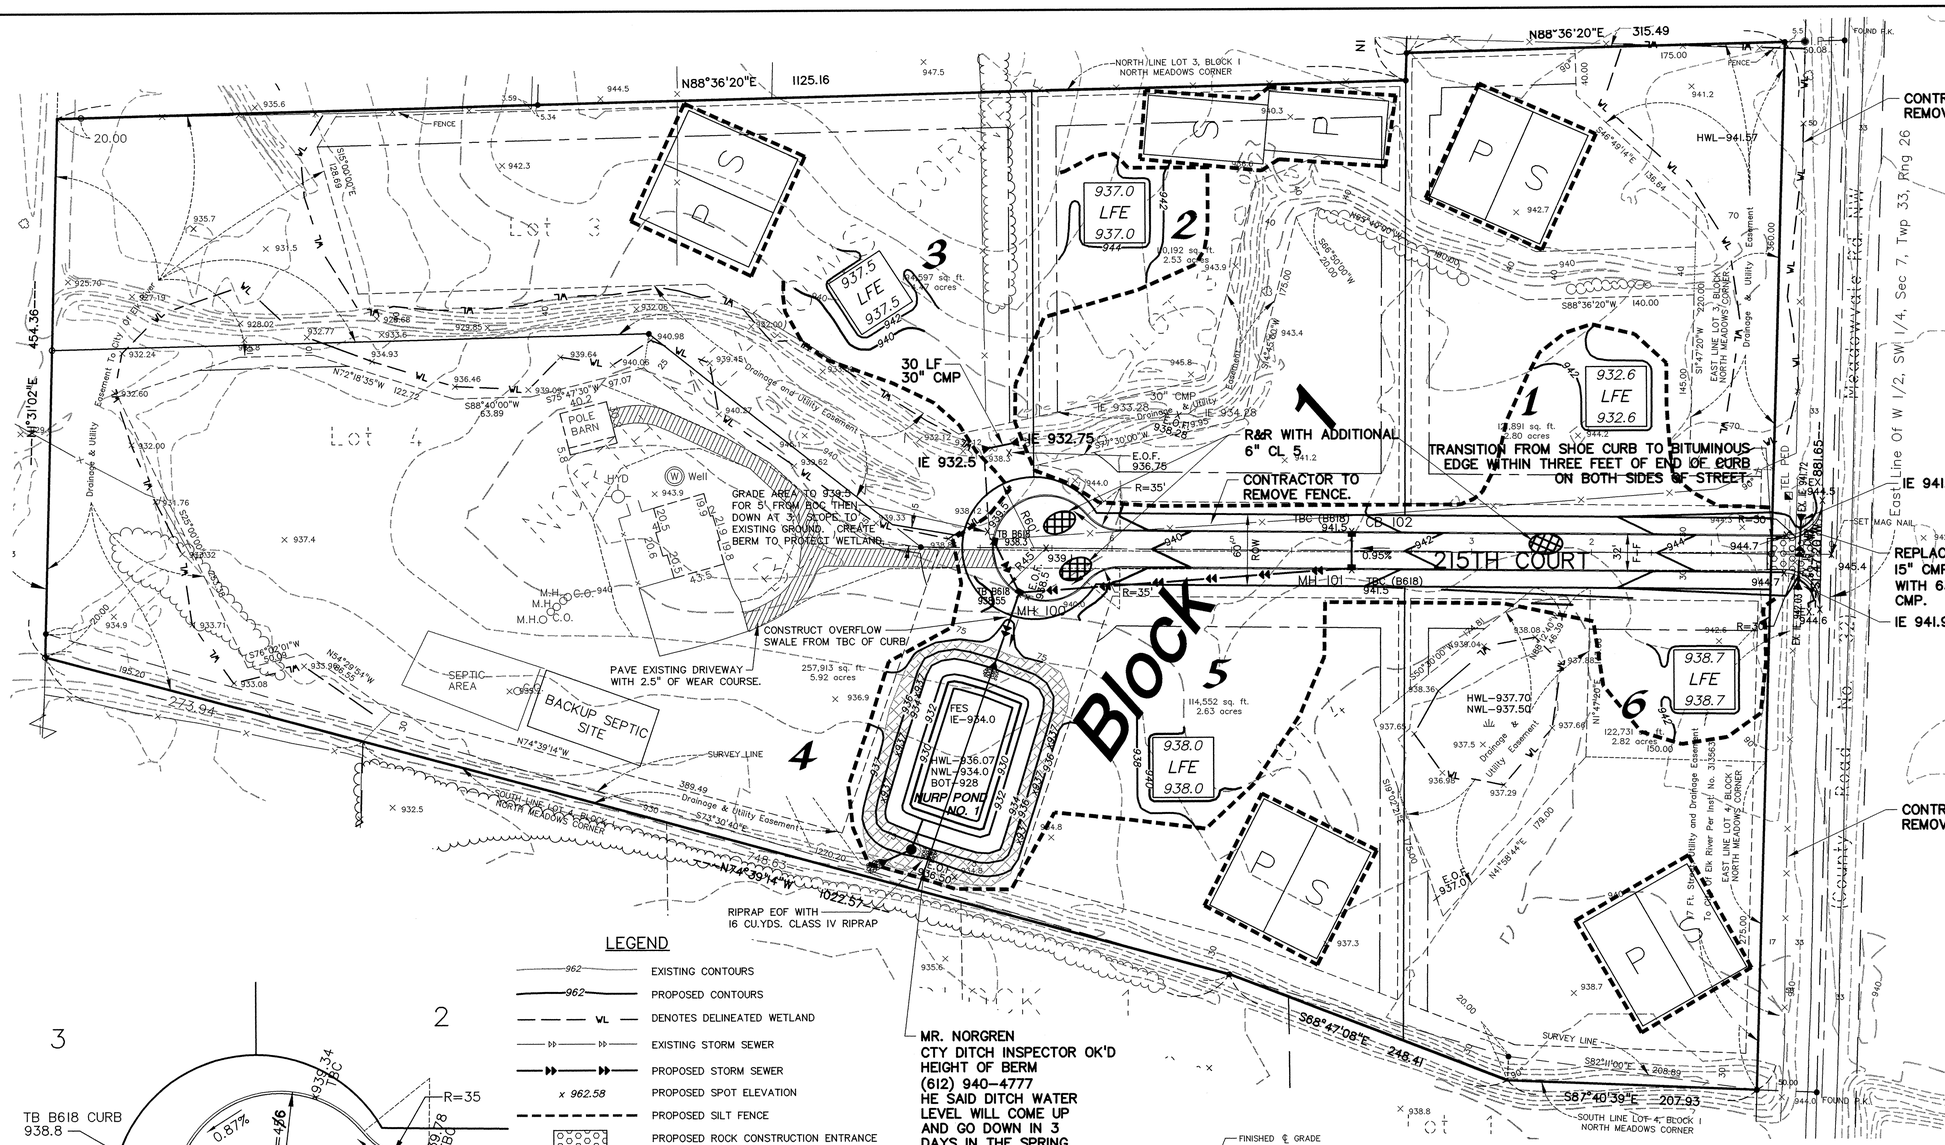

LEGEND

- EXISTING CONTOURS
- PROPOSED CONTOURS
- DENOTES DELINEATED WETLAND
- EXISTING STORM SEWER
- PROPOSED STORM SEWER
- x 962.58 PROPOSED SPOT ELEVATION
- PROPOSED SILT FENCE
- PROPOSED ROCK CONSTRUCTION ENTRANCE
- PROPOSED FIBER BLANKET
- PROPOSED DRIVEWAY PAVING

NOTES:

1. ALL SPOT ELEVATION ARE TOP BACK OF CURB UNLESS OTHERWISE NOTED.
2. INSTALL EROSION CONTROL MEASURES PRIOR TO SITE GRADING.
3. DO NOT DISTURB SEPTIC AREAS, PLACE SILT FENCE ARROUND SEPTIC AREAS PRIOR TO SITE GRADING.
4. NURP POND SHALL BE GRADED PRIOR TO START OF ROAD CONSTRUCATION.
5. SWALE SHALL BE CONSTRUCTED TO DIRECT DRAINAGE FROM THE ROAD TO POND DURING CONSTRUCTION.
6. ACCESS TO EXISTING HOME FOR EMERGENCY VEHICLE TRAFFIC SHALL BE MAINTAINED DURING CONSTRUCTION.
7. SILT FENCE SHALL BE INSTALED BEHIND CURB/PAVEMENT 3-DAYS AFTER BASE COURSE IS PLACED.

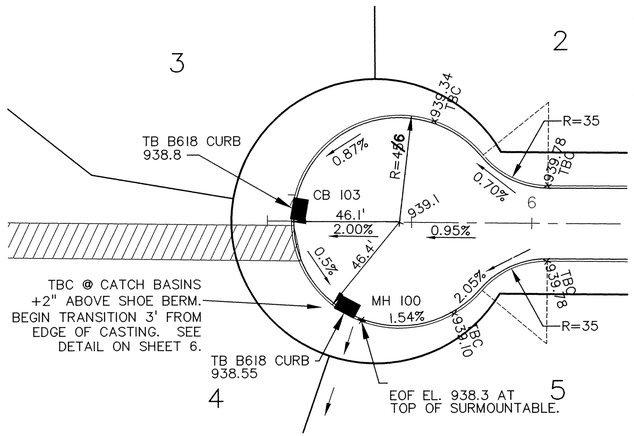

CUL-DE-SAC DETAIL

SCALE: 1" = 30'

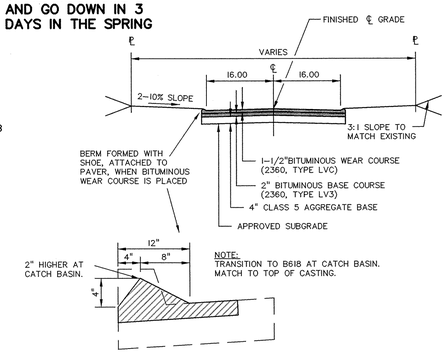

STREET SECTION WITH INTEGRAL BITUMINOUS BERM

DESCRIPTION	DATE	REV NO.
CITY COMMENTS	01/16/06	1
CITY COMMENTS	01/27/06	2
CITY COMMENTS	02/16/06	3
RECORD DRAWINGS	12/20/06	4

DATE: 12/22/05
DESIGN BY: MCB
DRAWN BY: ERW - KGA
CHECKED BY: MCB
DWG: 6635-22-FGRADE
TEXT: N/A
FILE NO.: 6635_22-03

I hereby certify that this plan, specification, or report was prepared by me or under my direct supervision and that I am a duly Licensed Professional Engineer under the laws of the State of Minnesota Statutes Sections 326.02-326.15.

Signature: Michael C. Gorsch, PE
Date: 12/22/2005 Lic. No. 42661

John Oliver & Associates, Inc.
Civil Engineering, Land Surveying, Land Planning
680 Dodge Avenue
Elk River, Minnesota 55330
763-441-2072 FAX 763-441-5665
Offices in: Elk River, Burnsville, & St. Cloud, Minnesota

THE MEADOWS OF ELK RIVER
ELK RIVER, MN
FOR
AULIK AND ASSOCIATES INC.
GRADING PLAN

SHEET NO. 2 OF 6

DRAWING NUMBER
MEADELK.06
2
SHEET NUMBER

DRAWING NUMBER