215TH. COURT

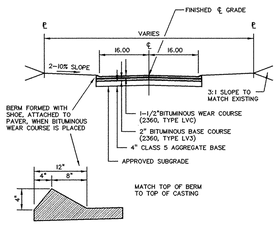

STREET SECTION WITH INTEGRAL BITUMINOUS BERM

30 LF 30" CMP
IE=932.75
IE=932.50

(REPLACED CONTRACT ADDENDUM NO. 1)
30" CMP
IE 933.28
30" CMP
IE 934.28

CB 102
RE=~~940.90~~ 941.29
IE=~~937.84~~ 937.93
30 LF 12" RCP
@ ~~1.00%~~ 2.43%

CB 103

MH 100

MH 101

~~53~~ ~~67~~ LF 18" RCP
@ ~~0.61%~~ 1.02%

215TH COURT

TEL PED
EX. IE 941.72
EX. 24" CMP
EX. IE 942.03

~~IE 941.50~~ 941.89
REPLACE EXISTING 15" CMP WITH ~~63~~ LF 24" CMP.
50
~~IE 941.80~~ 941.99

STOP SIGN, STREET SIGN & "NO OUTLET" SIGN. SEE DETAIL THIS SHEET.

Block 5

1

4

6

FES
IE=~~934.0~~
934.03

NURP POND NO. 1

FES
IE=~~932.0~~
932.08

12" DIP PIPE
IE=~~932.0~~
932.04

MH 104

SHEET 6 DETAIL

County Road No. 32

Meadowvale Rd (Hs pen Elk River Standard)
215th COURT
Yellow–Black "NO OUTLET" Sign

Meadowvale Rd (Hs pen Elk River Standard)
215th COURT
YELLOW–BLACK "NO OUTLET" SIGN
2'
STOP
RI–R (STOP)
NOT LESS THAN 8'
4'
12"

N
50

RECORD DRAWING

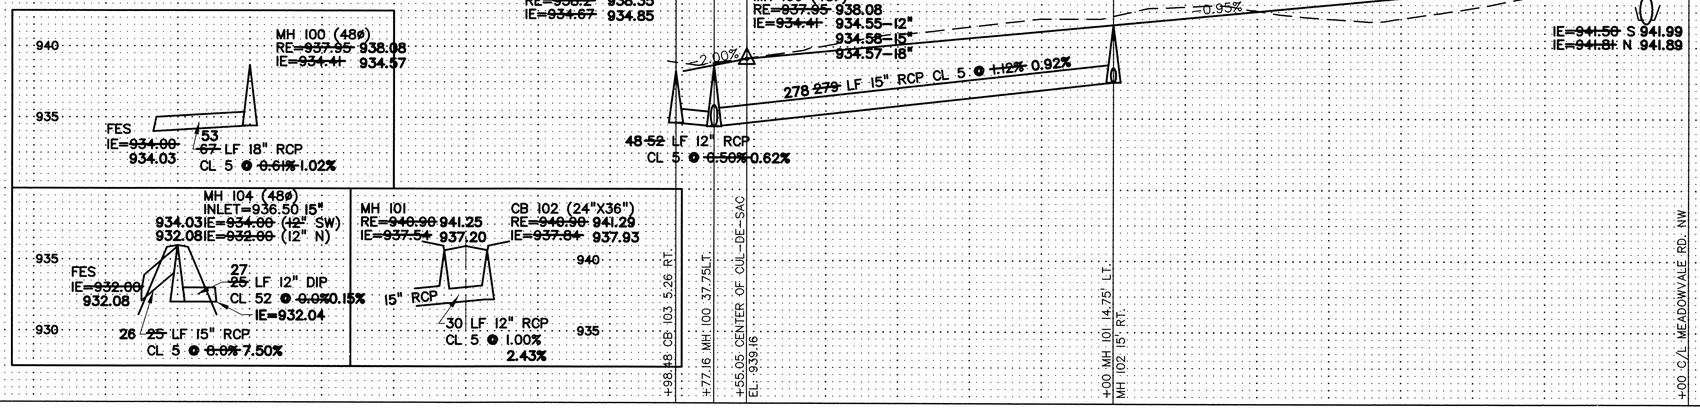

CONTRACTORS:
PRIMARY: WEST BRANCH CONST
SUBS: KUECHLE UNDERGROUND
BAUERLY BROS.

REV NO.	DATE	DESCRIPTION
1	01/16/06	CITY COMMENTS
2	01/27/06	CITY COMMENTS
3	02/16/06	CITY COMMENTS
4	08/28/06	ASBUILT

DATE: 12/22/05
DESIGN BY: MCB
DRAWN BY: ERW
CHECKED BY: MCB
DWG FILE: PUTIL_DWG
TEXT FILE: NONE
FILE NO.: 6635.22–03

I hereby certify that this plan, specification, or report was prepared by me or under my direct supervision and that I am a duly Licensed Professional Engineer under State of Minnesota Statutes Sections 326.02–326.15.

Signature: Daniel C. Arendt, PE
Date: 12/22/2005 Lic. No. 42661

John Oliver & Associates, Inc.
Civil Engineering, Land Surveying, Land Planning
580 Dodge Avenue
Elk River, Minnesota 55330
763–441–2072 FAX 763–441–5665
Offices in: Elk River, Burnsville, Brooklyn Center & St. Cloud, Minnesota

THE MEADOWS OF ELK RIVER
ELK RIVER, MN
FOR
AULIK AND ASSOCIATES INC.
FINAL UTILITY PLAN

SHEET NO. 3 OF 6

DRAWING NUMBER
MEADELK.06
3

SAFCO PRODUCTS • NEW HOPE, MINNESOTA
RECREATED BY PART NUMBER 65502
PRINTED EDGE OF PAPER ON THIS LINE