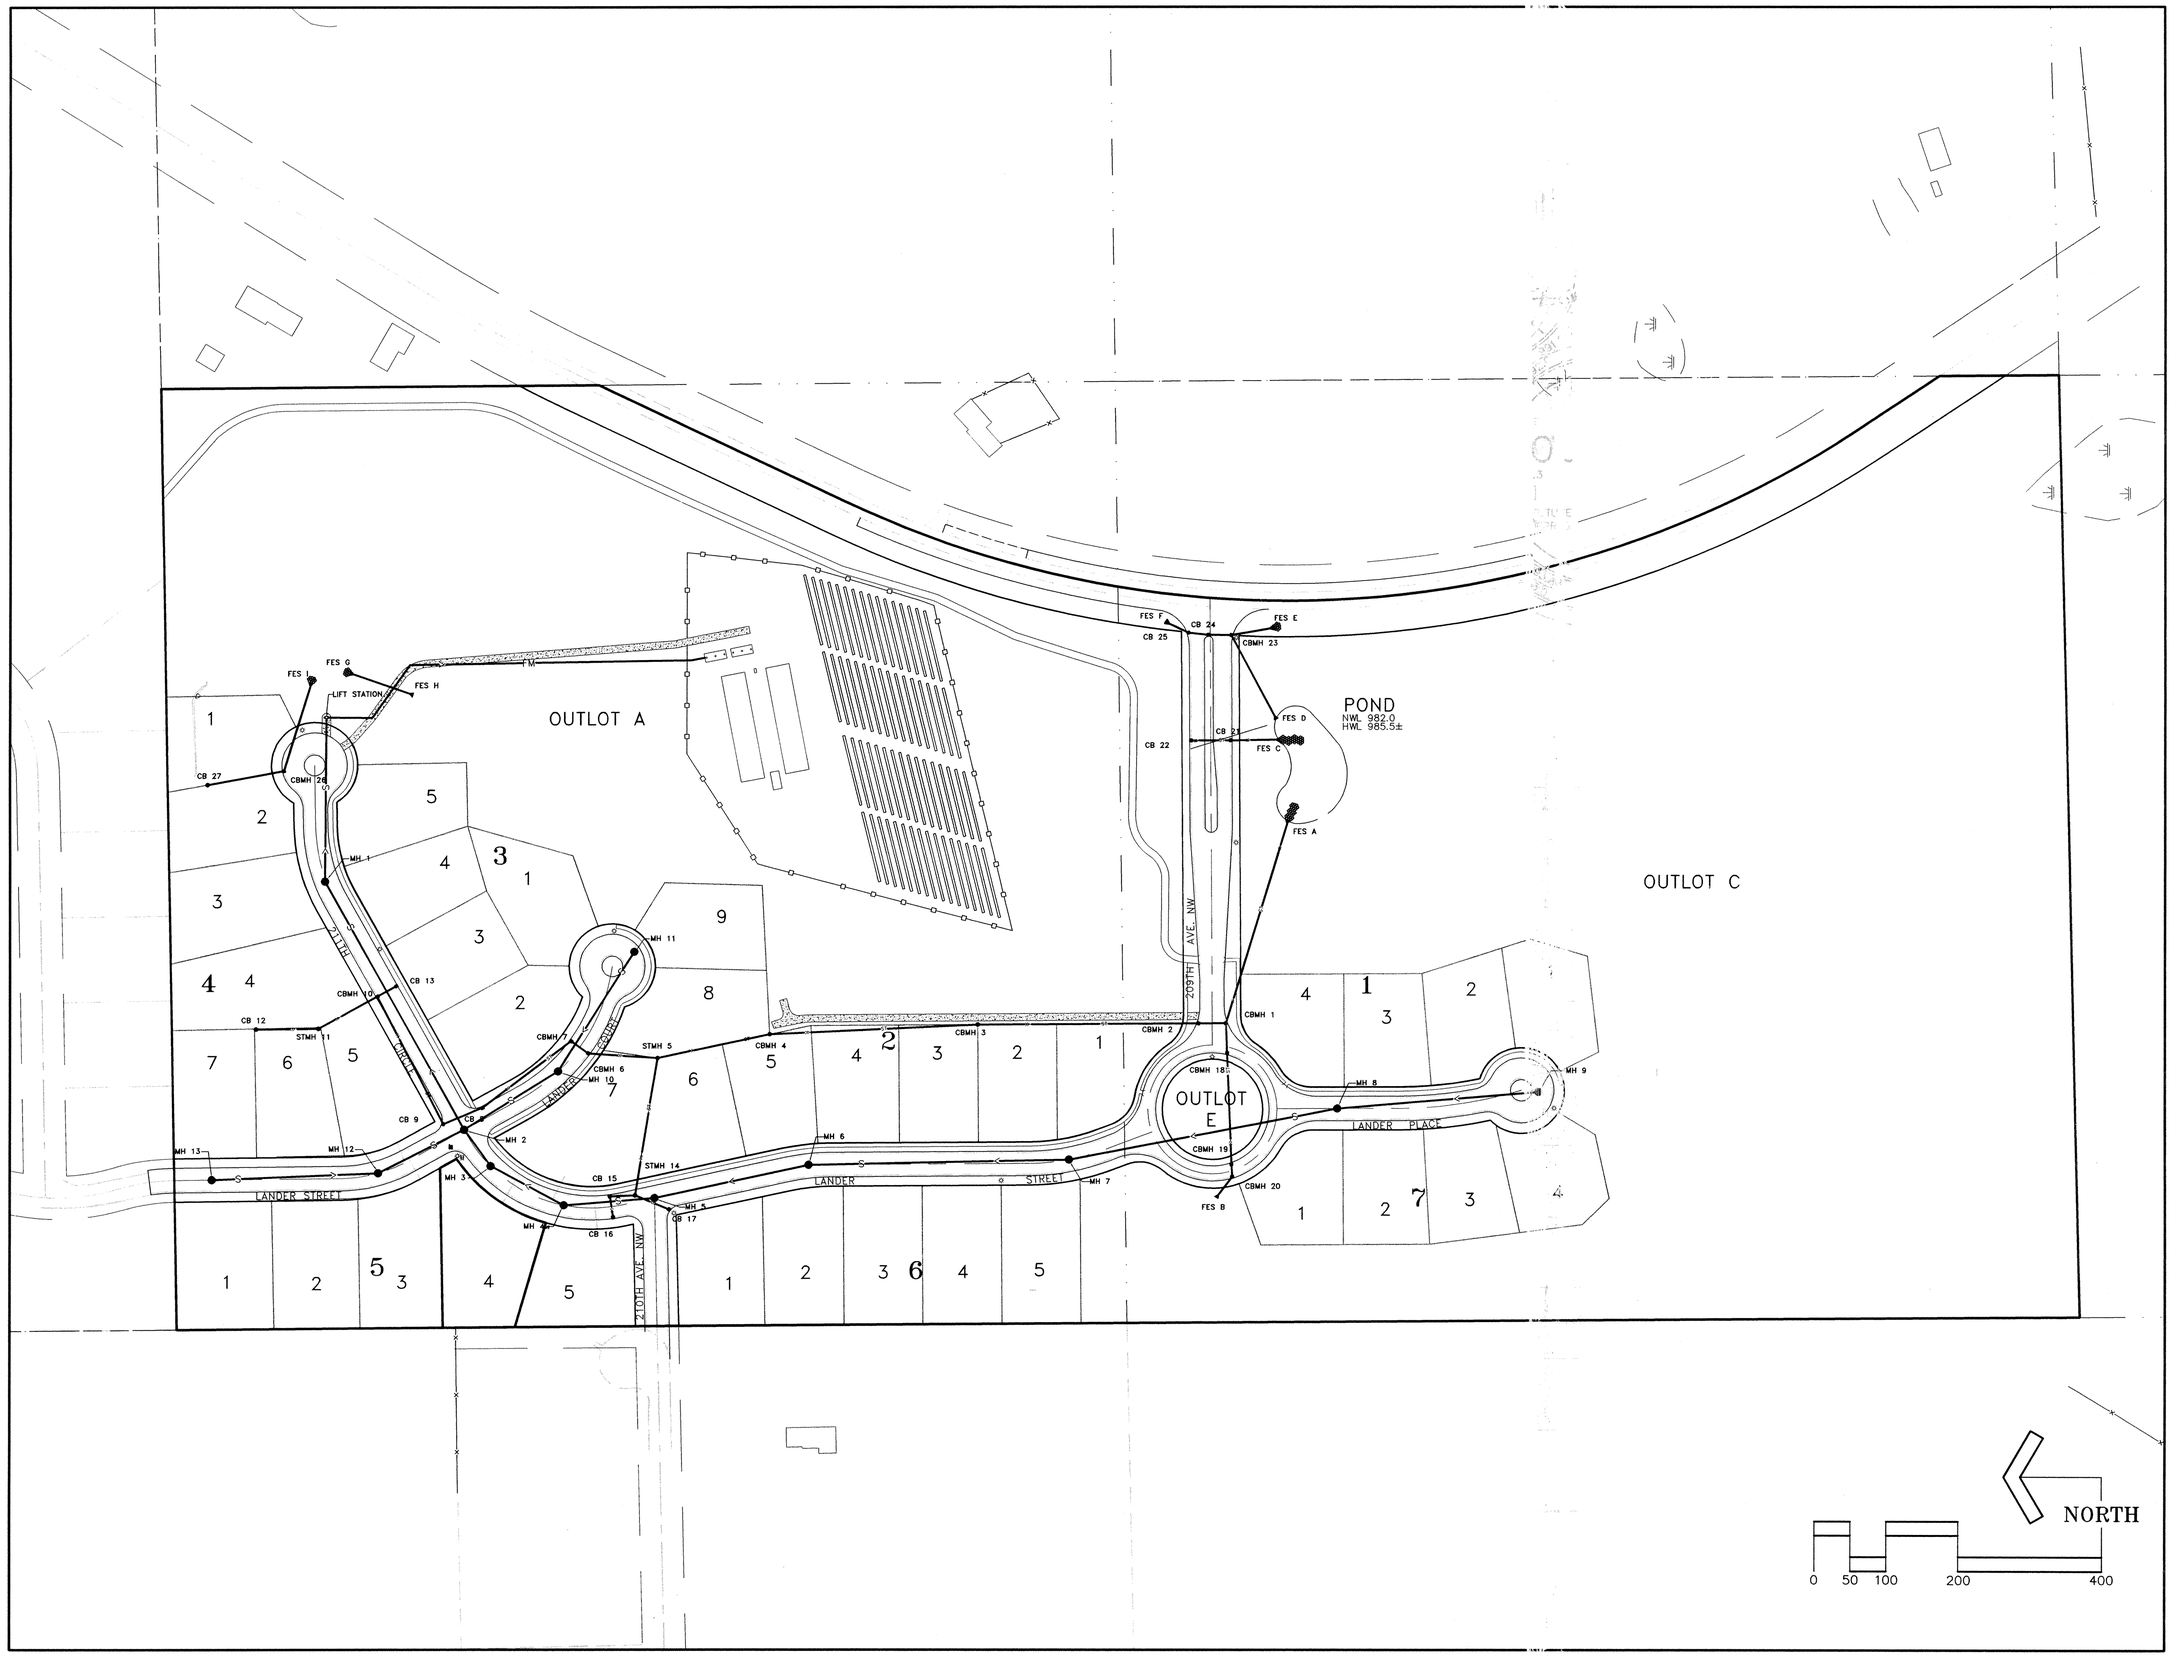

Engineering • Planning • Surveying

MFRA
McCombs Frank Roos Associates, Inc.

15050 23rd Avenue North • Plymouth, Minnesota • 55447
phone 763/476-6010 • fax 763/476-8532
E-Mail: mfra@mfra.com

Client

Lyman Development
Excelsior, MN

Project

Meadowwoods Village
Elk River, MN

Sheet Title

Site Development Plan

I hereby certify that this plan was prepared by me or under my direct supervision and that I am a duly Registered Professional Engineer under the laws of the State of Minnesota.

Name Paul Pearson — Paul Pearson
Date 03/14/01
Registration Number 12795

Designed	PWP	Checked	PWP
Drawn	JHB	Approved	
Date	03/14/01		

Revisions

No.	Date	By	Remarks
A	1/06/05	MRJ	RECORD PLAN REVISIONS

Sheet 2/17 **Revision** A

MFRA FILE NO.: 12896