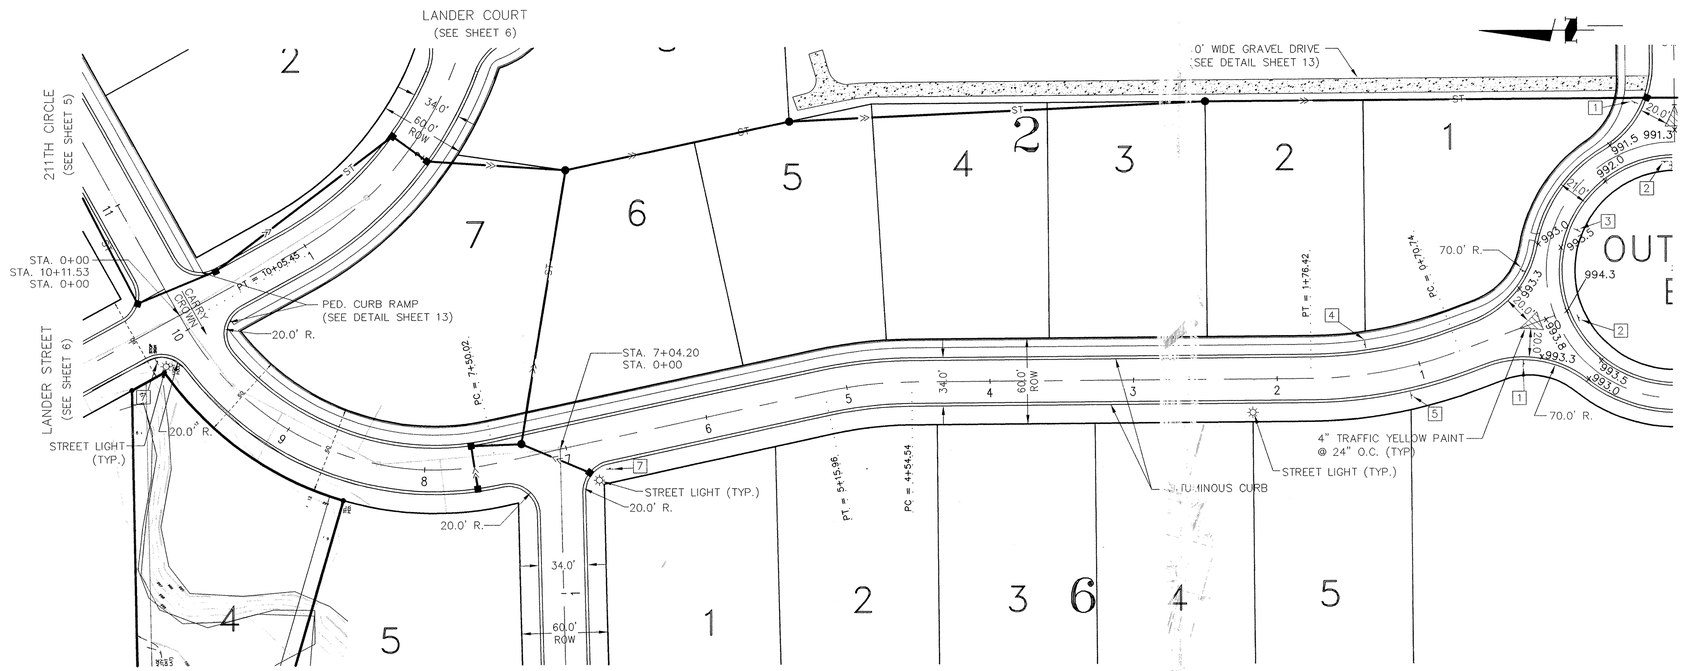

LANDER STREET

SIGN DETAILS:

1. BEGIN ONE WAY SIGN (R6-X1)
2. ONE WAY SIGN (R6-1, R)
3. DO NOT ENTER SIGN (R5-1)
   WRONG WAY SIGN (R5-1A)
4. END ONE WAY SIGN (R6-X1)
5. ROUNDABOUT WARNING SIGN (W2-7)
6. STOP SIGN (R1-1) (30" X 30") (NOT USED)
7. STREET SIGN

NOTE:
ALL DIMENSIONS ARE TO BACK EDGE OF PAVEMENT UNLESS NOTED OTHERWISE.

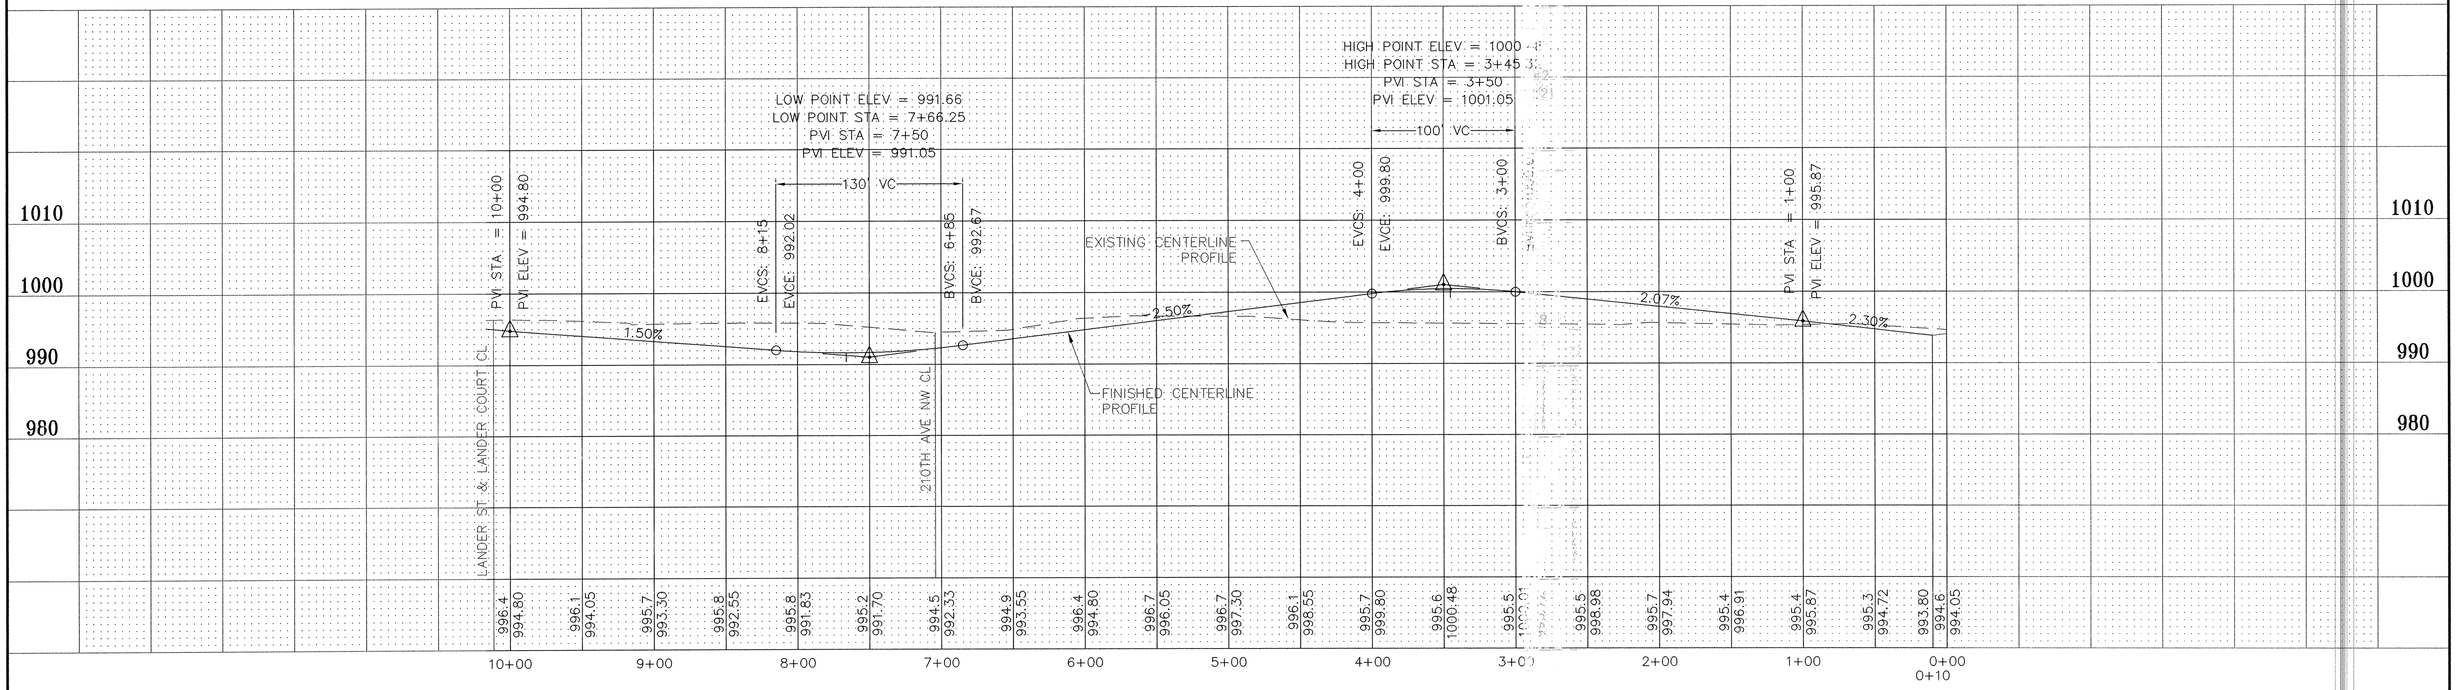

RECORD PLAN

Revisions

No.	Date	By	Remarks
A	3/13/01	JHB	Add street signs
B	1/06/05	MRJ	RECORD PLAN REVISIONS

I hereby certify that this plan was prepared by me or under my direct supervision and that I am a duly Registered Professional Engineer under the laws of the State of Minnesota.

Name Paul Pearson — Paul Pearson
Date 03/14/01
Registration Number 12795

Scale 1"=10' VERT, 1"=50' HORIZ
Designed PWP
Drawn JHB
Date 03/14/01
Checked PWP
Approved

MFRA
McCombs Frank Roos Associates, Inc.
Engineering • Planning • Surveying
15050 23rd Avenue North • Plymouth, Minnesota • 55447
phone 612/476-6010 • fax 612/476-8532
E-Mail: cadd@mfra.com

Client
Lyman Development
Excelsior, MN

Project
Meadowwoods Village
Elk River, MN

Sheet Title
Street Plan & Profile
Lander Street

Sheet 4/17 **Revision** B

MFRA FILE NO.: 12896