NOTE:
ALL SANITARY SEWER SHALL BE PVC ASTM 3034, SDR 35 UNLESS OTHERWISE INDICATED.

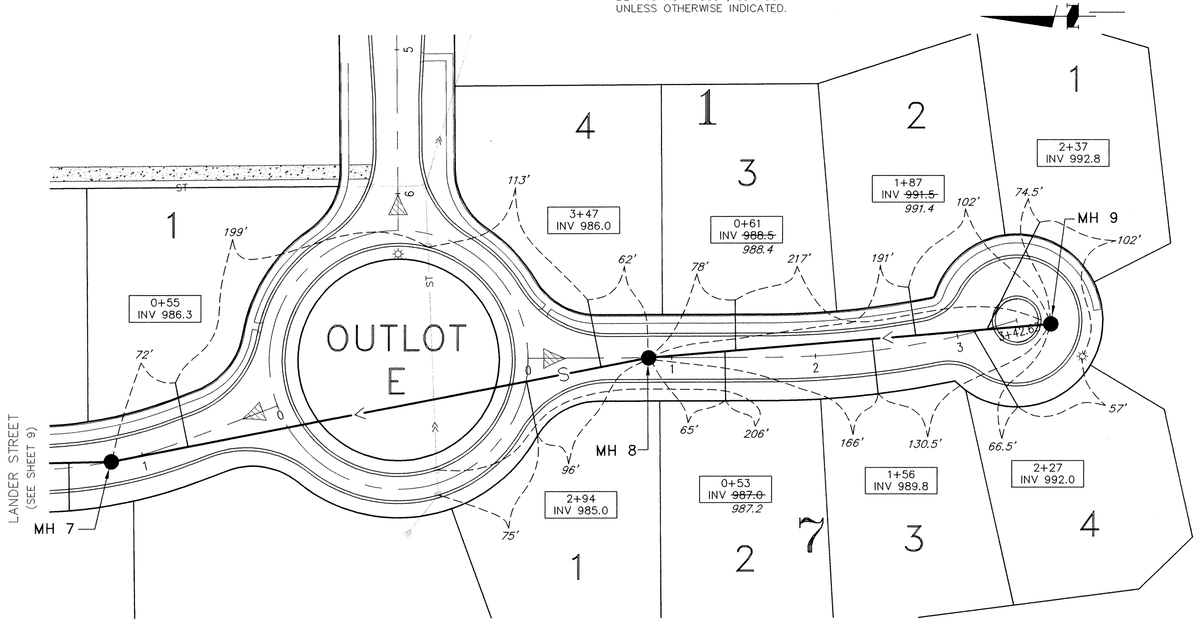

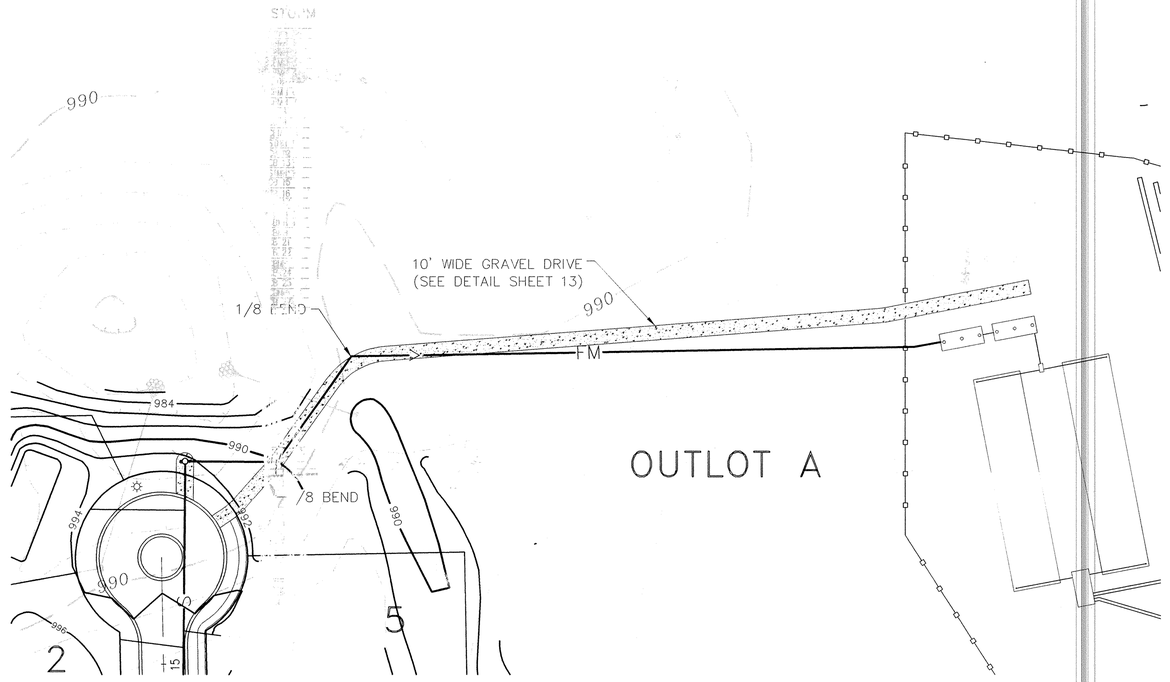

LANDER PLACE

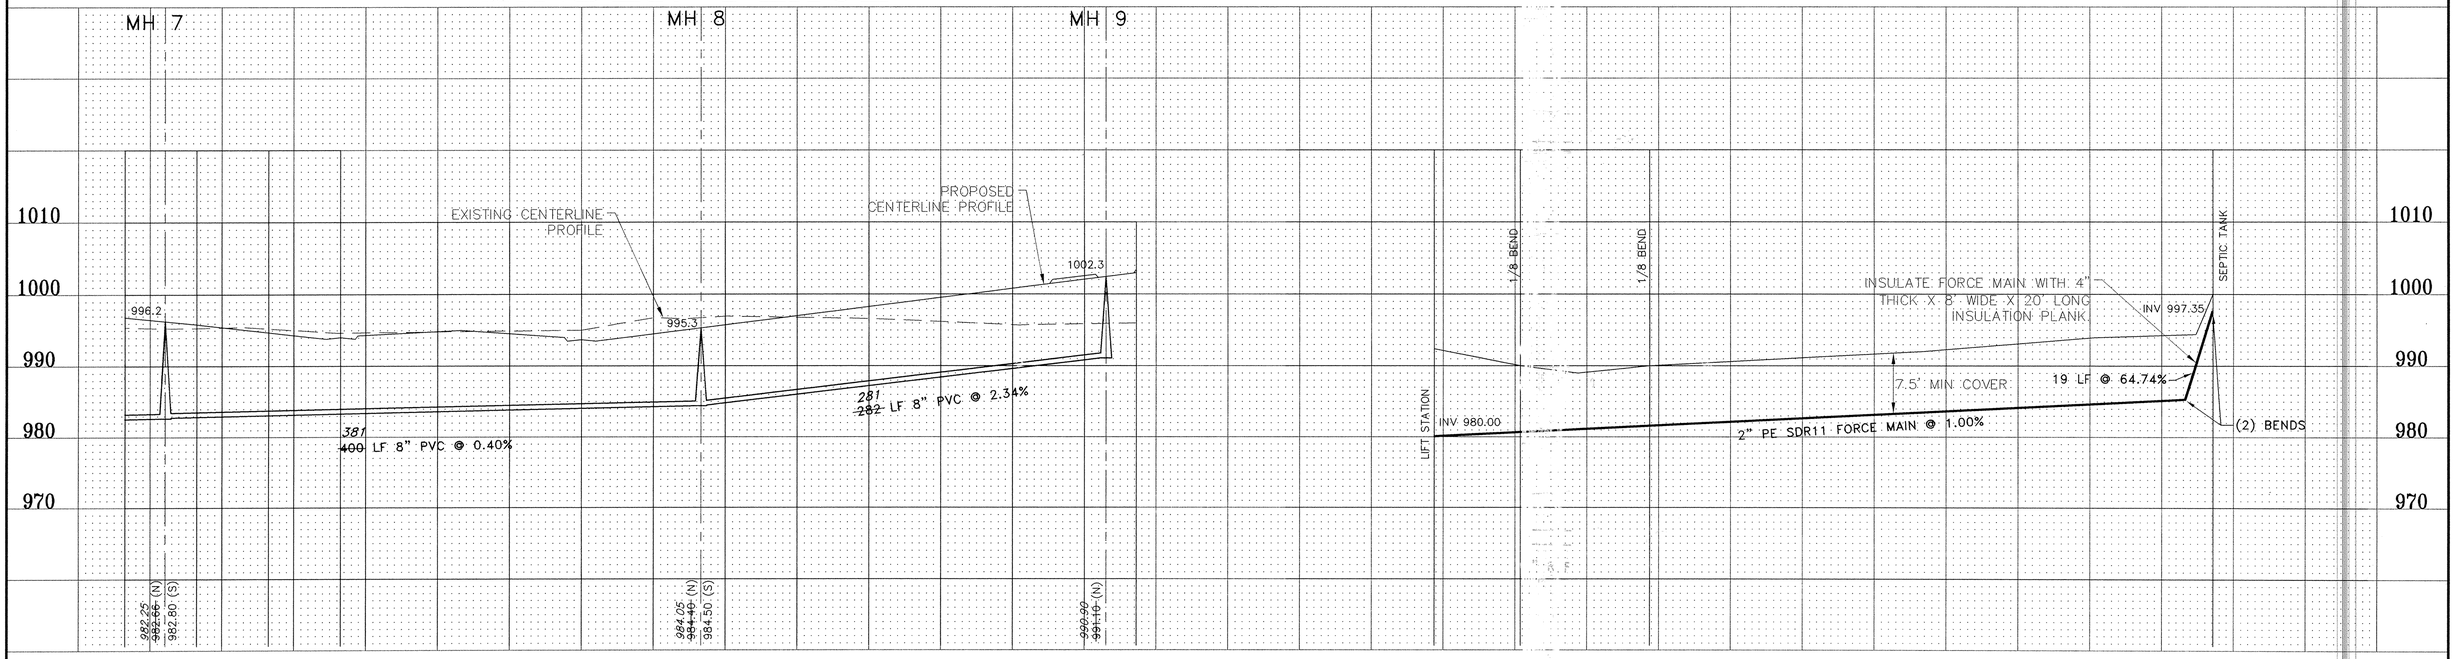

RECORD PLAN

Revisions

No.	Date	By	Remarks
A	1/06/05	MRJ	RECORD PLAN REVISIONS

I hereby certify that this plan was prepared by me or under my direct supervision and that I am a duly Registered Professional Engineer under the laws of the State of Minnesota.

Name Paul Pearson — Paul Pearson
Date 03/14/01
Registration Number 12795

Scale	1"=10' VERT, 1"=50' HORIZ
Designed	PWP
Drawn	JHB
Date	03/14/01
Checked	PWP
Approved	

MFRA
McCombs Frank Roos Associates, Inc.
Engineering • Planning • Surveying
15050 23rd Avenue North • Plymouth, Minnesota • 55447
phone 612/476-6010 • fax 612/476-8532
E-Mail: cadd@mfra.com

Client
Lyman Development
Excelsior, MN

Project
Meadowwoods Village
Elk River, MN

Sheet Title
Sanitary Sewer Plan & Profile
LANDER PLACE

Sheet 10/17 **Revision** A

MFRA FILE NO.: 12896