


SAICO PRODUCTS • NEW HOPK, MINNESOTA
PROJECT NO. 230-208
MEADOWS 95
5

ELGIN DRIVE

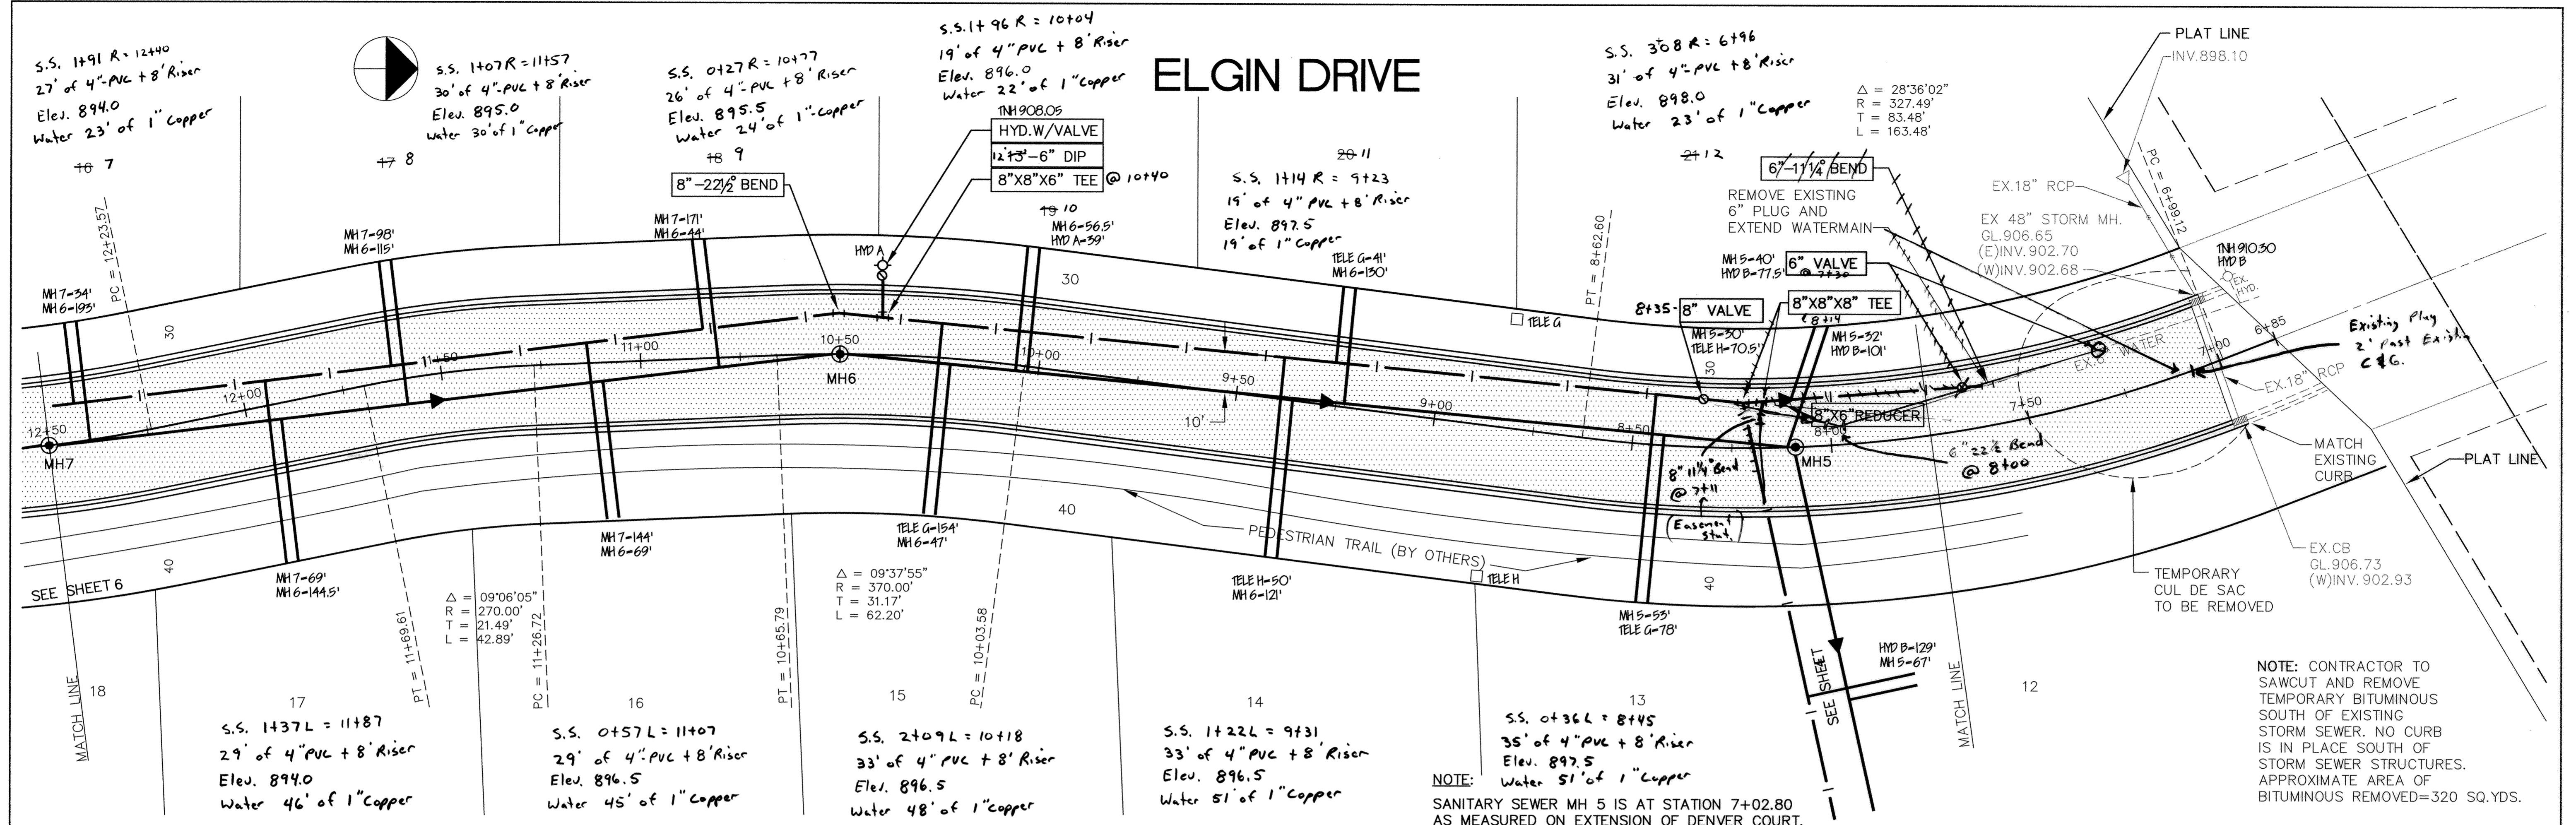

13	12	11
----	----	----

I HEREBY CERTIFY THAT THIS PLAN, SPECIFICATION, OR REPORT WAS PREPARED BY ME OR UNDER MY DIRECT SUPERVISION AND THAT I AM A DULY REGISTERED PROFESSIONAL ENGINEER UNDER THE LAWS OF THE STATE OF MINNESOTA.

Mark V. Graham
DATE 2/10/95 REG. NO. 19130

MSA
CONSULTING ENGINEERS

1326 ENERGY PARK DRIVE
ST. PAUL, MINNESOTA 55108
(612) 644-4389

9800 SHELARD PARKWAY
MINNEAPOLIS, MINNESOTA 55441
(612) 546-0432

REVISIONS	DATE	DESCRIPTION	DESIGNED	CHECKED	DRAWN
1	2/95	ADDED 6" VALVE AT STATION 7+60±	MVG	RB	IC

CITY OF ELK RIVER
STREET AND UTILITY IMPROVEMENTS
ELGIN DRIVE

DATE FEB. 1994 SHEET 5 OF 13 SHEETS PROJECT NO. 230-208