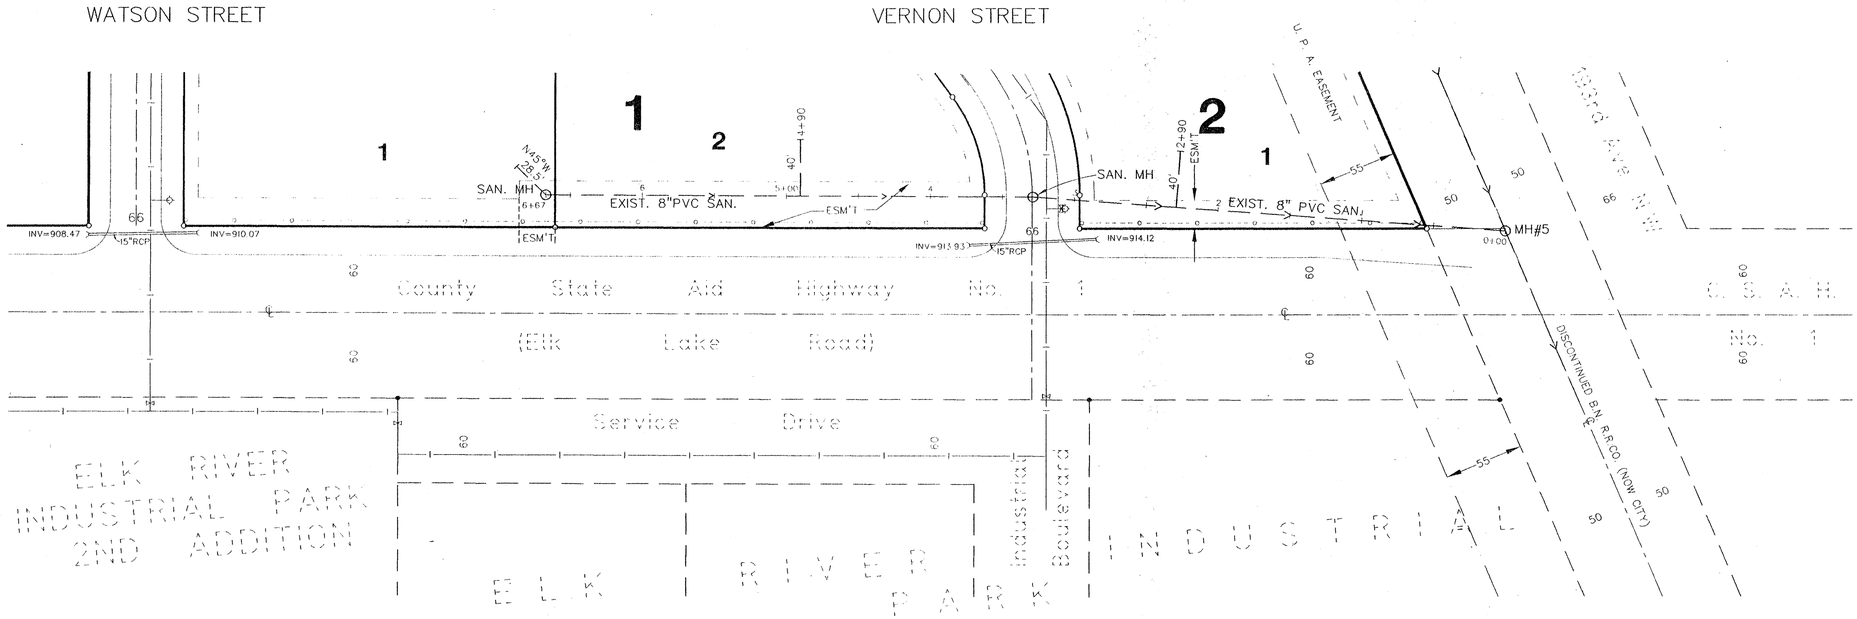

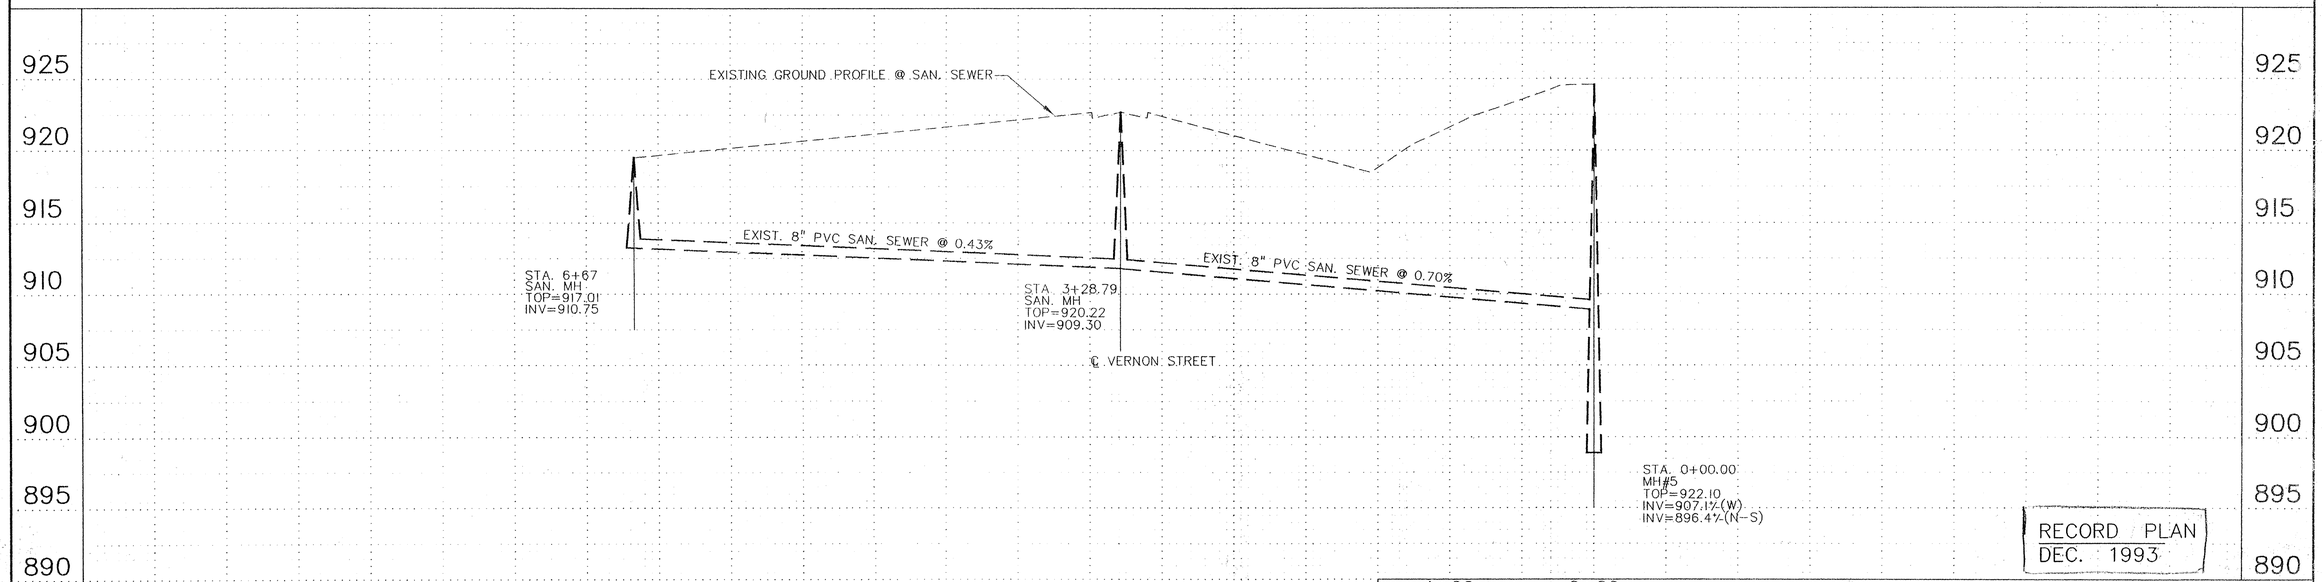

RECORD PLAN
DEC. 1993

ORIG. DATE: 11/2/93
DESIGN BY: GL
DRAWN BY: GL/SF
CHECKED BY: JBK
REVISIONS:

I HEREBY CERTIFY THAT THIS PLAN, SPECIFICATION, OR REPORT WAS PREPARED BY ME OR UNDER MY DIRECT SUPERVISION AND THAT I AM A DULY REGISTERED ENGINEER UNDER THE STATE OF MINNESOTA STATUTES SECTIONS 326.02 TO 326.16.
SIGNED:
DATE: 11/2/93 REG. NO. 19900

John Oliver & Associates, inc.
580 Dodge Avenue
Elk River, Minnesota
(612)441-2072 (FAX)441-5665
Civil Engineering, Land Surveying, Land Planning

SAP No.

MEADOWVALE COMMERCIAL PARK
EXISTING SANITARY SEWER PROFILE

SHEET 1 OF 1 FILE NO. 3055.1