PUBLIC IMPROVEMENTS

MEADOWVALE OAKS

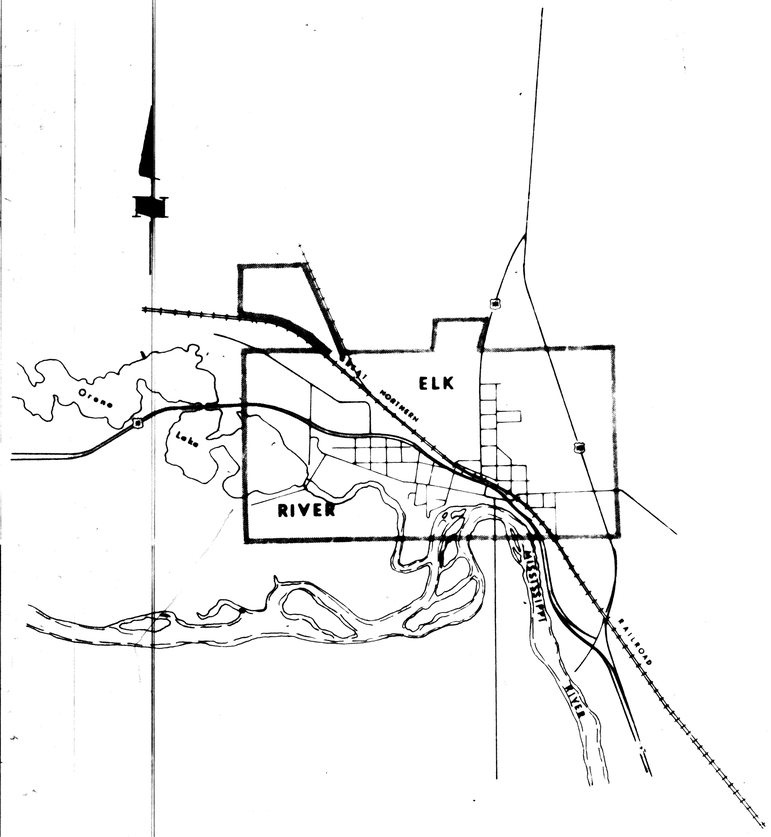

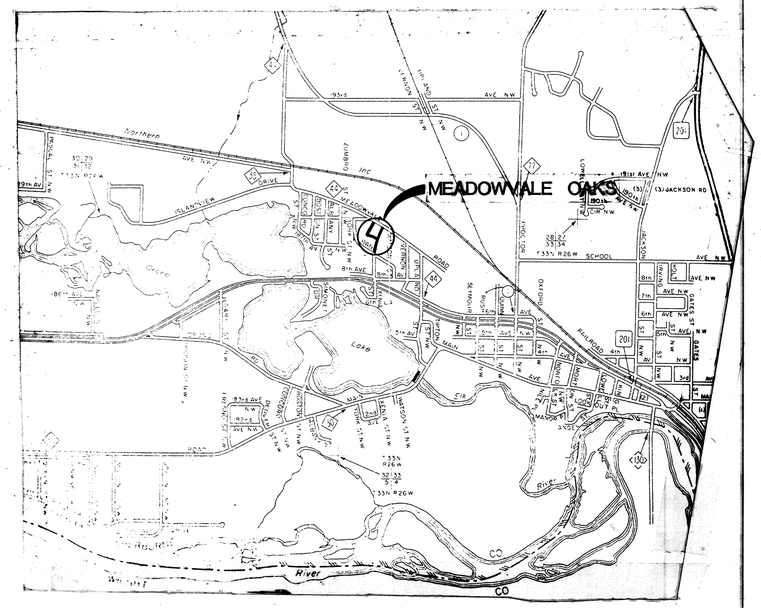

CITY OF ELK RIVER

consulting engineers diversified inc.

PO Box J, Osseo, Minnesota 55369

I hereby certify that this plan, specification or report was prepared by me or under my direct supervision and that I am a duly Registered Professional Engineer under State of Minnesota Statutes Sections 326.02 to 326.16

Date July 1979 Minnesota Registration No. 10206

AS-BUILT Date 9/9/80

DRAWN BY: MRF Date 9/9/80

CHECKED BY:

Meadowvale Oaks
1979
Dy 4-6

DRAWING NUMBER

DRAWING NUMBER

DRAWING NUMBER
1
MEADO79

SAFCO PRODUCTS • NEW HOPE, MINNESOTA
REORDER BY PART NUMBER 63053
POSITION EDGE OF PRINT ON THIS LINE