FORMER BURLINGTON NORTHERN RAILWAY

NOTE:
INSTALL SILT FENCE AS DIRECTED BY THE ENGINEER IN THE FIELD PRIOR TO CONSTRUCTION.

CLEAR & GRUB TREES AS DIRECTED BY THE ENGINEER IN THE FIELD

EXISTING FENCE TO BE REMOVED & REINSTALLED AS NECESSARY AND SHALL BE INCIDENTAL TO SANITARY SEWER CONSTRUCTION.

12" 22 1/2° BEND

12"X12"X8" TEE

CLEAR & GRUB TREES AS DIRECTED BY THE ENGINEER IN THE FIELD

CLEAR & GRUB TREES AS DIRECTED BY THE ENGINEER IN THE FIELD

WOODED

2 7" TREES

24" TREES

6" TREE ROW

1" TREE

6" TREE ROW

2 4" TREE

8" TREE

GRAV. ROAD

193RD STREET

24" TREE

12" TREES

5 4" TREES

24" TREE

3 4" TREES

2 4" TREES

GRAV. ROAD

C.S.A.H. NO. 1

PT = 4+53.34

SEE SHEET 5

SEE SHEET 3

MH#8

MH#7

MH#6

MH#5

MH#4

20+00 25+00 24+00 23+00 22+00 21+00 20+00 19+00 18+00 17+00 16+00 15+00 13+00 12+00 5+00 6+00 7+00 8+00 9+00

10'

8" VALVE

GRAVEL TRAIL

12" VALVE

65'

8" PLUG, INV. 910.00

PROPOSED 8" SANITARY SEWER SERVICE FROM ELEMENTARY SCHOOL (BY OTHERS)

PROPOSED 20' UTILITY EASEMENT

SEE SHEET 7

CLEAR & GRUB TREES AS DIRECTED BY THE ENGINEER IN THE FIELD

PROPOSED ELEMENTARY SCHOOL
F.F. ELEV. 918.0

8" PLUG, INV. ~~902.21~~ 901.64
INSTALL 8/11/92

GRAVEL ROAD

BITUMINOUS ROAD

50' OPEN CUT C.S.A.H. NO. 1
(SEE SHEET 9 FOR STREET RESTORATION)

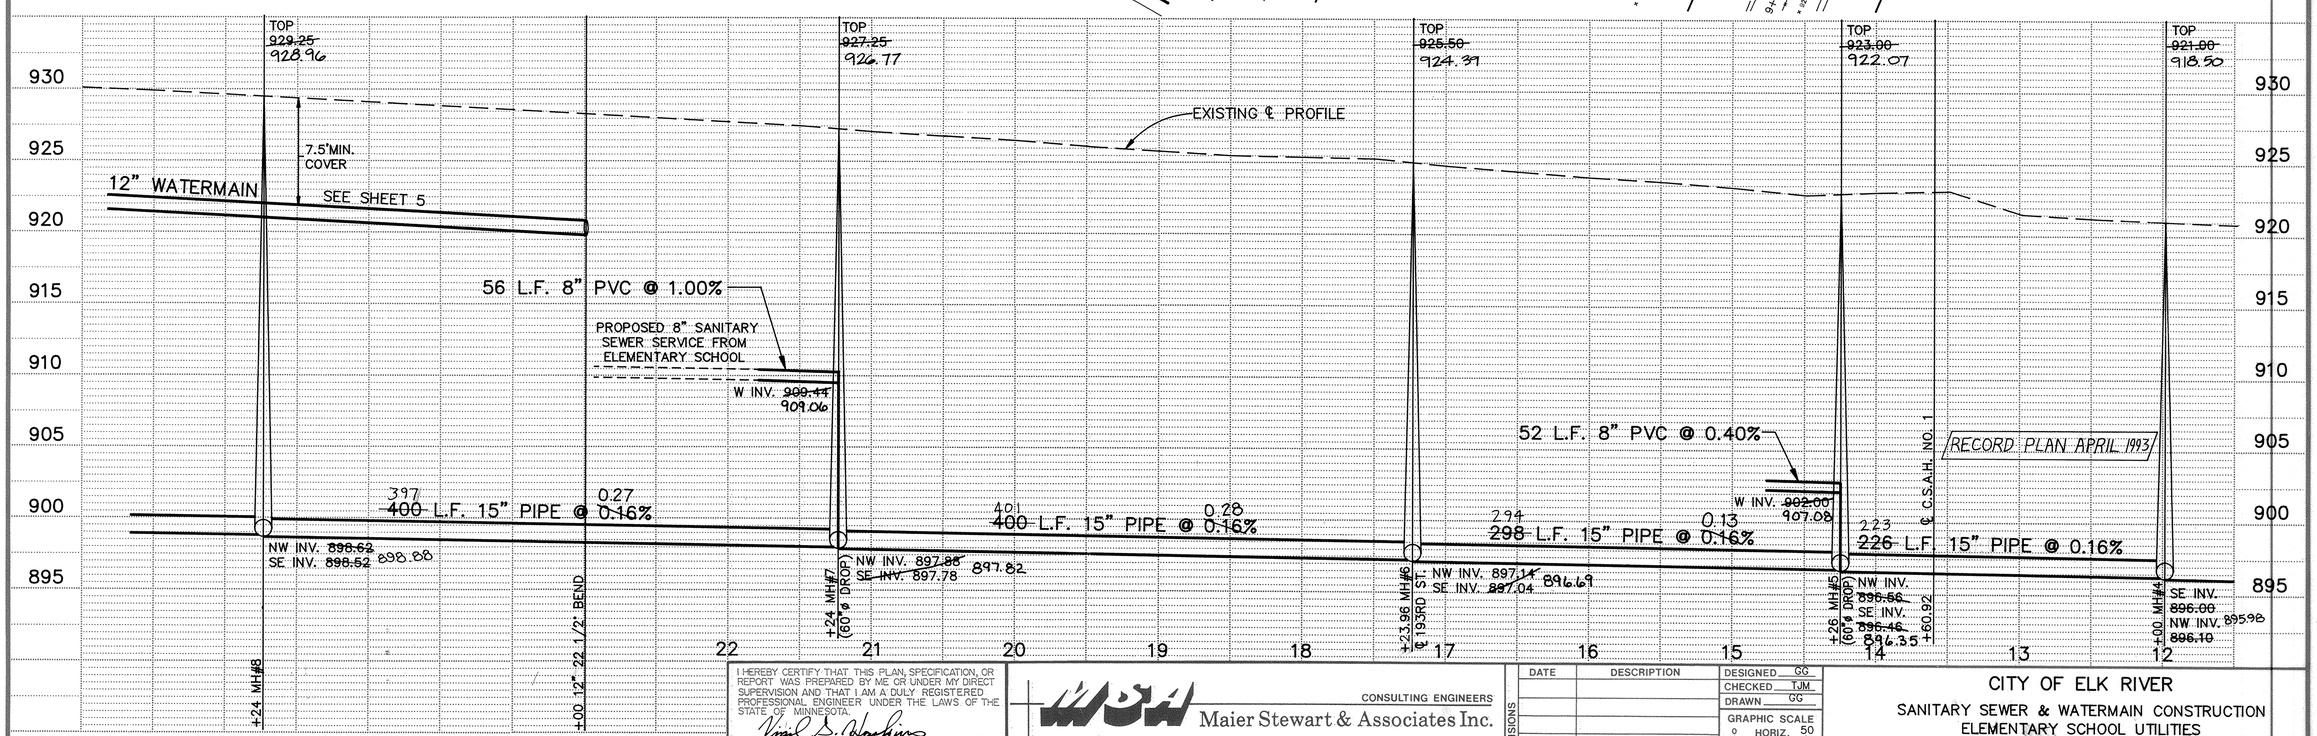

I HEREBY CERTIFY THAT THIS PLAN, SPECIFICATION, OR REPORT WAS PREPARED BY ME OR UNDER MY DIRECT SUPERVISION AND THAT I AM A DULY REGISTERED PROFESSIONAL ENGINEER UNDER THE LAWS OF THE STATE OF MINNESOTA.

Virgil S. Hawkins

DATE 9/12/91 REG. NO. 19941

CONSULTING ENGINEERS
Maier Stewart & Associates Inc.
1959 SLOAN PLACE (612)774-6021 ST. PAUL, MINNESOTA 55117

REVISIONS

DATE	DESCRIPTION

DESIGNED GG
CHECKED TJM
DRAWN GG
GRAPHIC SCALE
HORIZ. 50
VERT. 5

CITY OF ELK RIVER
SANITARY SEWER & WATERMAIN CONSTRUCTION
ELEMENTARY SCHOOL UTILITIES

DATE AUG. 1991 | SHEET 4 OF 14 SHEETS | PROJECT NO. 230-125

ER125-2

539444

571

DRAWING NUMBER

DRAWING NUMBER

DRAWING NUMBER

DRAWING NUMBER MEADO.92 4