DETAIL "A"

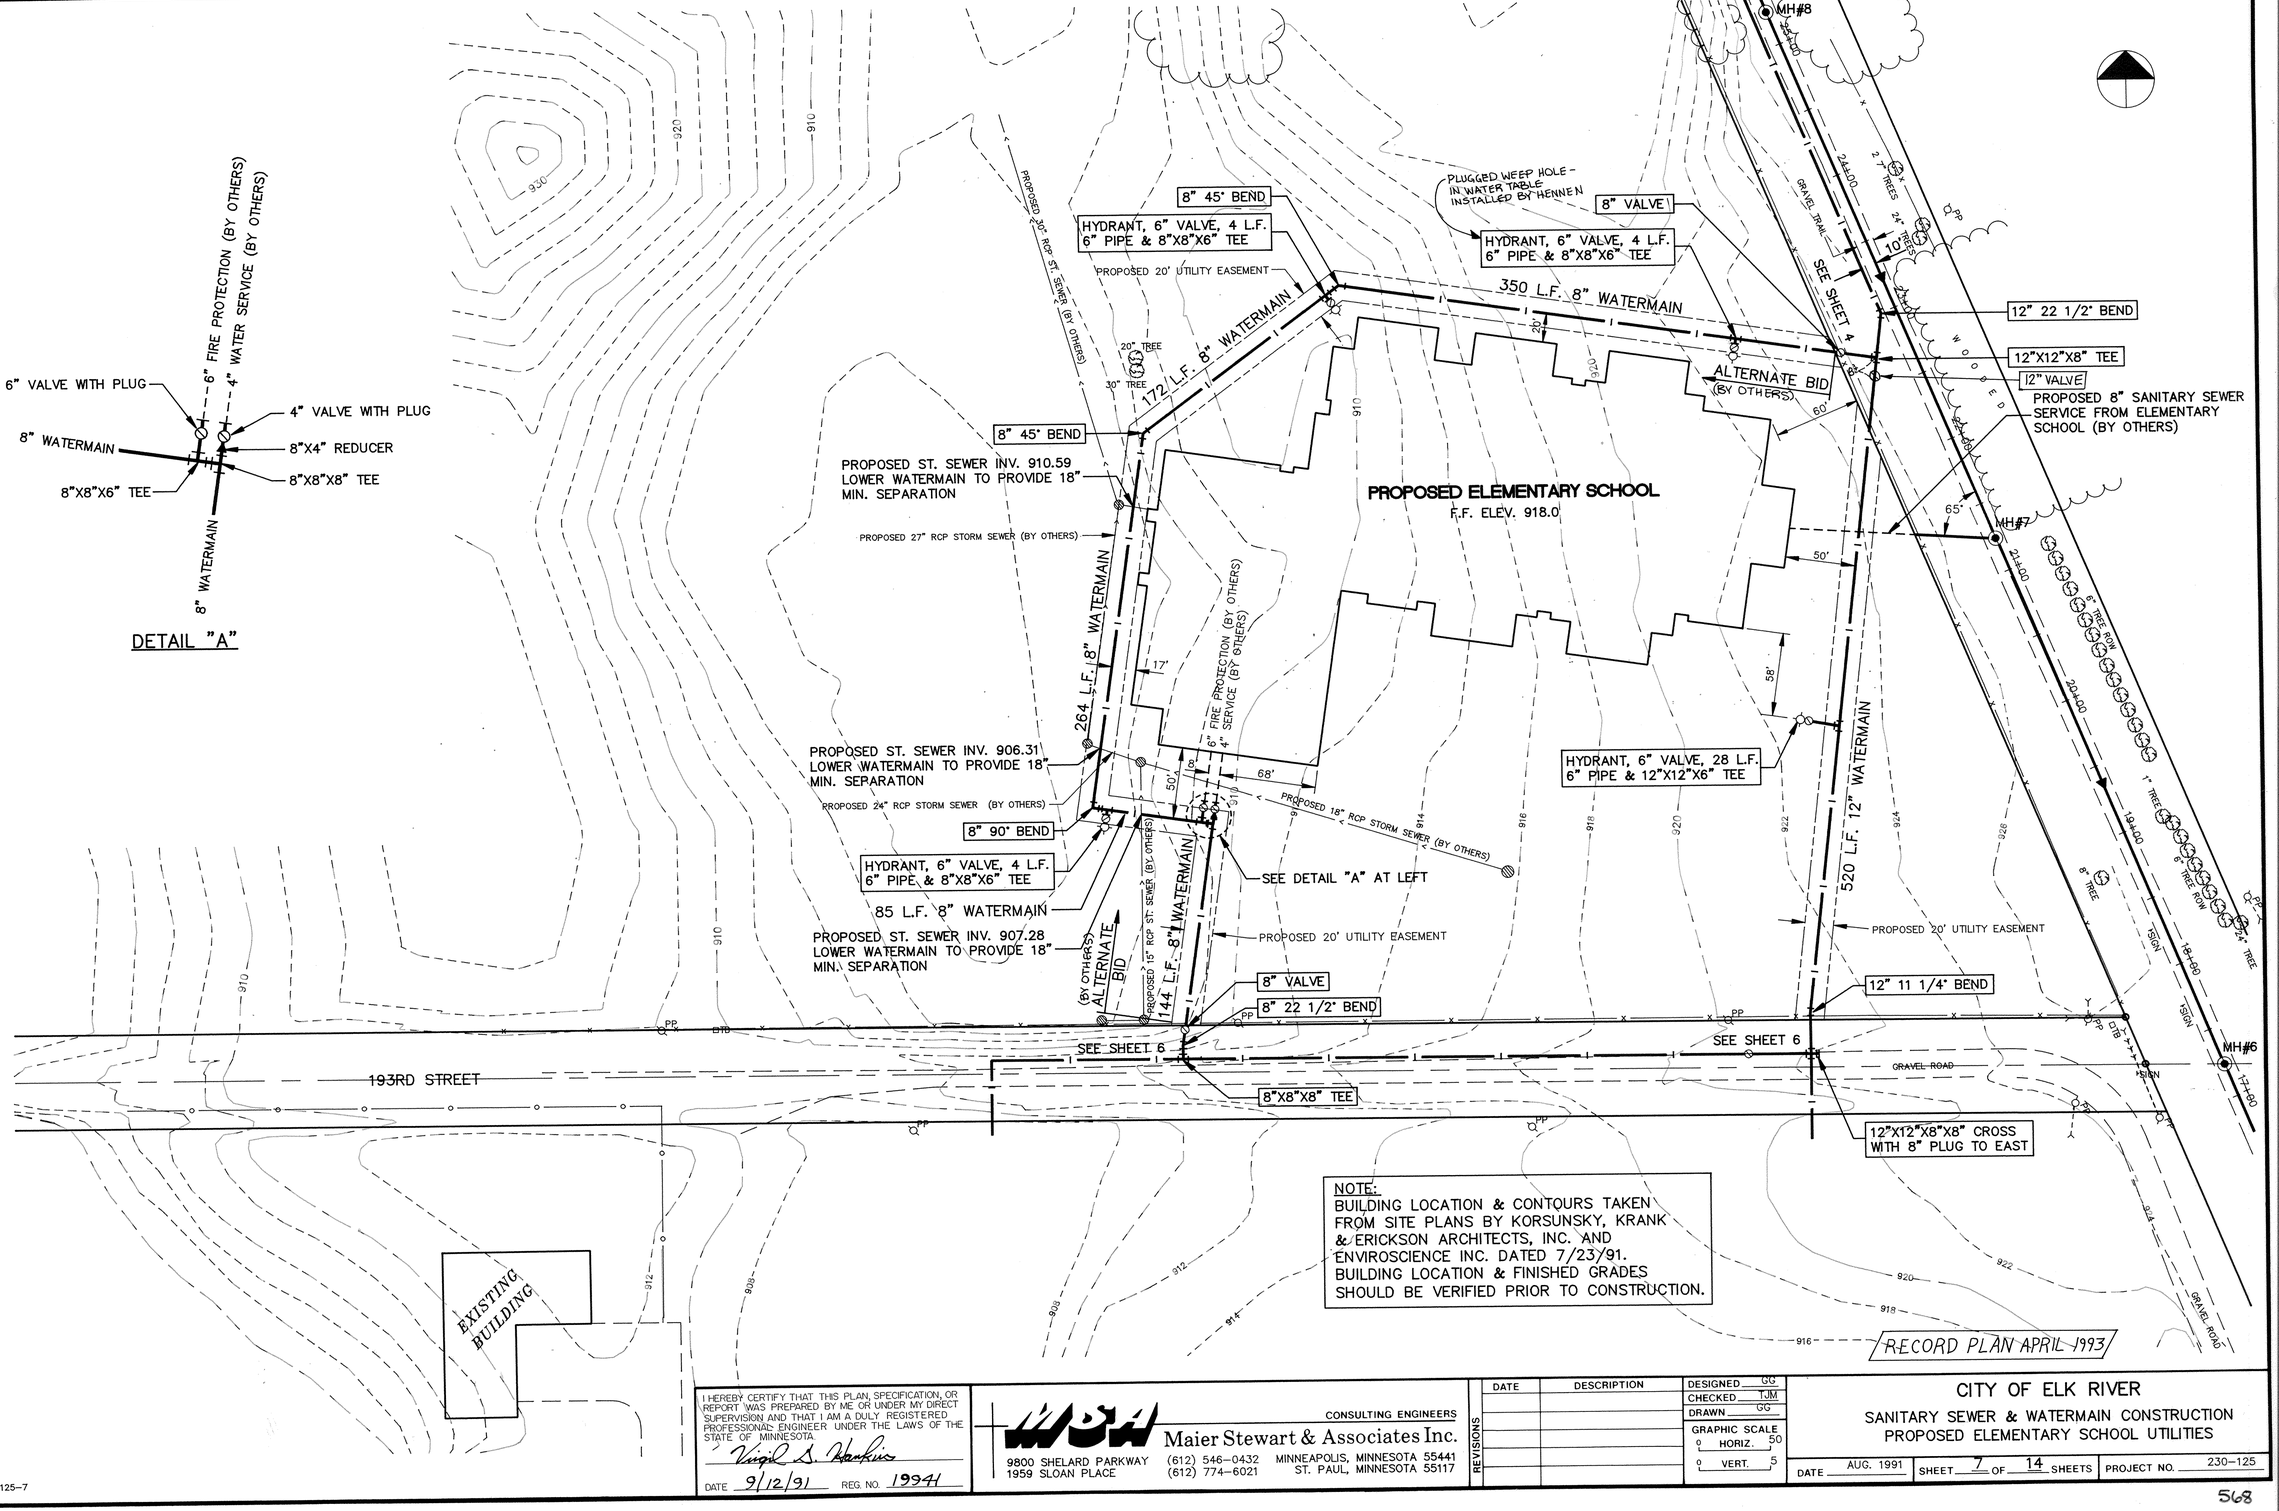

NOTE:
BUILDING LOCATION & CONTOURS TAKEN FROM SITE PLANS BY KORSUNSKY, KRANK & ERICKSON ARCHITECTS, INC. AND ENVIROSCIENCE INC. DATED 7/23/91. BUILDING LOCATION & FINISHED GRADES SHOULD BE VERIFIED PRIOR TO CONSTRUCTION.

RECORD PLAN APRIL 1993

I HEREBY CERTIFY THAT THIS PLAN, SPECIFICATION, OR REPORT WAS PREPARED BY ME OR UNDER MY DIRECT SUPERVISION AND THAT I AM A DULY REGISTERED PROFESSIONAL ENGINEER UNDER THE LAWS OF THE STATE OF MINNESOTA.
Virgil S. Hawkins
DATE 9/12/91 REG. NO. 19941

CONSULTING ENGINEERS
Maier Stewart & Associates Inc.
9800 SHELARD PARKWAY (612) 546-0432 MINNEAPOLIS, MINNESOTA 55441
1959 SLOAN PLACE (612) 774-6021 ST. PAUL, MINNESOTA 55117

REVISIONS	DATE	DESCRIPTION

DESIGNED GG
CHECKED TJM
DRAWN GG
GRAPHIC SCALE HORIZ. 50 VERT. 5

CITY OF ELK RIVER
SANITARY SEWER & WATERMAIN CONSTRUCTION
PROPOSED ELEMENTARY SCHOOL UTILITIES

DATE AUG. 1991 SHEET 7 OF 14 SHEETS PROJECT NO. 230-125

ER125-7

DRAWING NUMBER
SARCO PRODUCTS • NEW HOPE, MINNESOTA
REORDER BY PART NUMBER 6552
DRAWING NUMBER
DRAWING NUMBER MEADO.92 7