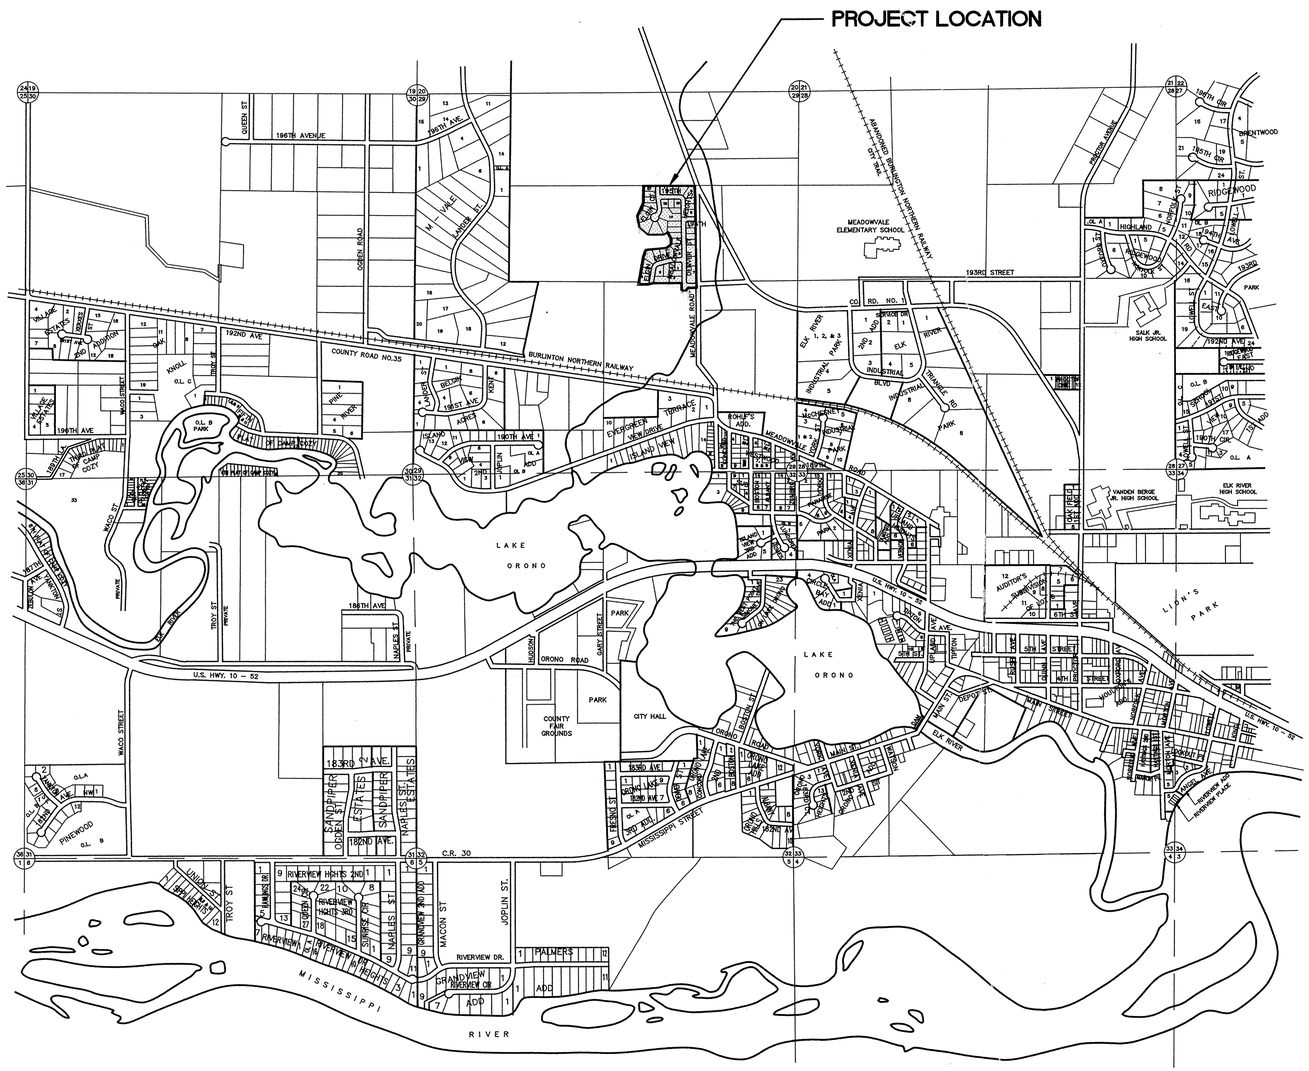

0 1 2 3 6
MILES

LOCATION MAP

MEADOWVALE HEIGHTS

GRADING, SANITARY SEWER WATERMAIN, STORM SEWER, AND STREET CONSTRUCTION

I HEREBY CERTIFY THAT THIS PLAN, SPECIFICATION, OR REPORT WAS PREPARED BY ME OR UNDER MY DIRECT SUPERVISION AND THAT I AM A DULY REGISTERED PROFESSIONAL ENGINEER UNDER THE LAWS OF THE STATE OF MINNESOTA.

Mark L. Graham

DATE 7/7/93 REG.NO. 19130

CONSULTING ENGINEERS
Maier Stewart & Associates Inc.
1959 SLOAN PLACE [612] 774-6021 ST. PAUL, MINNESOTA 55117
9800 SHELARD PARKWAY [612] 546-0432 MINNEAPOLIS, MINNESOTA 55441

PREPARED FOR:

City of Elk River

RECORD PLAN NOV,1993

ER168-T

DRAWING NUMBER
DRAWING NUMBER
DRAWING NUMBER
DRAWING NUMBER
MEADO.93
1