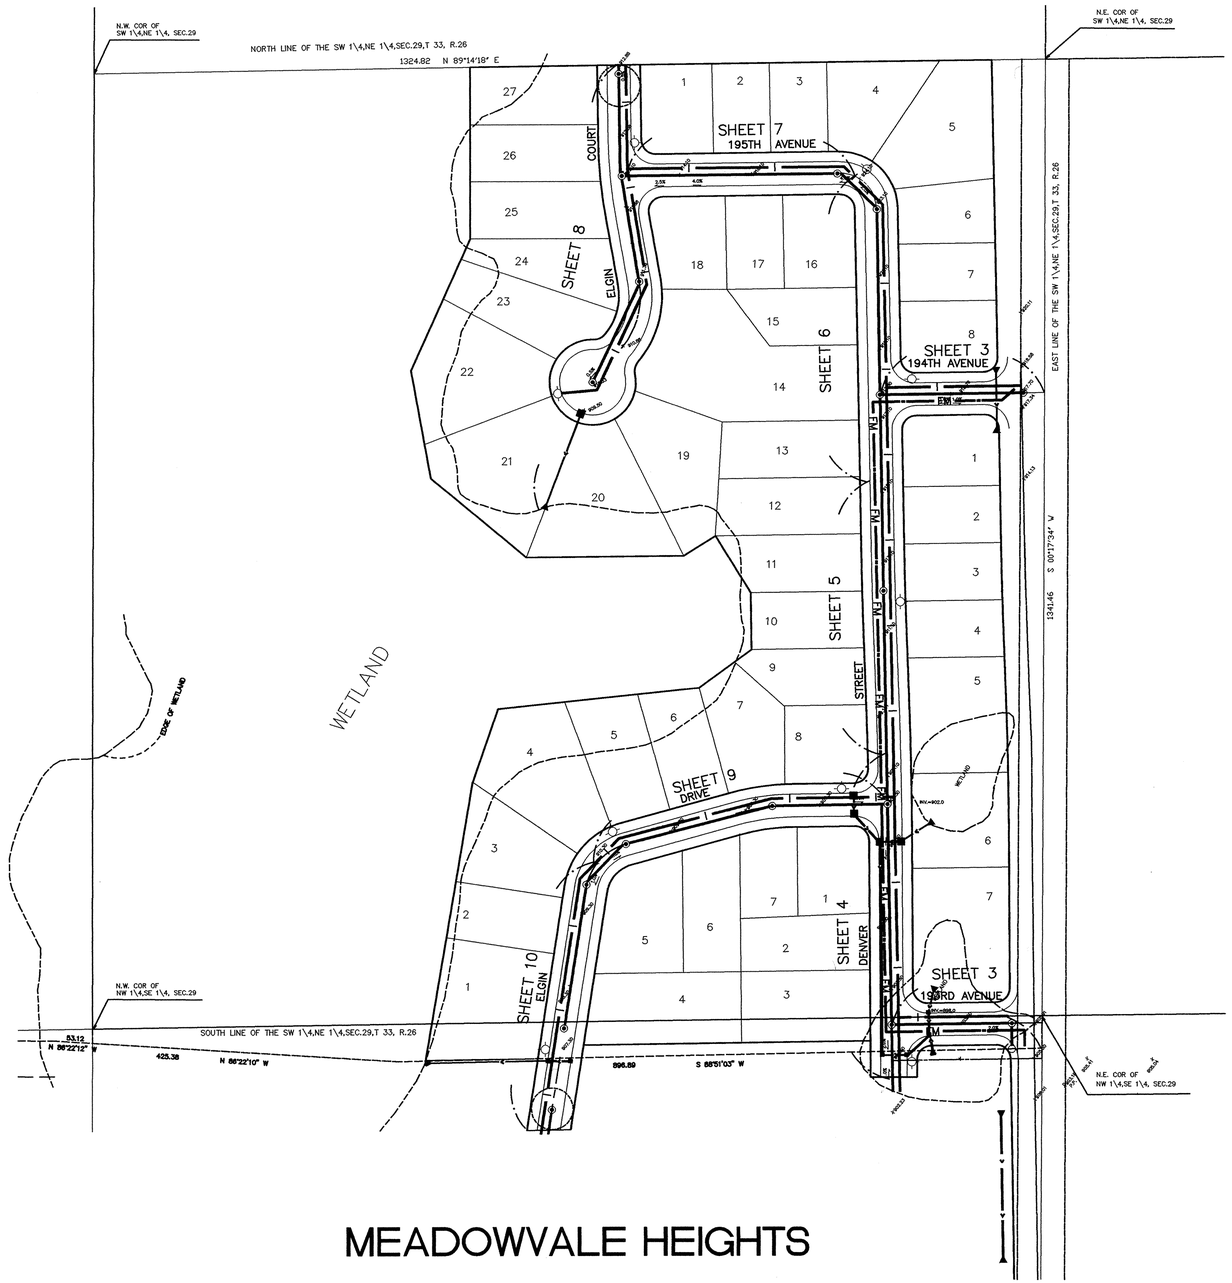

MEADOWVALE HEIGHTS

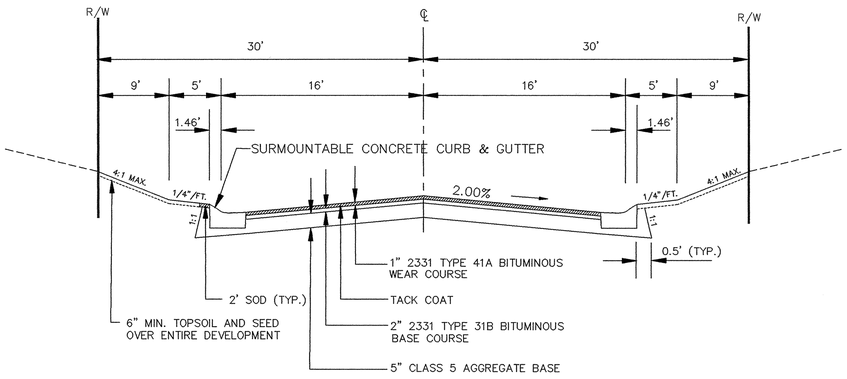

TYPICAL STREET SECTION

RECORD PLAN NOV,1993

I HEREBY CERTIFY THAT THIS PLAN, SPECIFICATION, OR REPORT WAS PREPARED BY ME OR UNDER MY DIRECT SUPERVISION AND THAT I AM A DULY REGISTERED PROFESSIONAL ENGINEER UNDER THE LAWS OF THE STATE OF MINNESOTA.
Mark J. Graham
DATE 8/18/93 REG.NO. 19136

Maier Stewart & Associates Inc. CONSULTING ENGINEERS
1959 SLOAN PLACE (612) 774-6021 ST. PAUL, MINNESOTA 55117
9800 SHELARD PARKWAY (612) 546-0432 MINNEAPOLIS, MINNESOTA 55441

REVISIONS	DATE	DESCRIPTION
	08/06/93	193RD RELOCATION

DESIGNED
CHECKED
DRAWN MRF
GRAPHIC SCALE
0 HORIZ. 100'
0 VERT.

CITY OF ELK RIVER
MEADOWVALE HEIGHTS
LOCATION MAP AND TYPICAL SECTION

DATE MAY, 1993 | SHEET 2 OF 15 SHEETS | PROJECT NO. 230-168

ER168-L

DRAWING NUMBER
SAFCO PRODUCTS • NEW HOPE, MINNESOTA
REORDER BY PART NUMBER 6582
DRAWING NUMBER
MEADO.93
2