193RD AVENUE

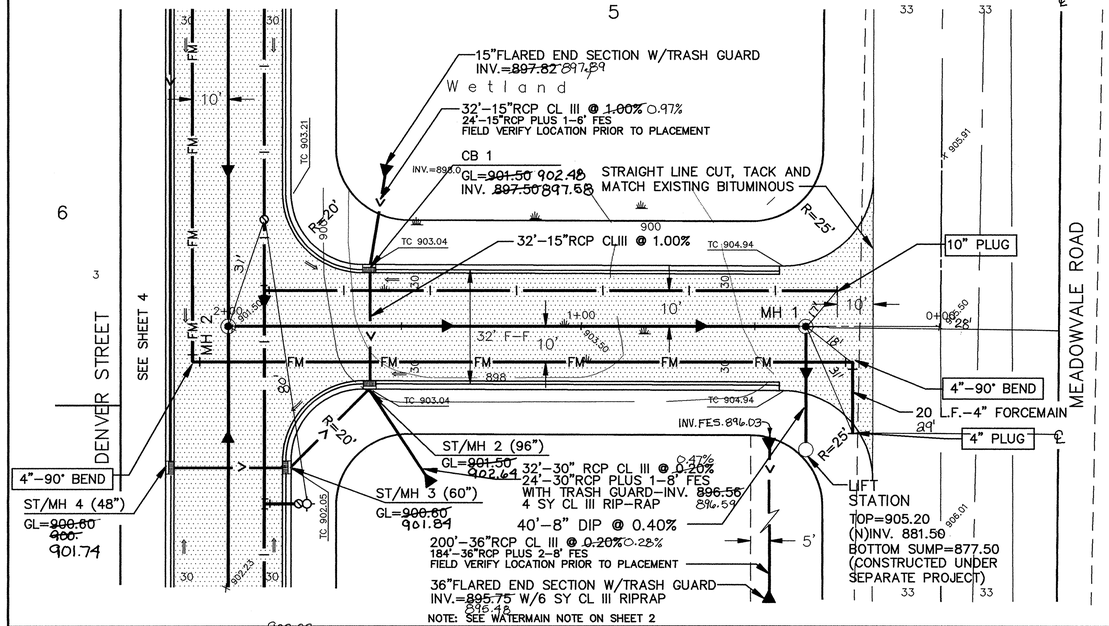

194TH AVENUE

NOTE:
ALL UTILITY SERVICES FOR THIS PROJECT SHALL BE EXTENDED 10' BEYOND THE PROPERTY LINE.

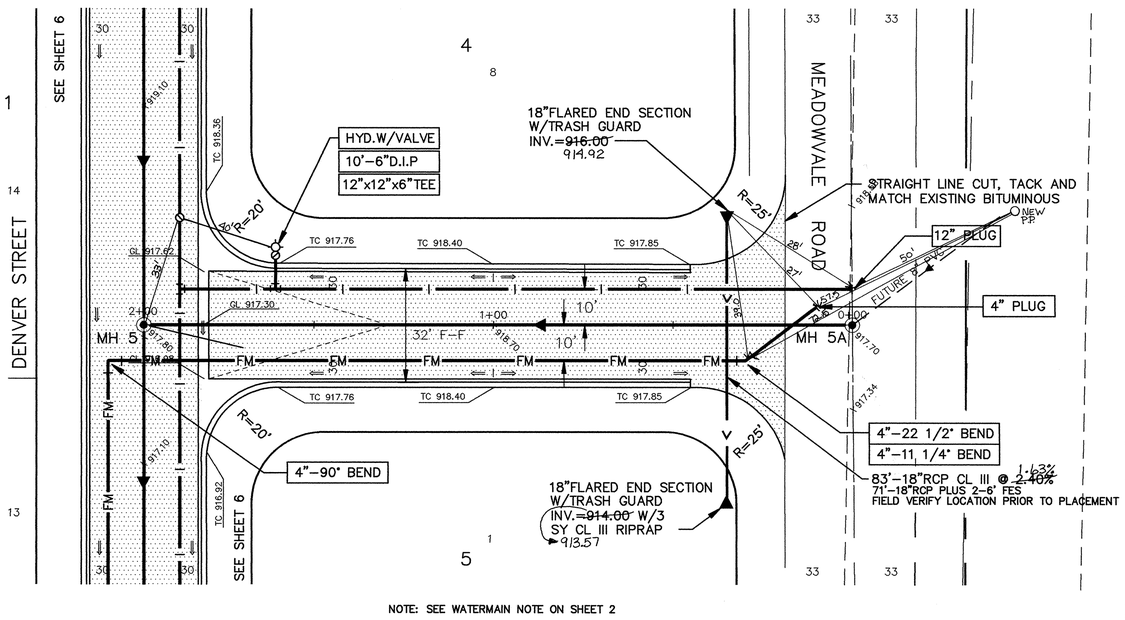

NOTE: SEE WATERMAIN NOTE ON SHEET 2

RECORD PLAN NOV,1993

I HEREBY CERTIFY THAT THIS PLAN, SPECIFICATION, OR REPORT WAS PREPARED BY ME OR UNDER MY DIRECT SUPERVISION AND THAT I AM A DULY REGISTERED PROFESSIONAL ENGINEER UNDER THE LAWS OF THE STATE OF MINNESOTA.
Mark J. Graham
DATE 6/10/93 REG.NO. 19130

Maier Stewart & Associates Inc. CONSULTING ENGINEERS
1959 SLOAN PLACE (612) 774-6021 ST. PAUL, MINNESOTA 55117
9800 SHELARD PARKWAY (612) 546-0432 MINNEAPOLIS, MINNESOTA 55441

REVISIONS	DATE	DESCRIPTION
	7/14/93	SAN. SEWER DEPTH
	8/06/93	193RD RELOCATION AVENUE SAN. SEWER AND WATERMAIN
	8/18/93	FORCEMAIN ADDITION SAN. SEWER ADD. @ 194TH

DESIGNED MJG
CHECKED BAI
DRAWN MRF
GRAPHIC SCALE
0 HORIZ. 20
0 VERT. 5

CITY OF ELK RIVER
STREET AND UTILITY CONSTRUCTION
193RD & 194TH AVENUE
STA. 0+00 TO 2+00

DATE MAY, 1993 | SHEET 3 OF 15 SHEETS | PROJECT NO. 230-168

ER168-1

DRAWING NUMBER
SAFCO PRODUCTS • NEW HOPE, MINNESOTA
REORDER BY PART NUMBER 65592
DRAWING NUMBER
MEADO.93
3