DENVER STREET

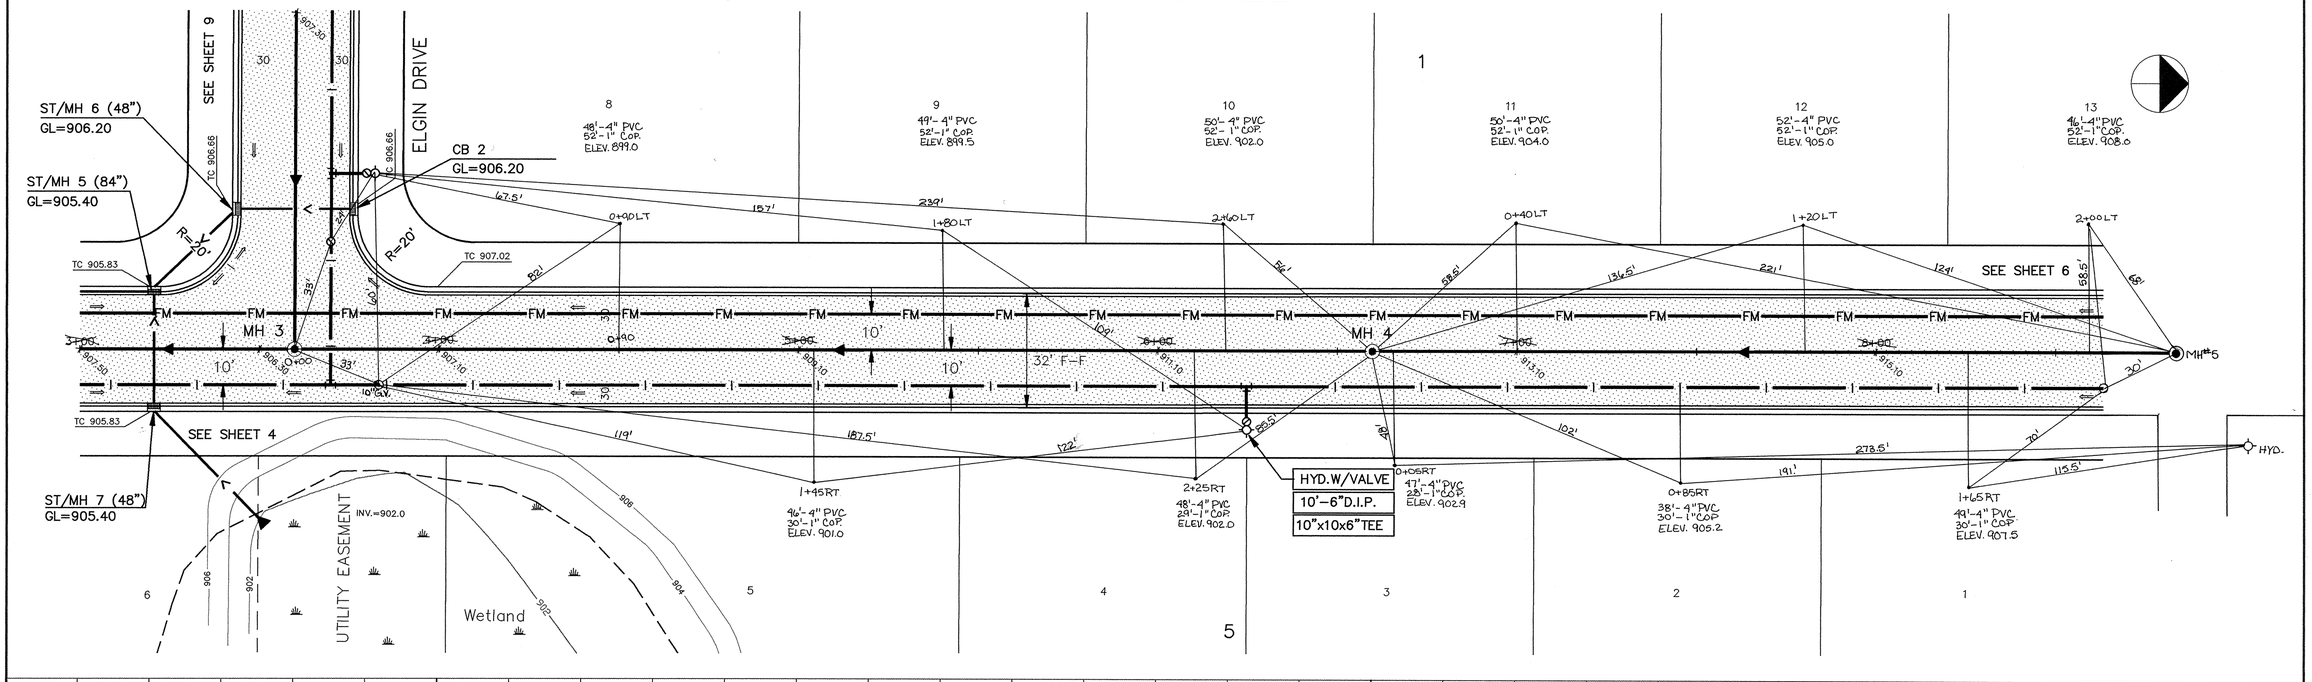

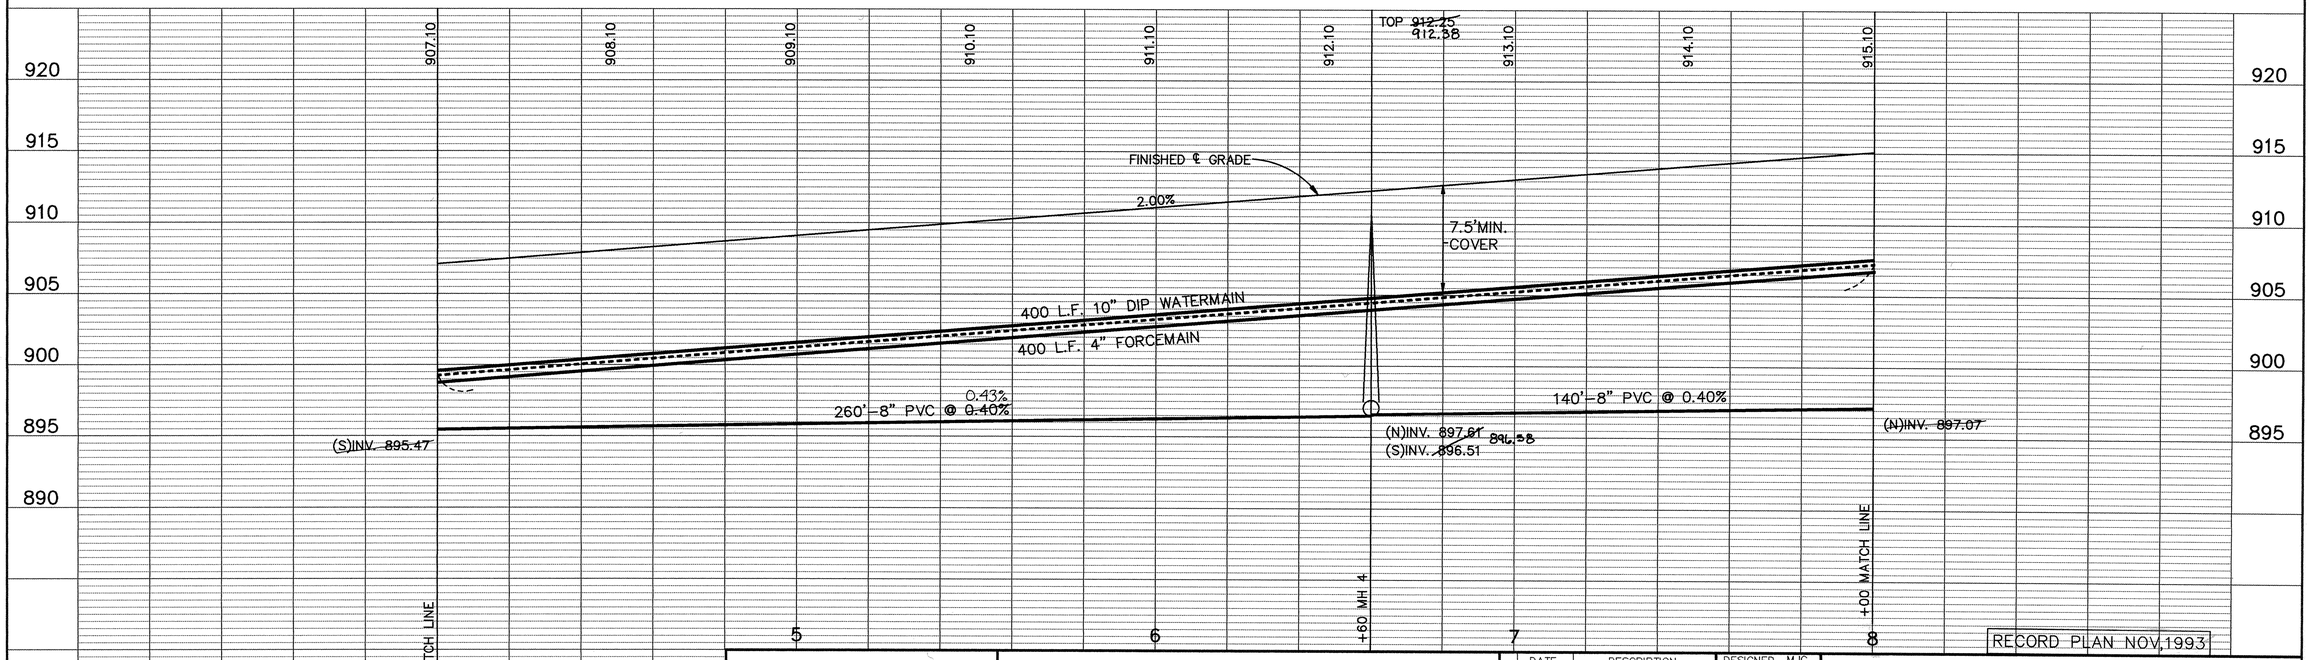

RECORD PLAN NOV.1993

I HEREBY CERTIFY THAT THIS PLAN, SPECIFICATION, OR REPORT WAS PREPARED BY ME OR UNDER MY DIRECT SUPERVISION AND THAT I AM A DULY REGISTERED PROFESSIONAL ENGINEER UNDER THE LAWS OF THE STATE OF MINNESOTA.
Mark J. Graham
DATE 8/18/93 REG.NO. 19130

Maier Stewart & Associates Inc.
CONSULTING ENGINEERS
1959 SLOAN PLACE (612) 774-6021 ST. PAUL, MINNESOTA 55117
9800 SHELARD PARKWAY (612) 546-0432 MINNEAPOLIS, MINNESOTA 55441

REVISIONS	DATE	DESCRIPTION
	8/18/93	FORCEMAIN ADDITION SAN. SEWER ADD. @ 194TH

DESIGNED MJG
CHECKED BAI
DRAWN MRF
GRAPHIC SCALE
HORIZ. 20
VERT. 5

CITY OF ELK RIVER
STREET AND UTILITY CONSTRUCTION
DENVER STREET
STA. 4+00 TO 8+00

DATE MAY, 1993 | SHEET 5 OF 15 SHEETS | PROJECT NO. 230-168

ER168-3

643

DRAWING NUMBER

SAFCO PRODUCTS • NEW HOPE, MINNESOTA
REORDER BY PART NUMBER 6532

DRAWING NUMBER

SAFCO PRODUCTS • NEW HOPE, MINNESOTA
REORDER BY PART NUMBER 6532

DRAWING NUMBER
5
MEADO.93

SAFCO PRODUCTS • NEW HOPE, MINNESOTA
REORDER BY PART NUMBER 6532