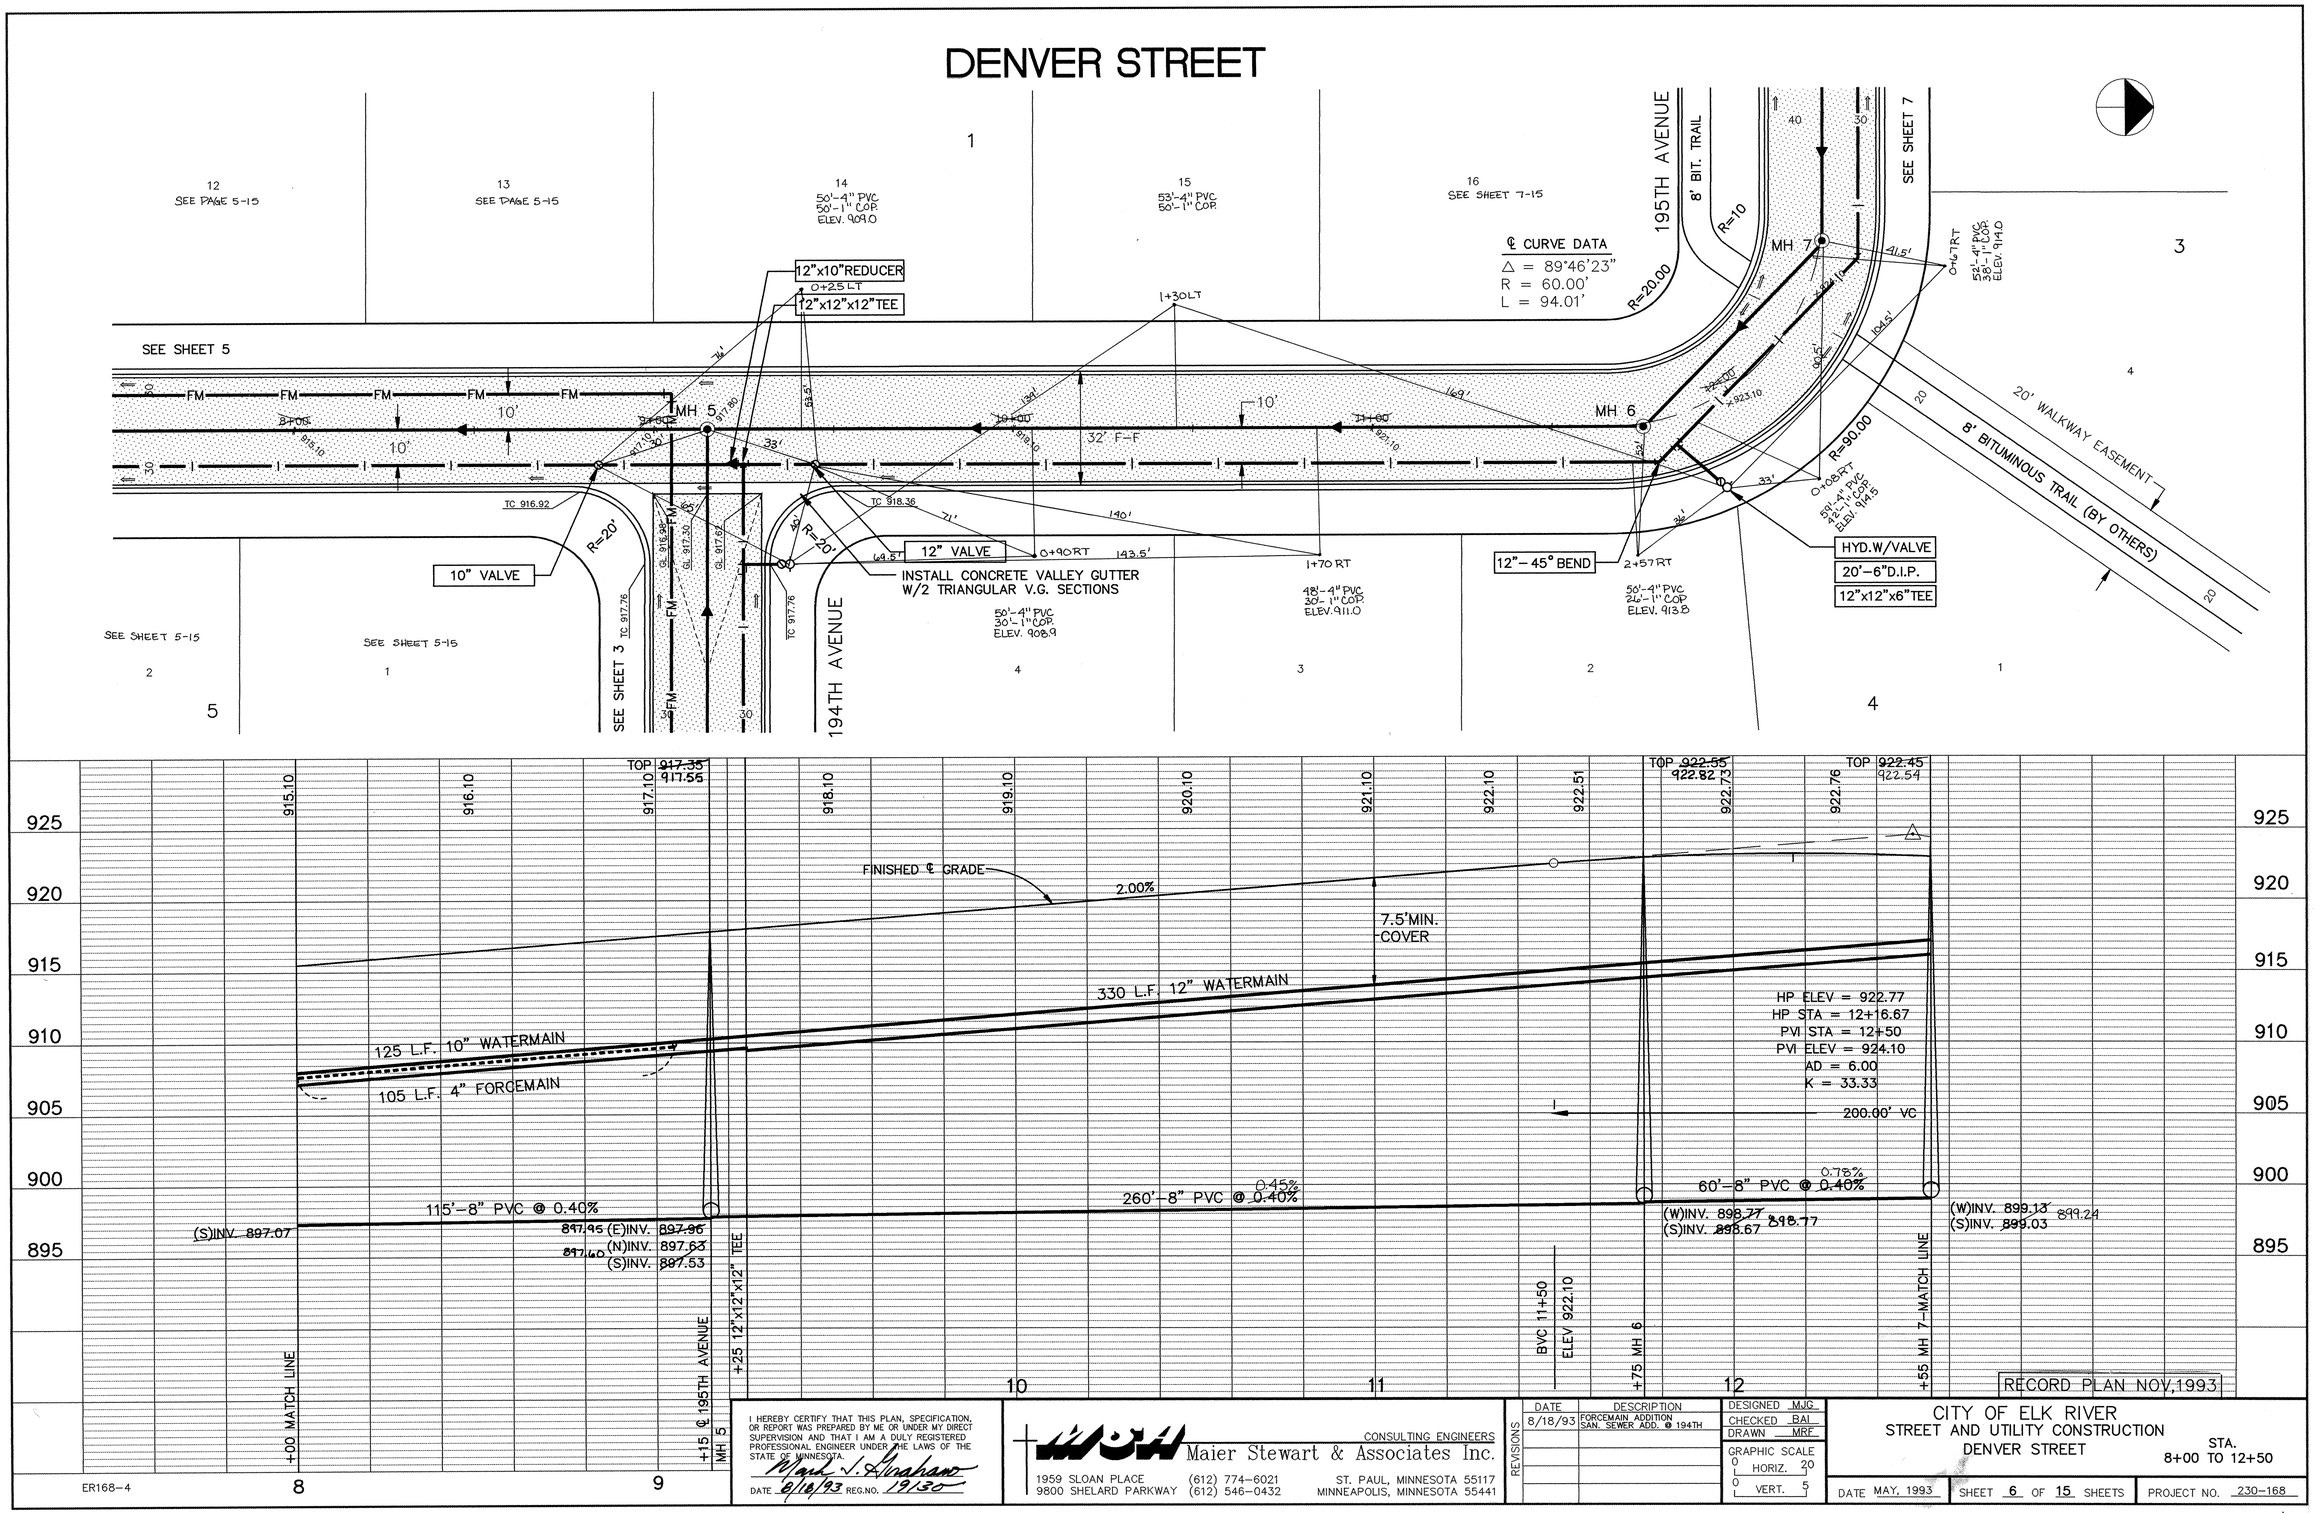

I HEREBY CERTIFY THAT THIS PLAN, SPECIFICATION, OR REPORT WAS PREPARED BY ME OR UNDER MY DIRECT SUPERVISION AND THAT I AM A DULY REGISTERED PROFESSIONAL ENGINEER UNDER THE LAWS OF THE STATE OF MINNESOTA.

Mark J. Graham

DATE 8/18/93 REG.NO. 19130

CONSULTING ENGINEERS
Maier Stewart & Associates Inc.
1959 SLOAN PLACE (612) 774-6021 ST. PAUL, MINNESOTA 55117
9800 SHELARD PARKWAY (612) 546-0432 MINNEAPOLIS, MINNESOTA 55441

REVISIONS	DATE	DESCRIPTION
	8/18/93	FORCEMAIN ADDITION SAN. SEWER ADD. @ 194TH

DESIGNED MJG
CHECKED BAL
DRAWN MRF
GRAPHIC SCALE
HORIZ. 0 20
VERT. 0 5

CITY OF ELK RIVER
STREET AND UTILITY CONSTRUCTION
DENVER STREET
STA. 8+00 TO 12+50

DATE MAY, 1993 | SHEET 6 OF 15 SHEETS | PROJECT NO. 230-168

642

DRAWING NUMBER
MEADO.93
6