195TH AVENUE

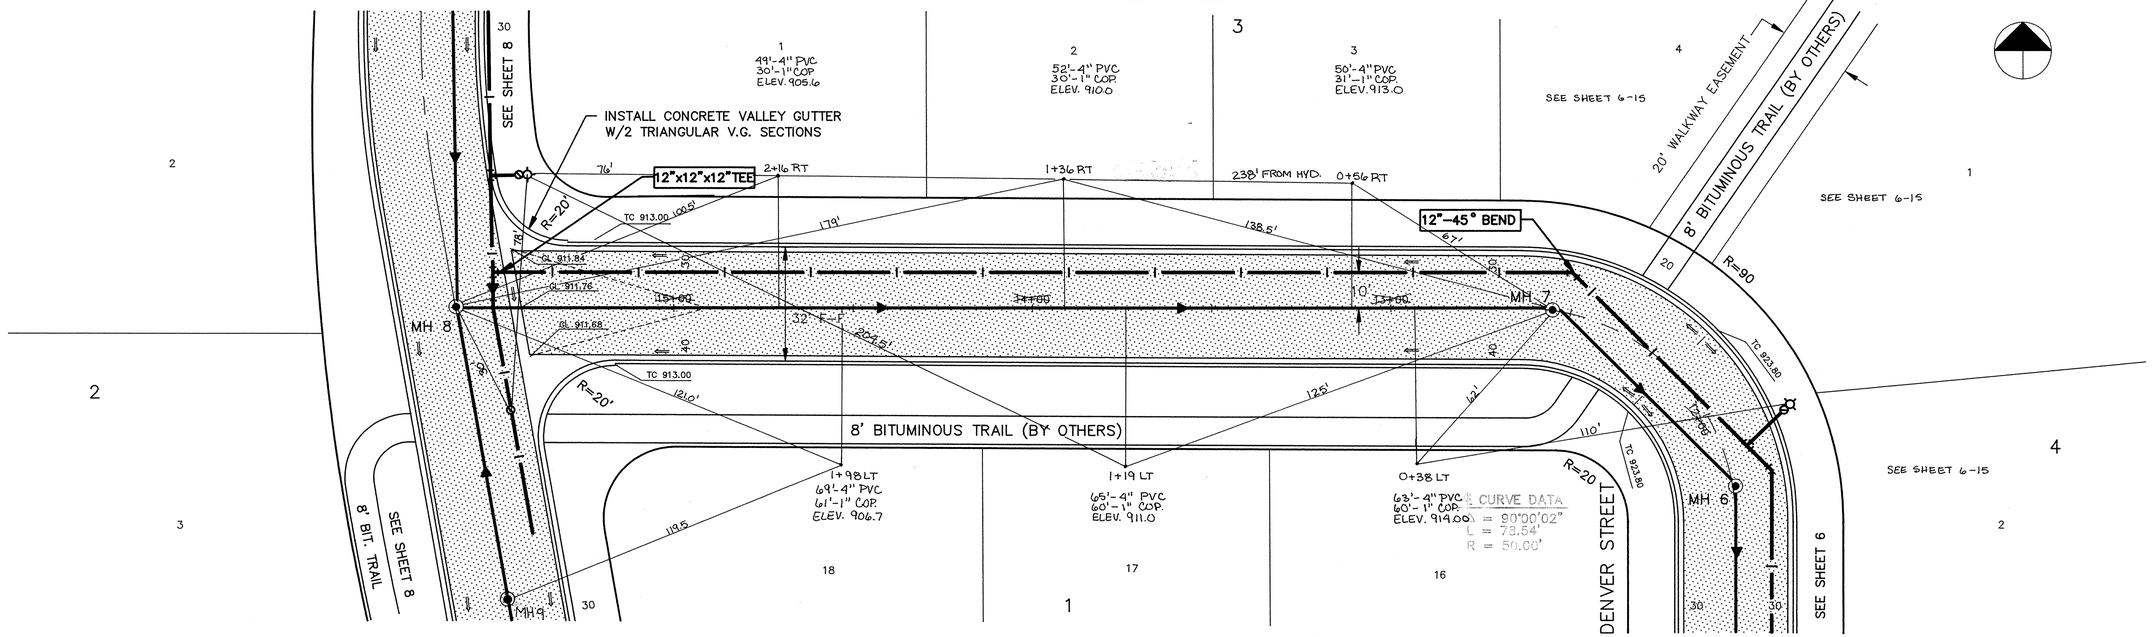

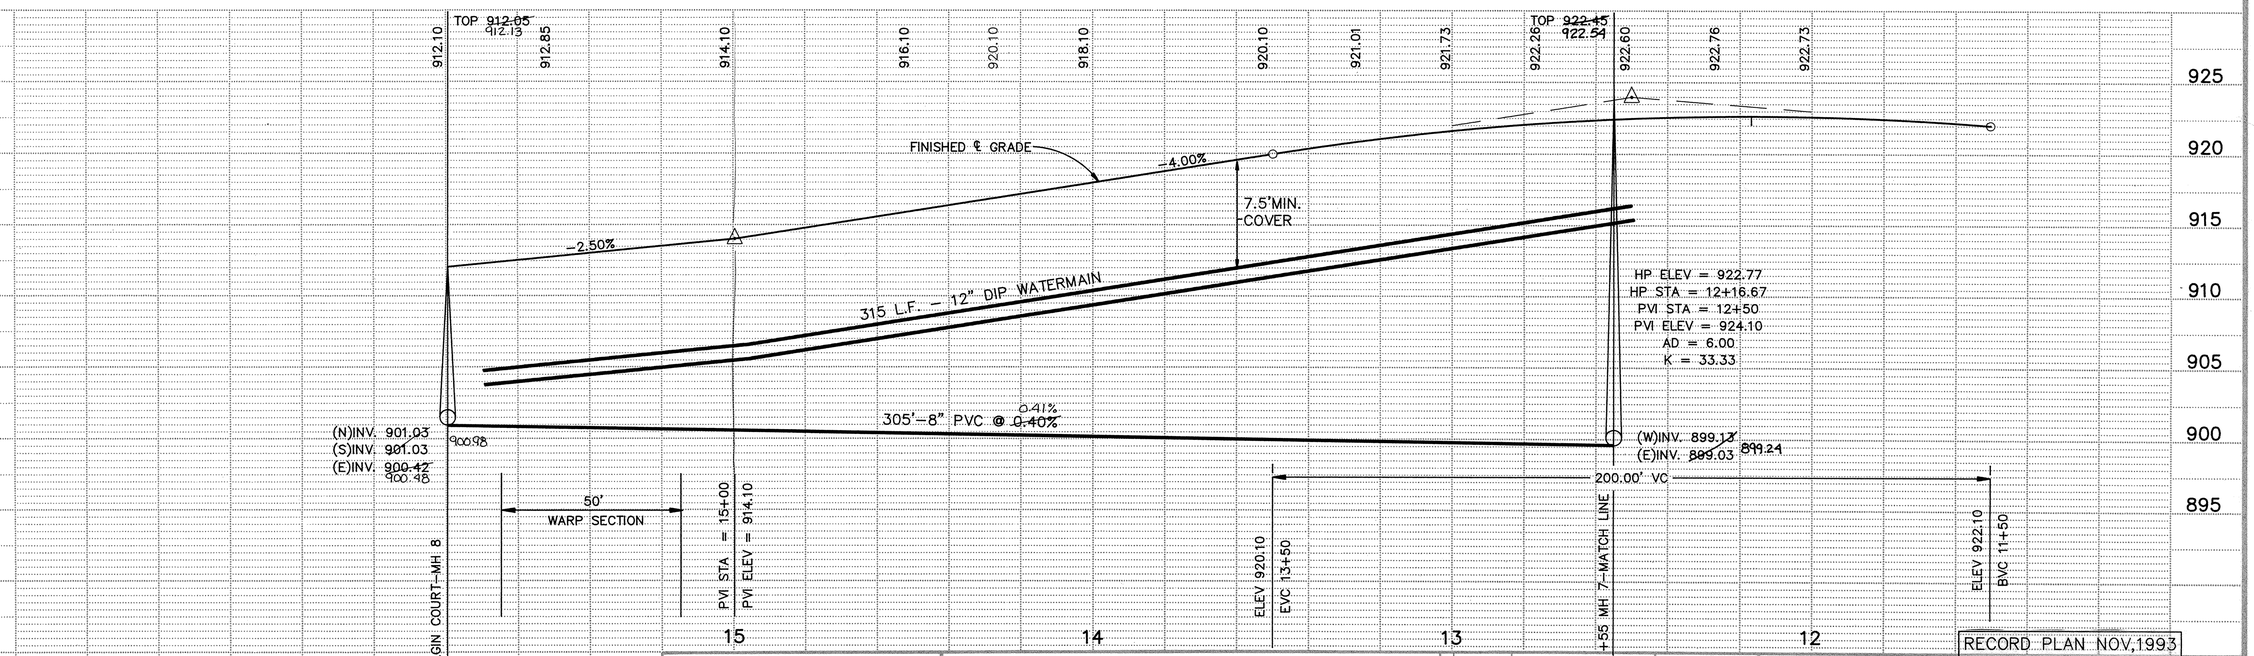

RECORD PLAN NOV,1993

ER168-5

I HEREBY CERTIFY THAT THIS PLAN, SPECIFICATION, OR REPORT WAS PREPARED BY ME OR UNDER MY DIRECT SUPERVISION AND THAT I AM A DULY REGISTERED PROFESSIONAL ENGINEER UNDER THE LAWS OF THE STATE OF MINNESOTA.

Mark J. Gustafson

DATE 7/7/93 REG. NO. 19130

CONSULTING ENGINEERS
Maier Stewart & Associates Inc.
9800 SHELARD PARKWAY (612) 546-0432 MINNEAPOLIS, MINNESOTA 55441
1973 SLOAN PLACE (612) 774-6021 ST. PAUL, MINNESOTA 55117

REVISIONS	DATE	DESCRIPTION

DESIGNED MJG
CHECKED BAI
DRAWN MRE
GRAPHIC SCALE
0 HORIZ. 20
0 VERT. 5

CITY OF ELK RIVER
STREET AND UTILITY CONSTRUCTION
195TH AVENUE
STA. 12+50 TO 15+80

DATE MAY, 1993 | SHEET 7 OF 15 SHEETS | PROJECT NO. 230-168

641

DRAWING NUMBER

DRAWING NUMBER

DRAWING NUMBER
MEADO.93
7