ELGIN DRIVE

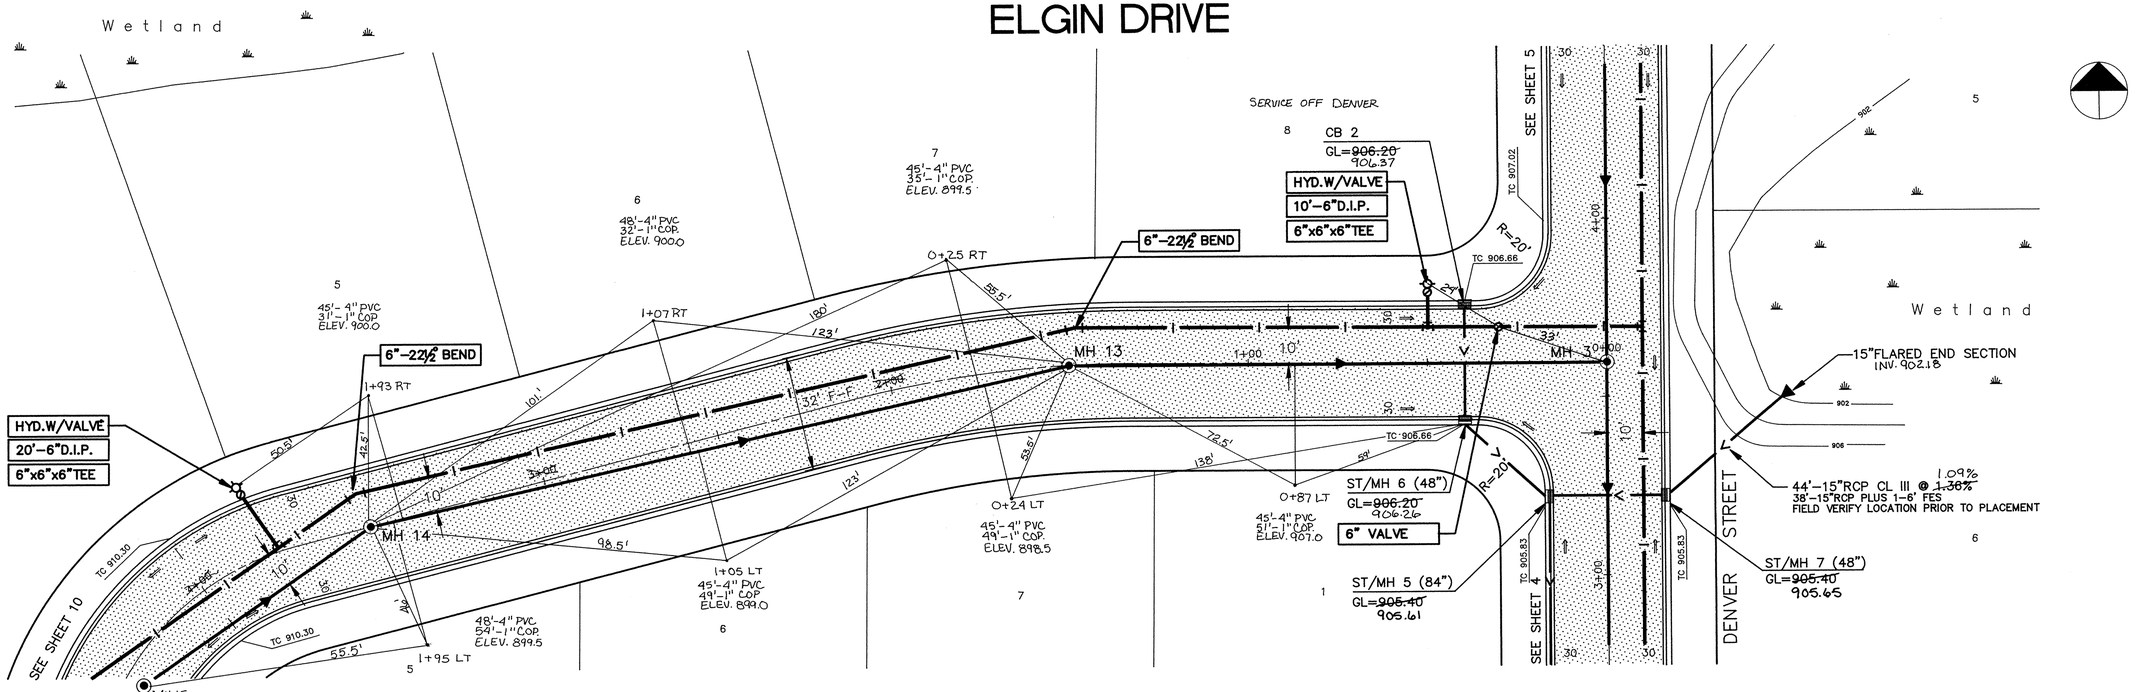

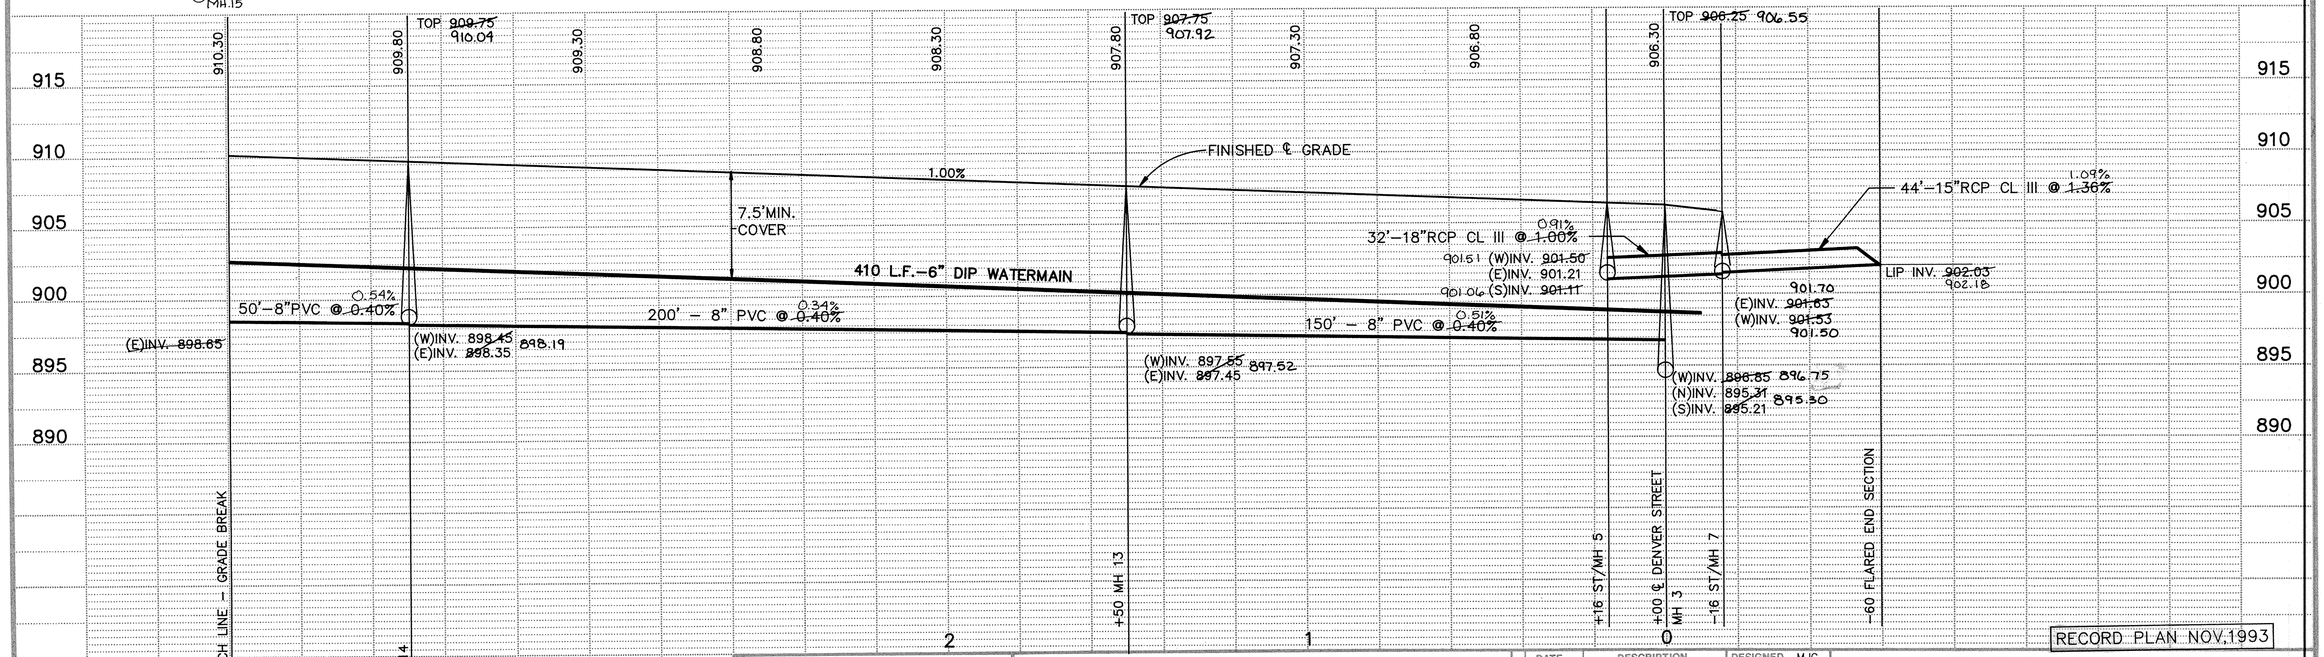

RECORD PLAN NOV,1993

I HEREBY CERTIFY THAT THIS PLAN, SPECIFICATION, OR REPORT WAS PREPARED BY ME OR UNDER MY DIRECT SUPERVISION AND THAT I AM A DULY REGISTERED PROFESSIONAL ENGINEER UNDER THE LAWS OF THE STATE OF MINNESOTA.

Mark V. Graham

DATE 7/7/93 REG. NO. 19130

CONSULTING ENGINEERS
Maier Stewart & Associates Inc.
9800 SHELARD PARKWAY (612) 546-0432 MINNEAPOLIS, MINNESOTA 55441
1973 SLOAN PLACE (612) 774-6021 ST. PAUL, MINNESOTA 55117

REVISIONS	DATE	DESCRIPTION

DESIGNED MJG
CHECKED BAI
DRAWN MRF
GRAPHIC SCALE
HORIZ. 20
VERT. 5

CITY OF ELK RIVER
STREET AND UTILITY CONSTRUCTION
ELGIN DRIVE
STA. 0+00 TO 4+00

DATE MAY, 1993 | SHEET 9 OF 15 SHEETS | PROJECT NO. 230-168

ER168-7

639

DRAWING NUMBER

SAFCO PRODUCTS • NEW HOPE, MINNESOTA
REORDER BY PART NUMBER 60302
POSITION EDGE OF PAPER ON THIS LINE

DRAWING NUMBER

SAFCO PRODUCTS • NEW HOPE, MINNESOTA
REORDER BY PART NUMBER 60302
POSITION EDGE OF PAPER ON THIS LINE

DRAWING NUMBER
MEADO 93
9

SAFCO PRODUCTS • NEW HOPE, MINNESOTA
REORDER BY PART NUMBER 60302
POSITION EDGE OF PAPER ON THIS LINE