ELGIN DRIVE

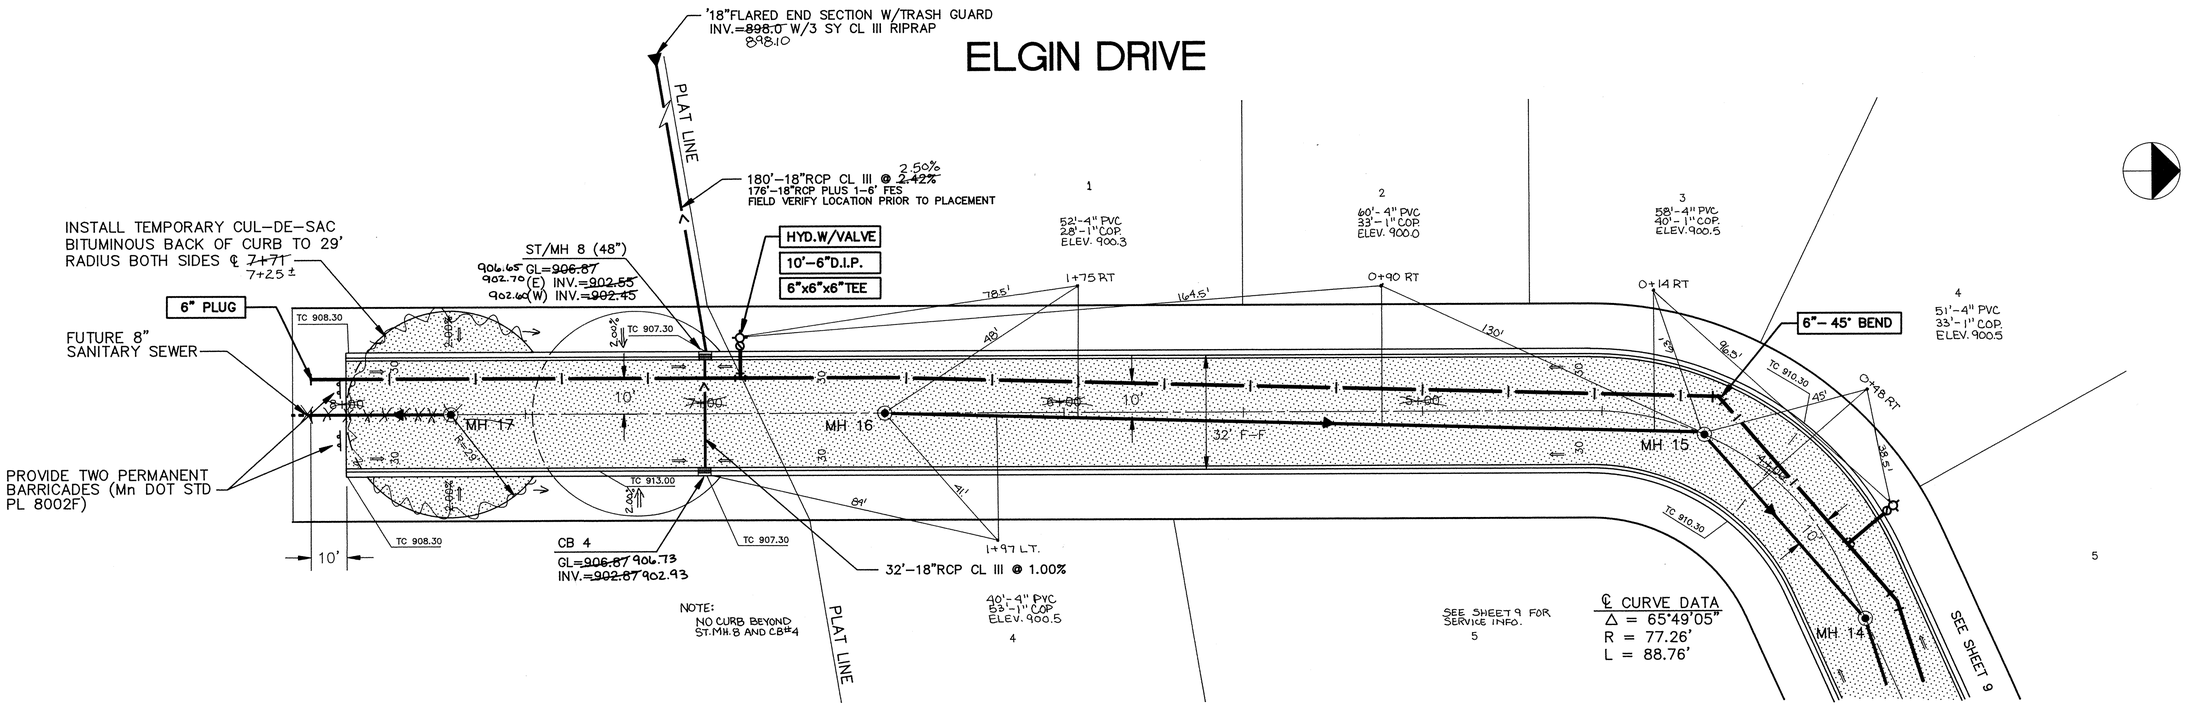

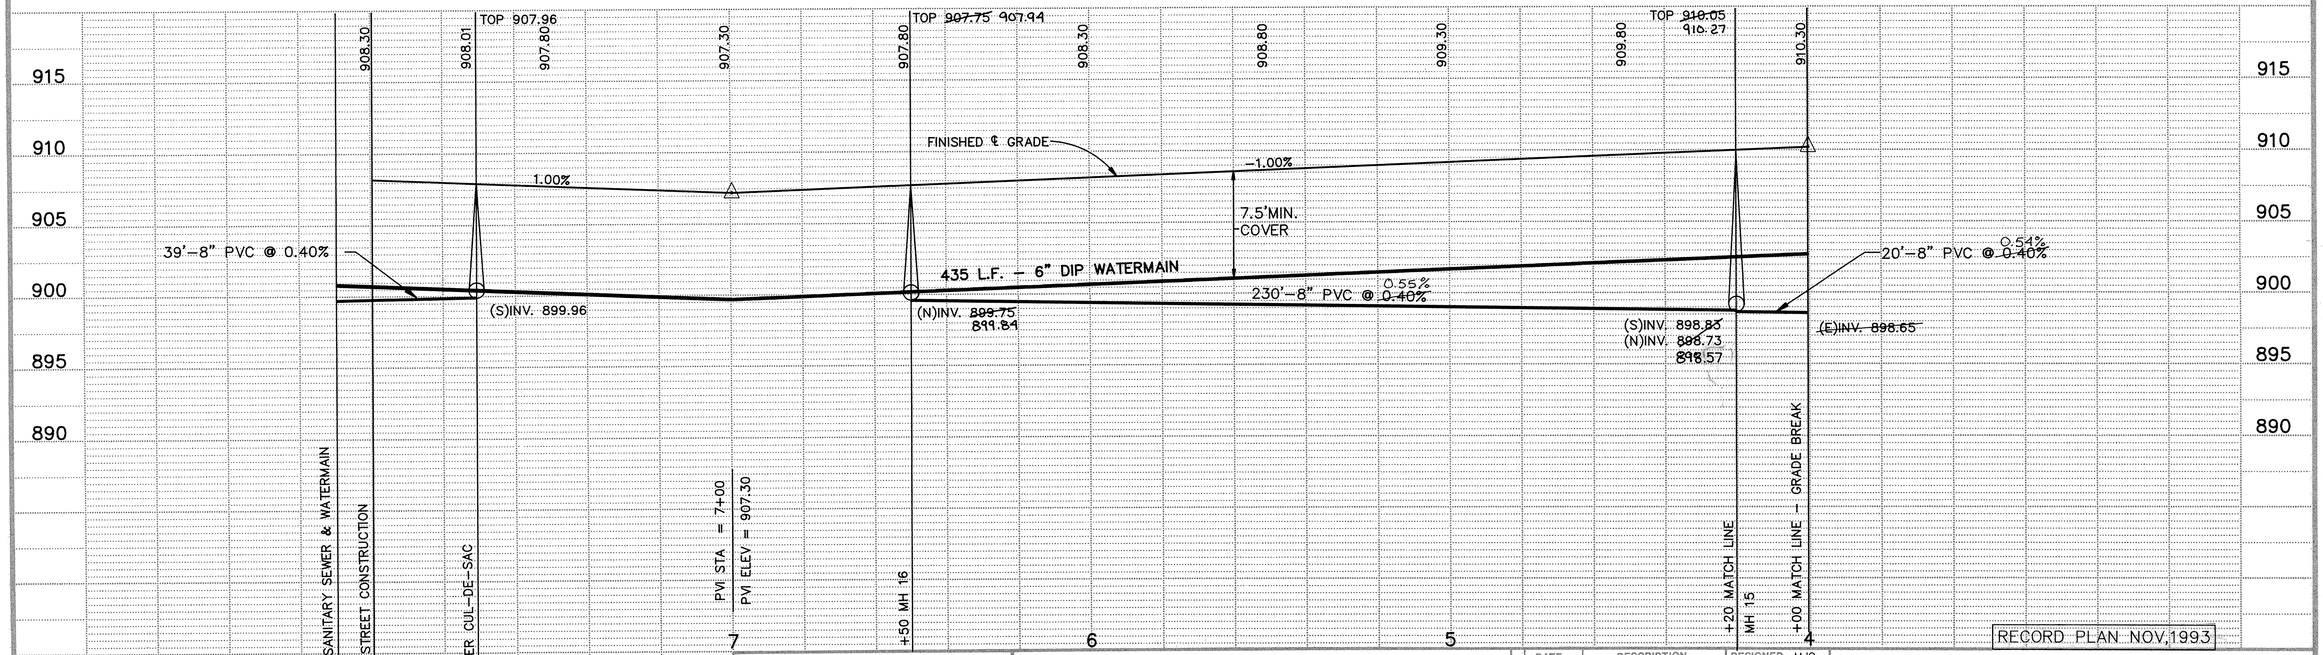

ER168-8

RECORD PLAN NOV, 1993

I HEREBY CERTIFY THAT THIS PLAN, SPECIFICATION, OR REPORT WAS PREPARED BY ME OR UNDER MY DIRECT SUPERVISION AND THAT I AM A DULY REGISTERED PROFESSIONAL ENGINEER UNDER THE LAWS OF THE STATE OF MINNESOTA.

Mark J. Graham

DATE 7/7/93 REG. NO. 19130

CONSULTING ENGINEERS
Maier Stewart & Associates Inc.
9800 SHELARD PARKWAY (612) 546-0432 MINNEAPOLIS, MINNESOTA 55441
1973 SLOAN PLACE (612) 774-6021 ST. PAUL, MINNESOTA 55117

REVISIONS	DATE	DESCRIPTION

DESIGNED MJG
CHECKED BAI
DRAWN MRF
GRAPHIC SCALE
○ HORIZ. 20
○ VERT. 5

CITY OF ELK RIVER
STREET AND UTILITY CONSTRUCTION
ELGIN DRIVE
STA. 4+00 TO 8+00

DATE MAY, 1993 | SHEET 10 OF 15 SHEETS | PROJECT NO. 230-168

638

DRAWING NUMBER

SACO PRODUCTS • NEW HOPE, MINNESOTA
REORDER BY PART NUMBER 6592

DRAWING NUMBER
MEADO 93
10