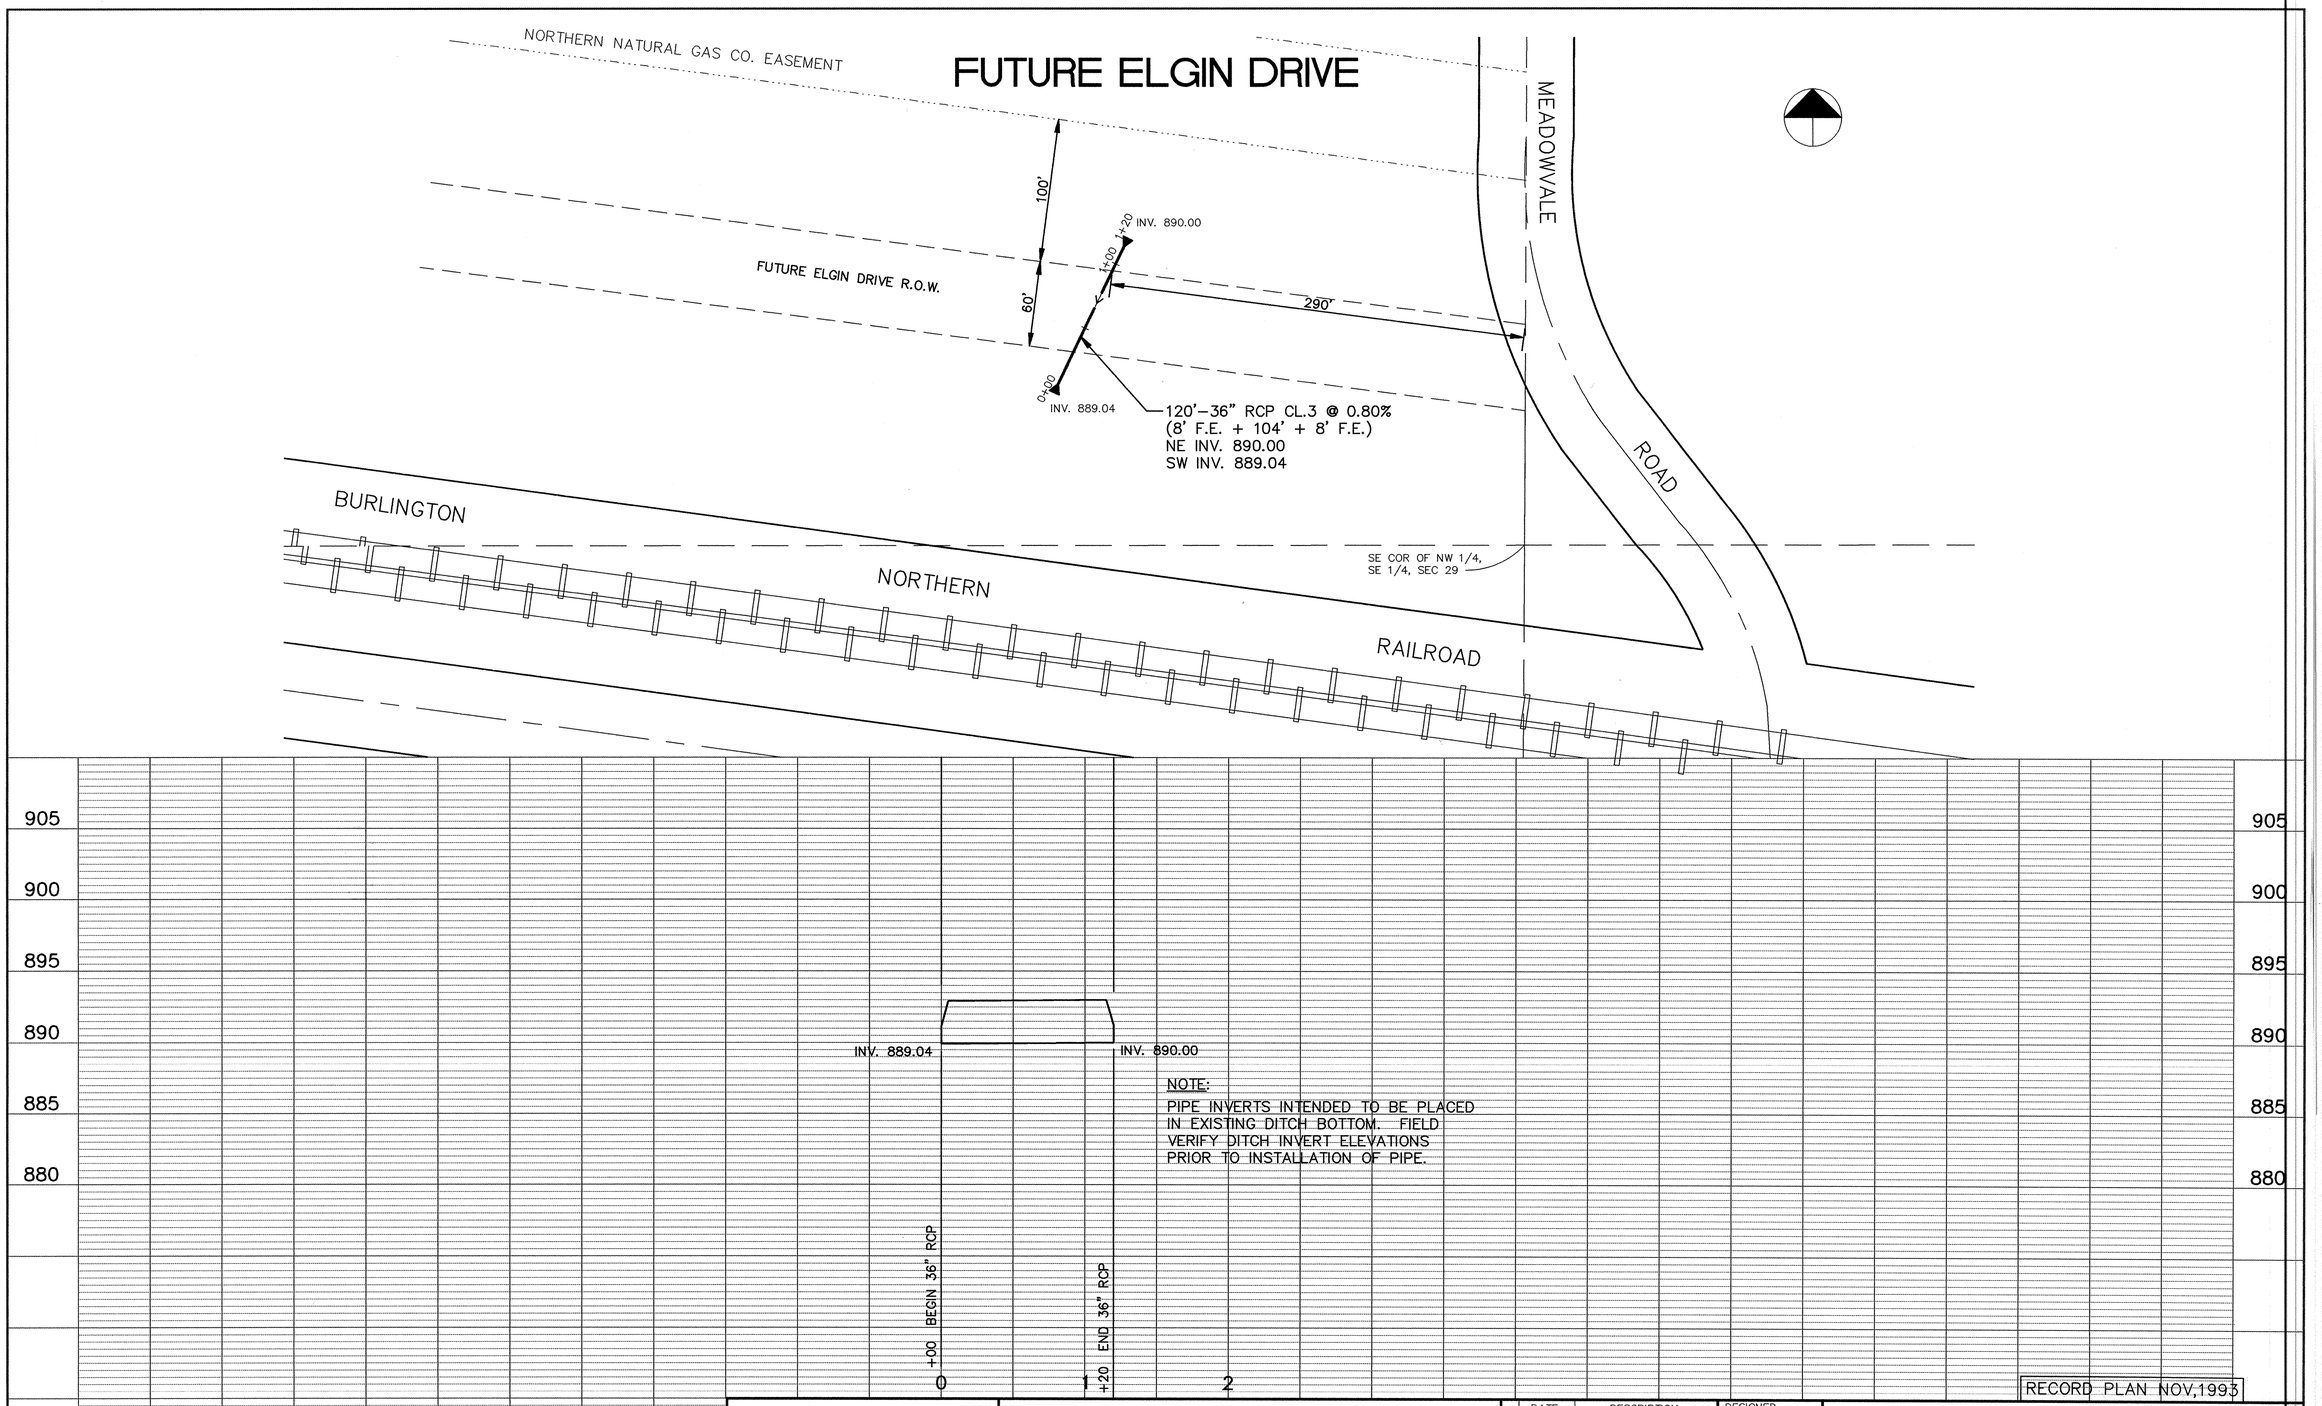

NOTE:
PIPE INVERTS INTENDED TO BE PLACED IN EXISTING DITCH BOTTOM. FIELD VERIFY DITCH INVERT ELEVATIONS PRIOR TO INSTALLATION OF PIPE.

RECORD PLAN NOV,1993

ER168–11

I HEREBY CERTIFY THAT THIS PLAN, SPECIFICATION, OR REPORT WAS PREPARED BY ME OR UNDER MY DIRECT SUPERVISION AND THAT I AM A DULY REGISTERED PROFESSIONAL ENGINEER UNDER THE LAWS OF THE STATE OF MINNESOTA.
Mark J. Graham
DATE 7/29/93 REG.NO. 19130

Maier Stewart & Associates Inc.
CONSULTING ENGINEERS
1959 SLOAN PLACE (612) 774–6021
9800 SHELARD PARKWAY (612) 546–0432
ST. PAUL, MINNESOTA 55117
MINNEAPOLIS, MINNESOTA 55441

REVISIONS	DATE	DESCRIPTION

DESIGNED ____
CHECKED ____
DRAWN CLS
GRAPHIC SCALE
0 HORIZ. 50
0 VERT. 5

CITY OF ELK RIVER
STORM SEWER
MEADOWVALE HEIGHTS
STA. 0+00 TO 1+20

DATE JULY 1993 | SHEET 11 OF 15 SHEETS | PROJECT NO. 230–168

DRAWING NUMBER
SARGO PRODUCTS • NEW HOPE, MINNESOTA
REORDER BY PART NUMBER 6582
DRAWING NUMBER
MEADO.93
11