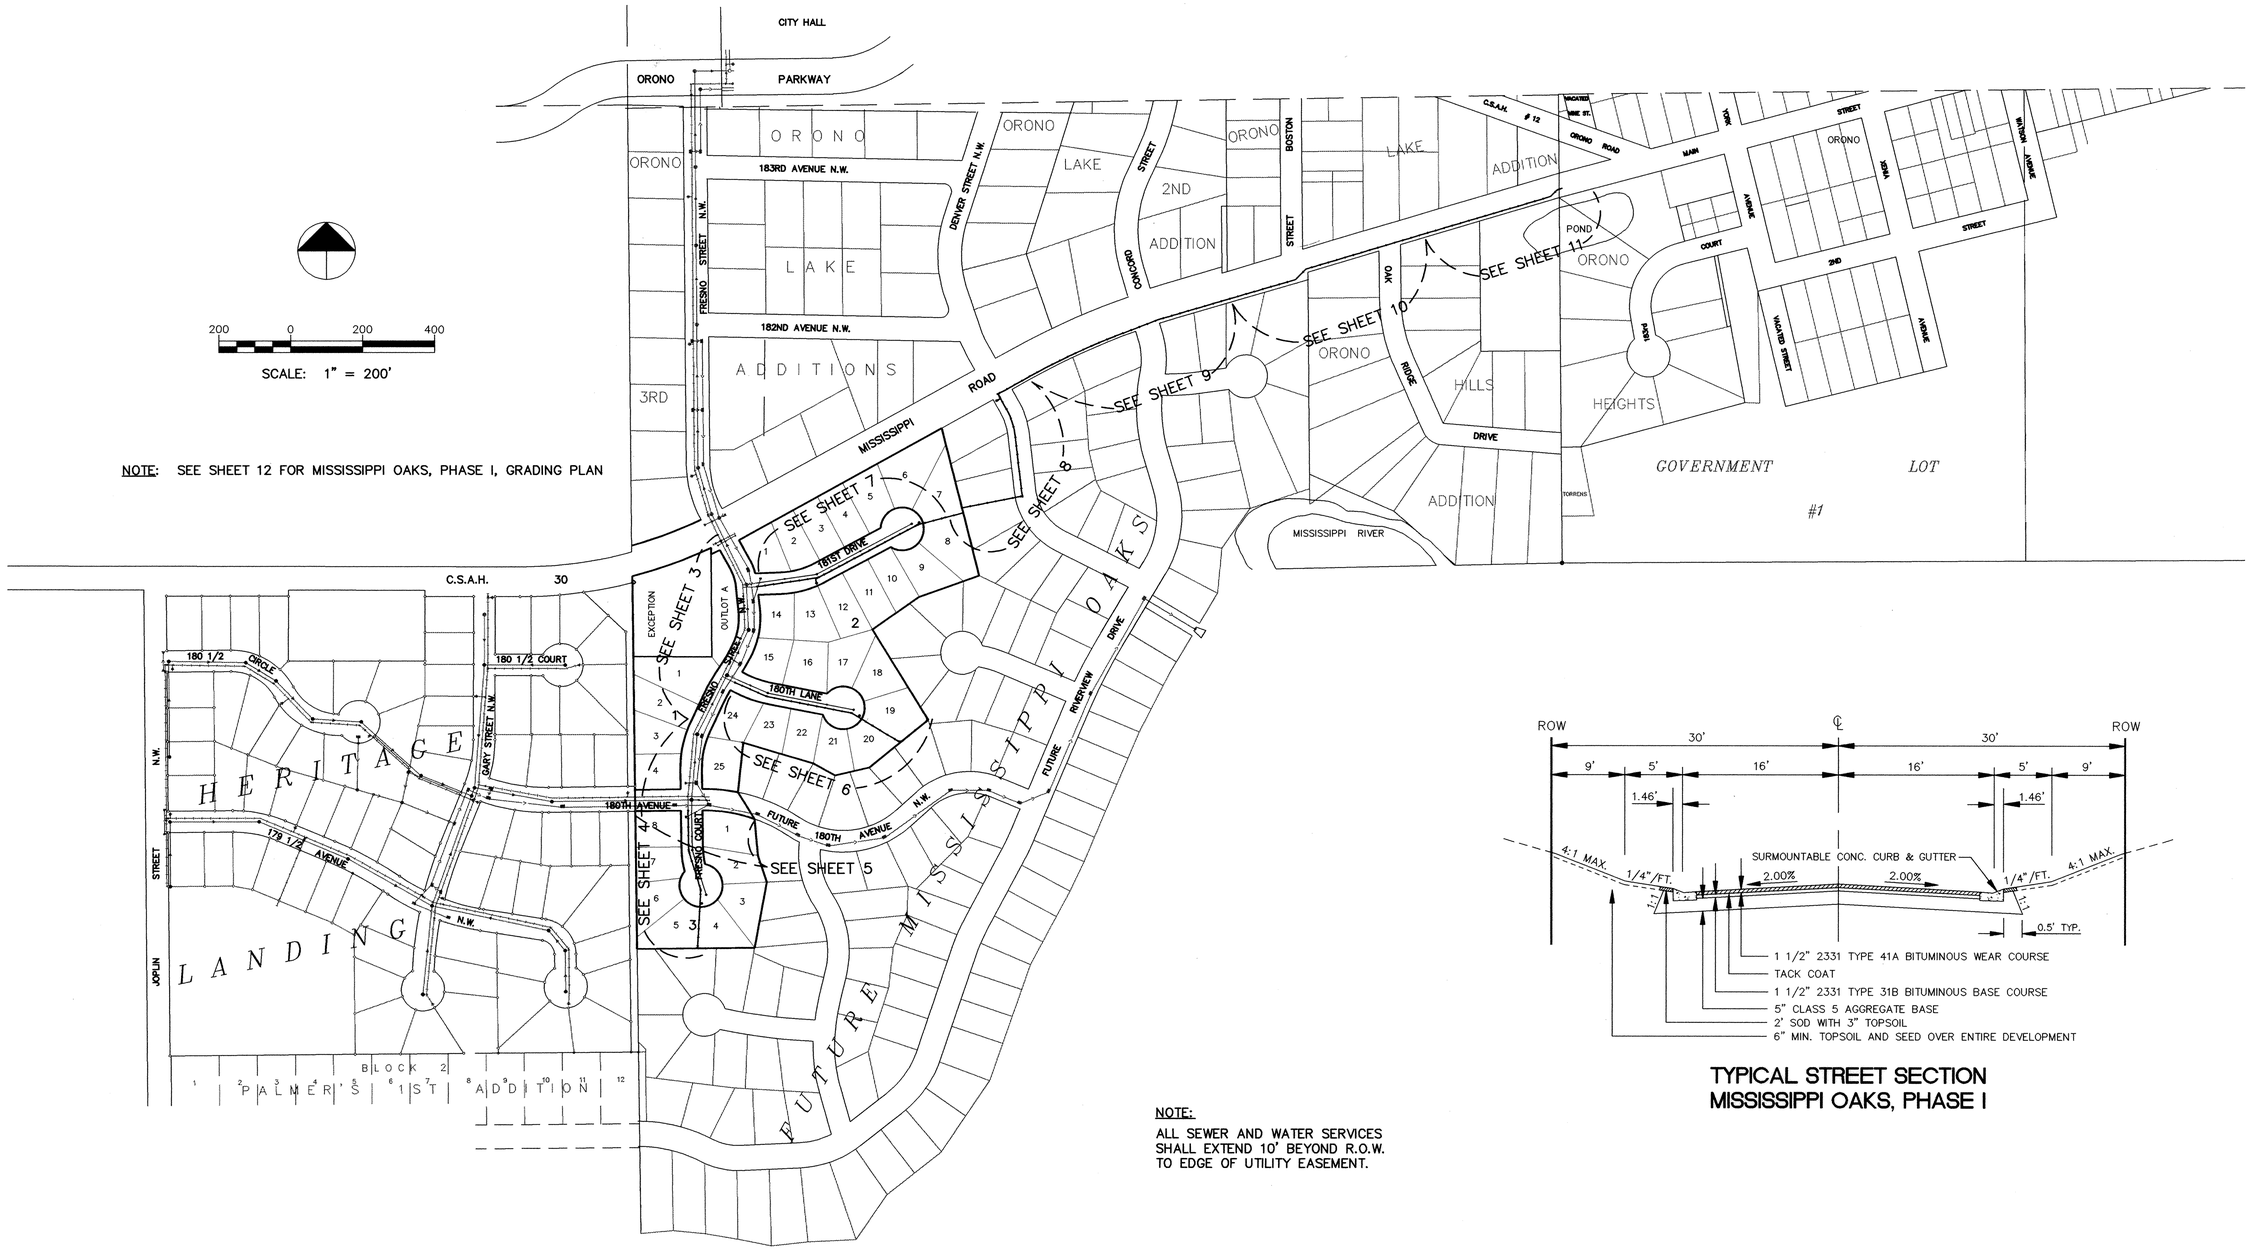

200 0 200 400

SCALE: 1" = 200'

NOTE: SEE SHEET 12 FOR MISSISSIPPI OAKS, PHASE I, GRADING PLAN

LOCATION MAP

TYPICAL STREET SECTION
MISSISSIPPI OAKS, PHASE I

NOTE:
ALL SEWER AND WATER SERVICES SHALL EXTEND 10' BEYOND R.O.W. TO EDGE OF UTILITY EASEMENT.

RECORD PLAN NOV,1993

I HEREBY CERTIFY THAT THIS PLAN, SPECIFICATION, OR REPORT WAS PREPARED BY ME OR UNDER MY DIRECT SUPERVISION AND THAT I AM A DULY REGISTERED PROFESSIONAL ENGINEER UNDER THE LAWS OF THE STATE OF MINNESOTA.
Mark J. Graham
DATE 4/9/93 REG.NO. 14130

Maier Stewart & Associates Inc. CONSULTING ENGINEERS
1959 SLOAN PLACE (612) 774-6021 ST. PAUL, MINNESOTA 55117
9800 SHELARD PARKWAY (612) 546-0432 MINNEAPOLIS, MINNESOTA 55441

REVISIONS	DATE	DESCRIPTION

DESIGNED GG
CHECKED TJM
DRAWN GG
GRAPHIC SCALE 0 HORIZ. 100 0 VERT.

CITY OF ELK RIVER
MISSISSIPPI OAKS, PHASE I
LOCATION MAP & STREET SECTION

DATE JUNE 1993 | SHEET 2 OF 16 SHEETS | PROJECT NO. 230-164

ER164-LM

617

DRAWING NUMBER
SAFOLD PRODUCTS • NEW HOPE, MINNESOTA
REORDER BY PART NUMBER 62050
POSITION SIDE OF PAPER ON THIS SIDE

DRAWING NUMBER
SAFOLD PRODUCTS • NEW HOPE, MINNESOTA
REORDER BY PART NUMBER 62050
POSITION SIDE OF PAPER ON THIS SIDE

DRAWING NUMBER
MISSI1.93
2
SAFOLD PRODUCTS • NEW HOPE, MINNESOTA
REORDER BY PART NUMBER 62050
POSITION SIDE OF PAPER ON THIS SIDE