
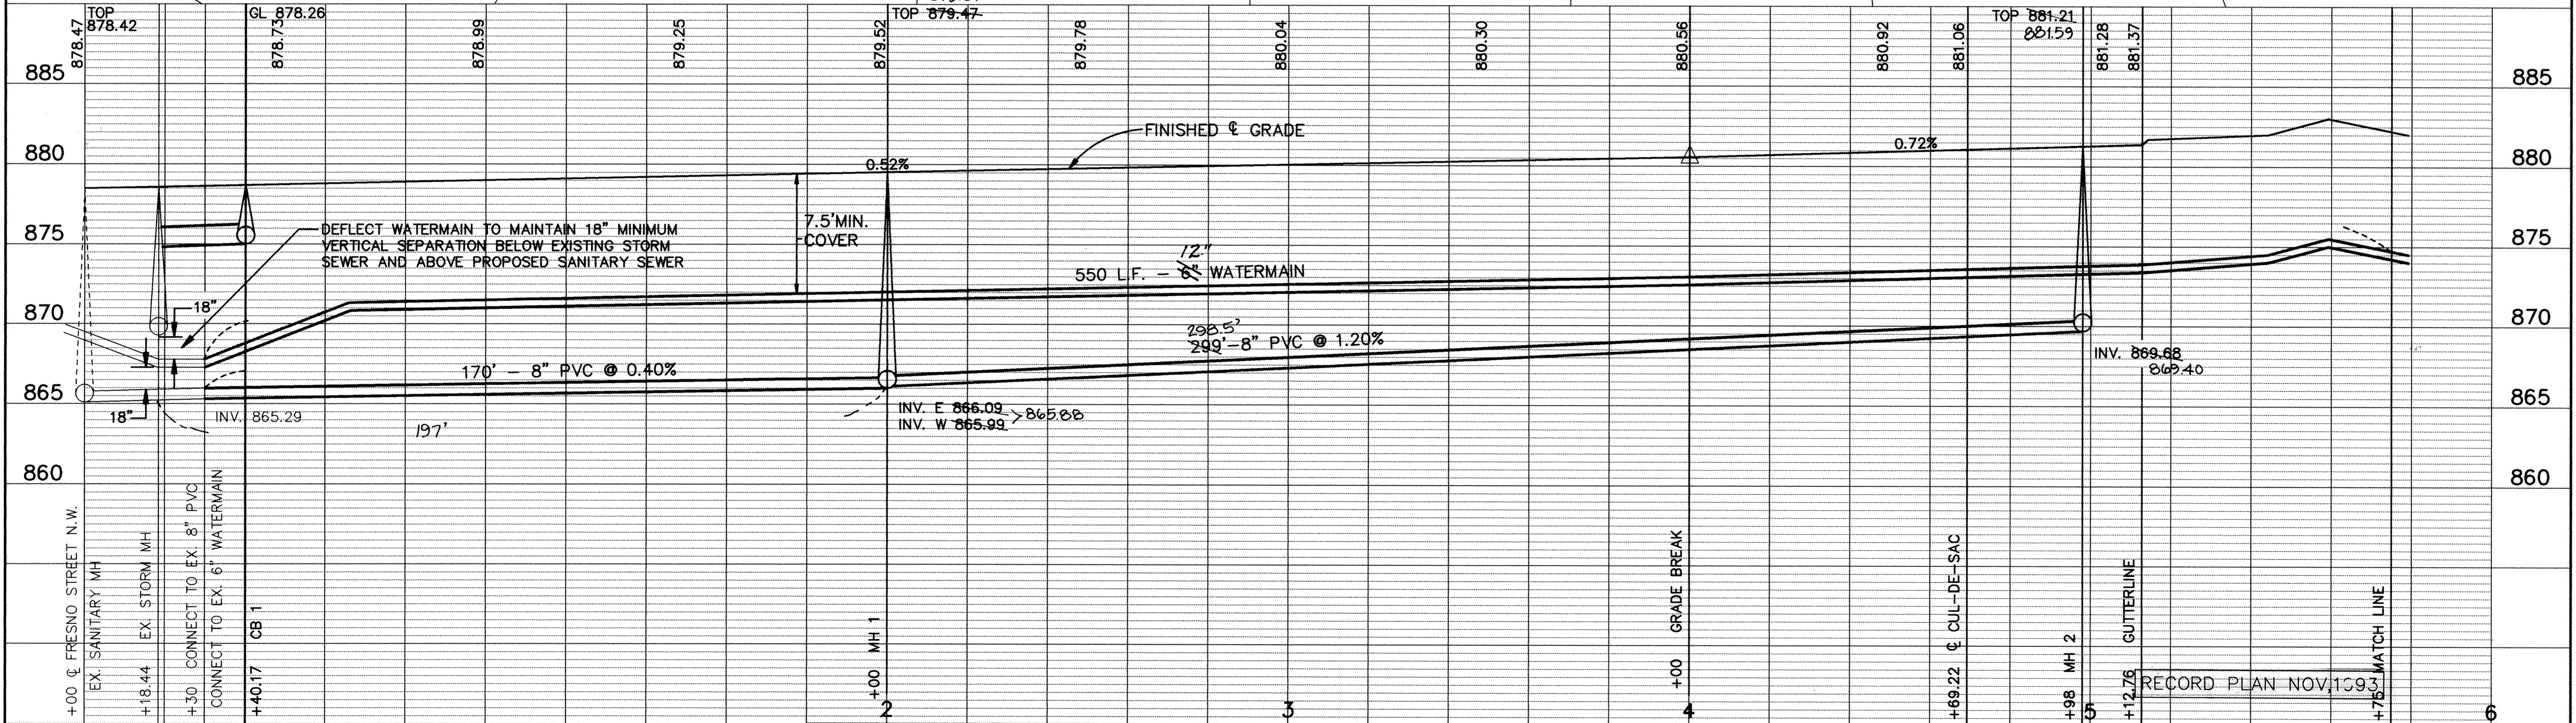


SAICD PRODUCTS • NEW UPTON, MINNESOTA
FURNISH BY PART NUMBER 6532
SAICD PRODUCTS • NEW UPTON, MINNESOTA
FURNISH BY PART NUMBER 6532
SAICD PRODUCTS • NEW UPTON, MINNESOTA
FURNISH BY PART NUMBER 6532
SAICD PRODUCTS • NEW UPTON, MINNESOTA
FURNISH BY PART NUMBER 6532

181ST DRIVE N.W.

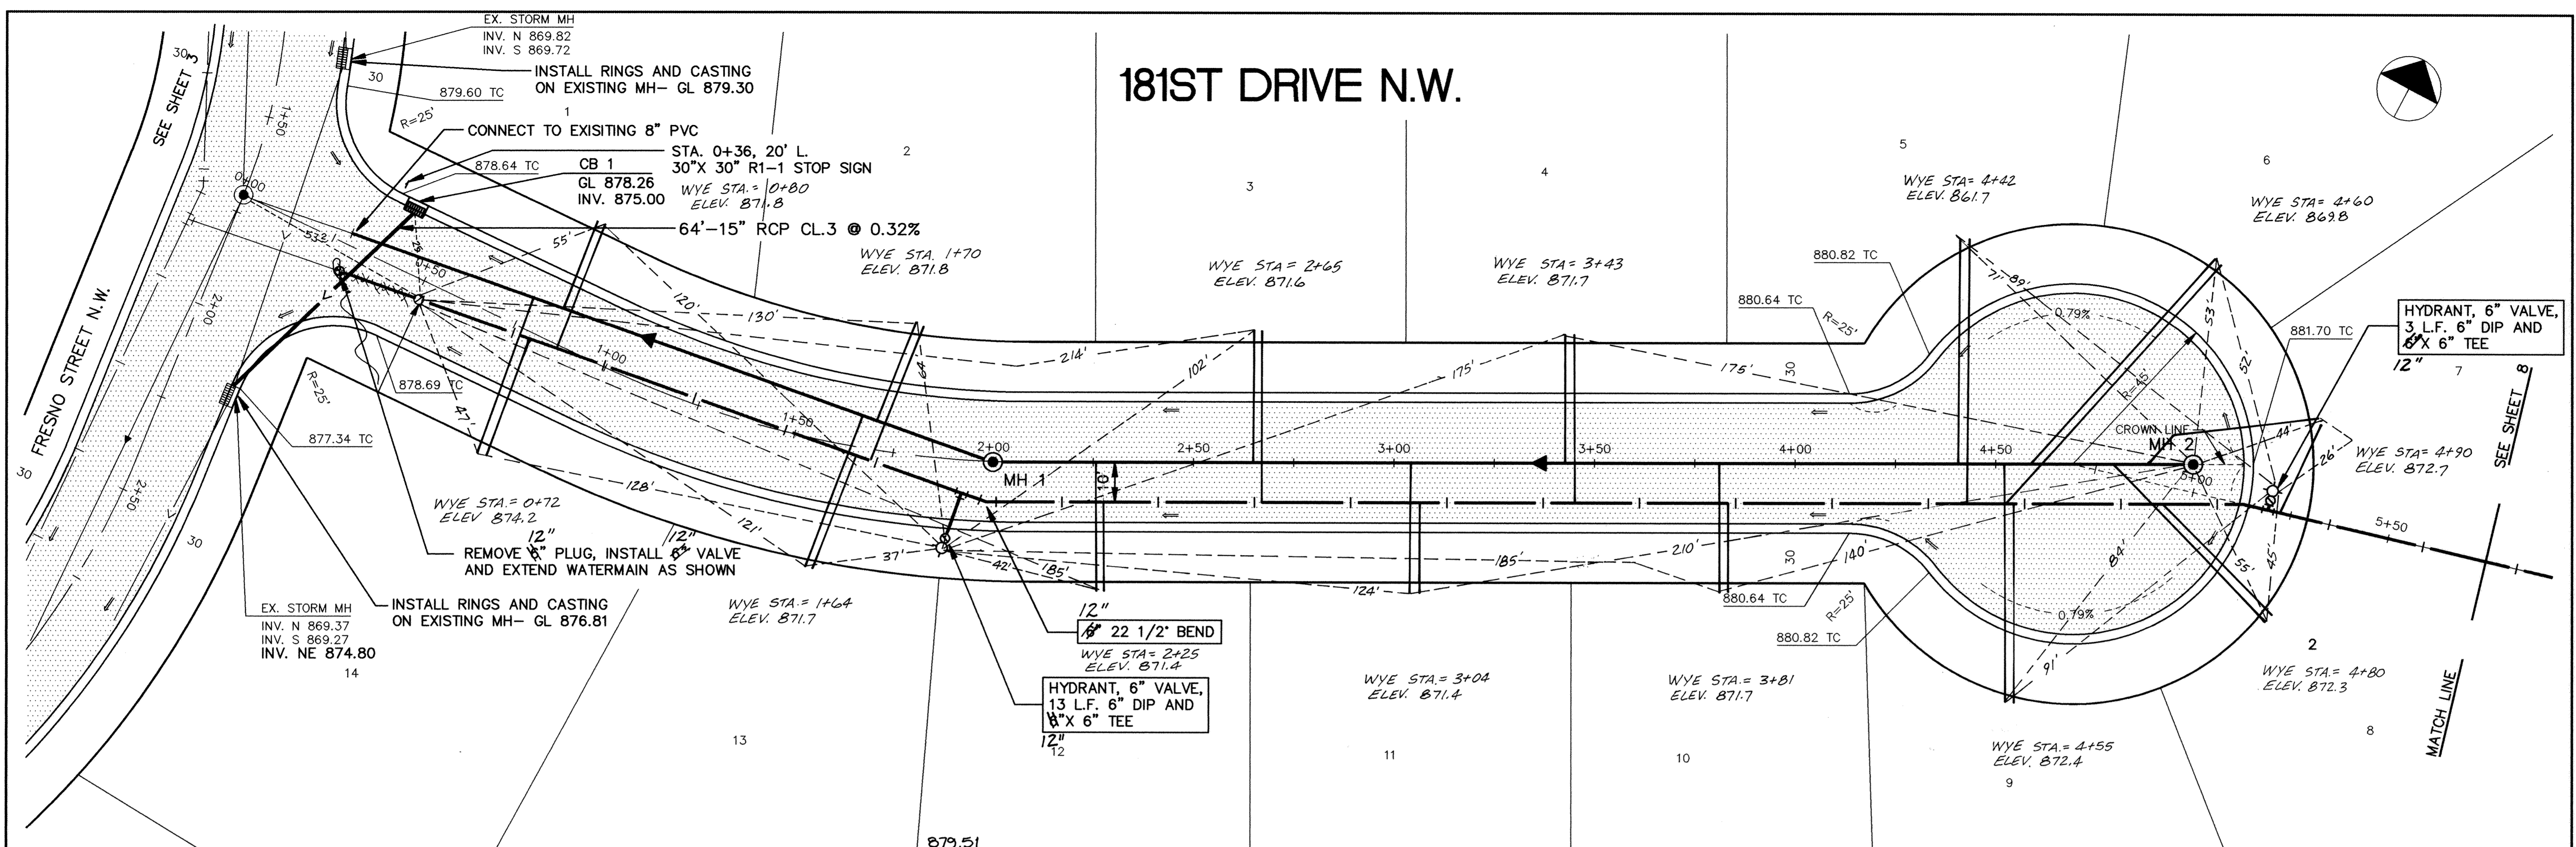

I HEREBY CERTIFY THAT THIS PLAN, SPECIFICATION, OR REPORT WAS PREPARED BY ME OR UNDER MY DIRECT SUPERVISION AND THAT I AM A DULY REGISTERED PROFESSIONAL ENGINEER UNDER THE LAWS OF THE STATE OF MINNESOTA.

Maier Stewart & Associates Inc.
DATE 4/19/93 REG. NO. 19130

Maier Stewart & Associates Inc.
CONSULTING ENGINEERS

1959 SLOAN PLACE (612) 774-6021 ST. PAUL, MINNESOTA 55117
9800 SHELARD PARKWAY (612) 546-0432 MINNEAPOLIS, MINNESOTA 55441

REVISIONS	DATE	DESCRIPTION

CITY OF ELK RIVER
SANITARY SEWER, WATERMAIN, STREET & STORM SEWER
181ST DRIVE N.W. STA. 0+00 TO 5+75

DESIGNED _____
CHECKED _____
DRAWN CLS

GRAPHIC SCALE
0 1 2
HORIZ. 20'
0 1 2
VERT. 5'

DATE MAY 1993 SHEET 7 OF 16 SHEETS PROJECT NO. 230-164