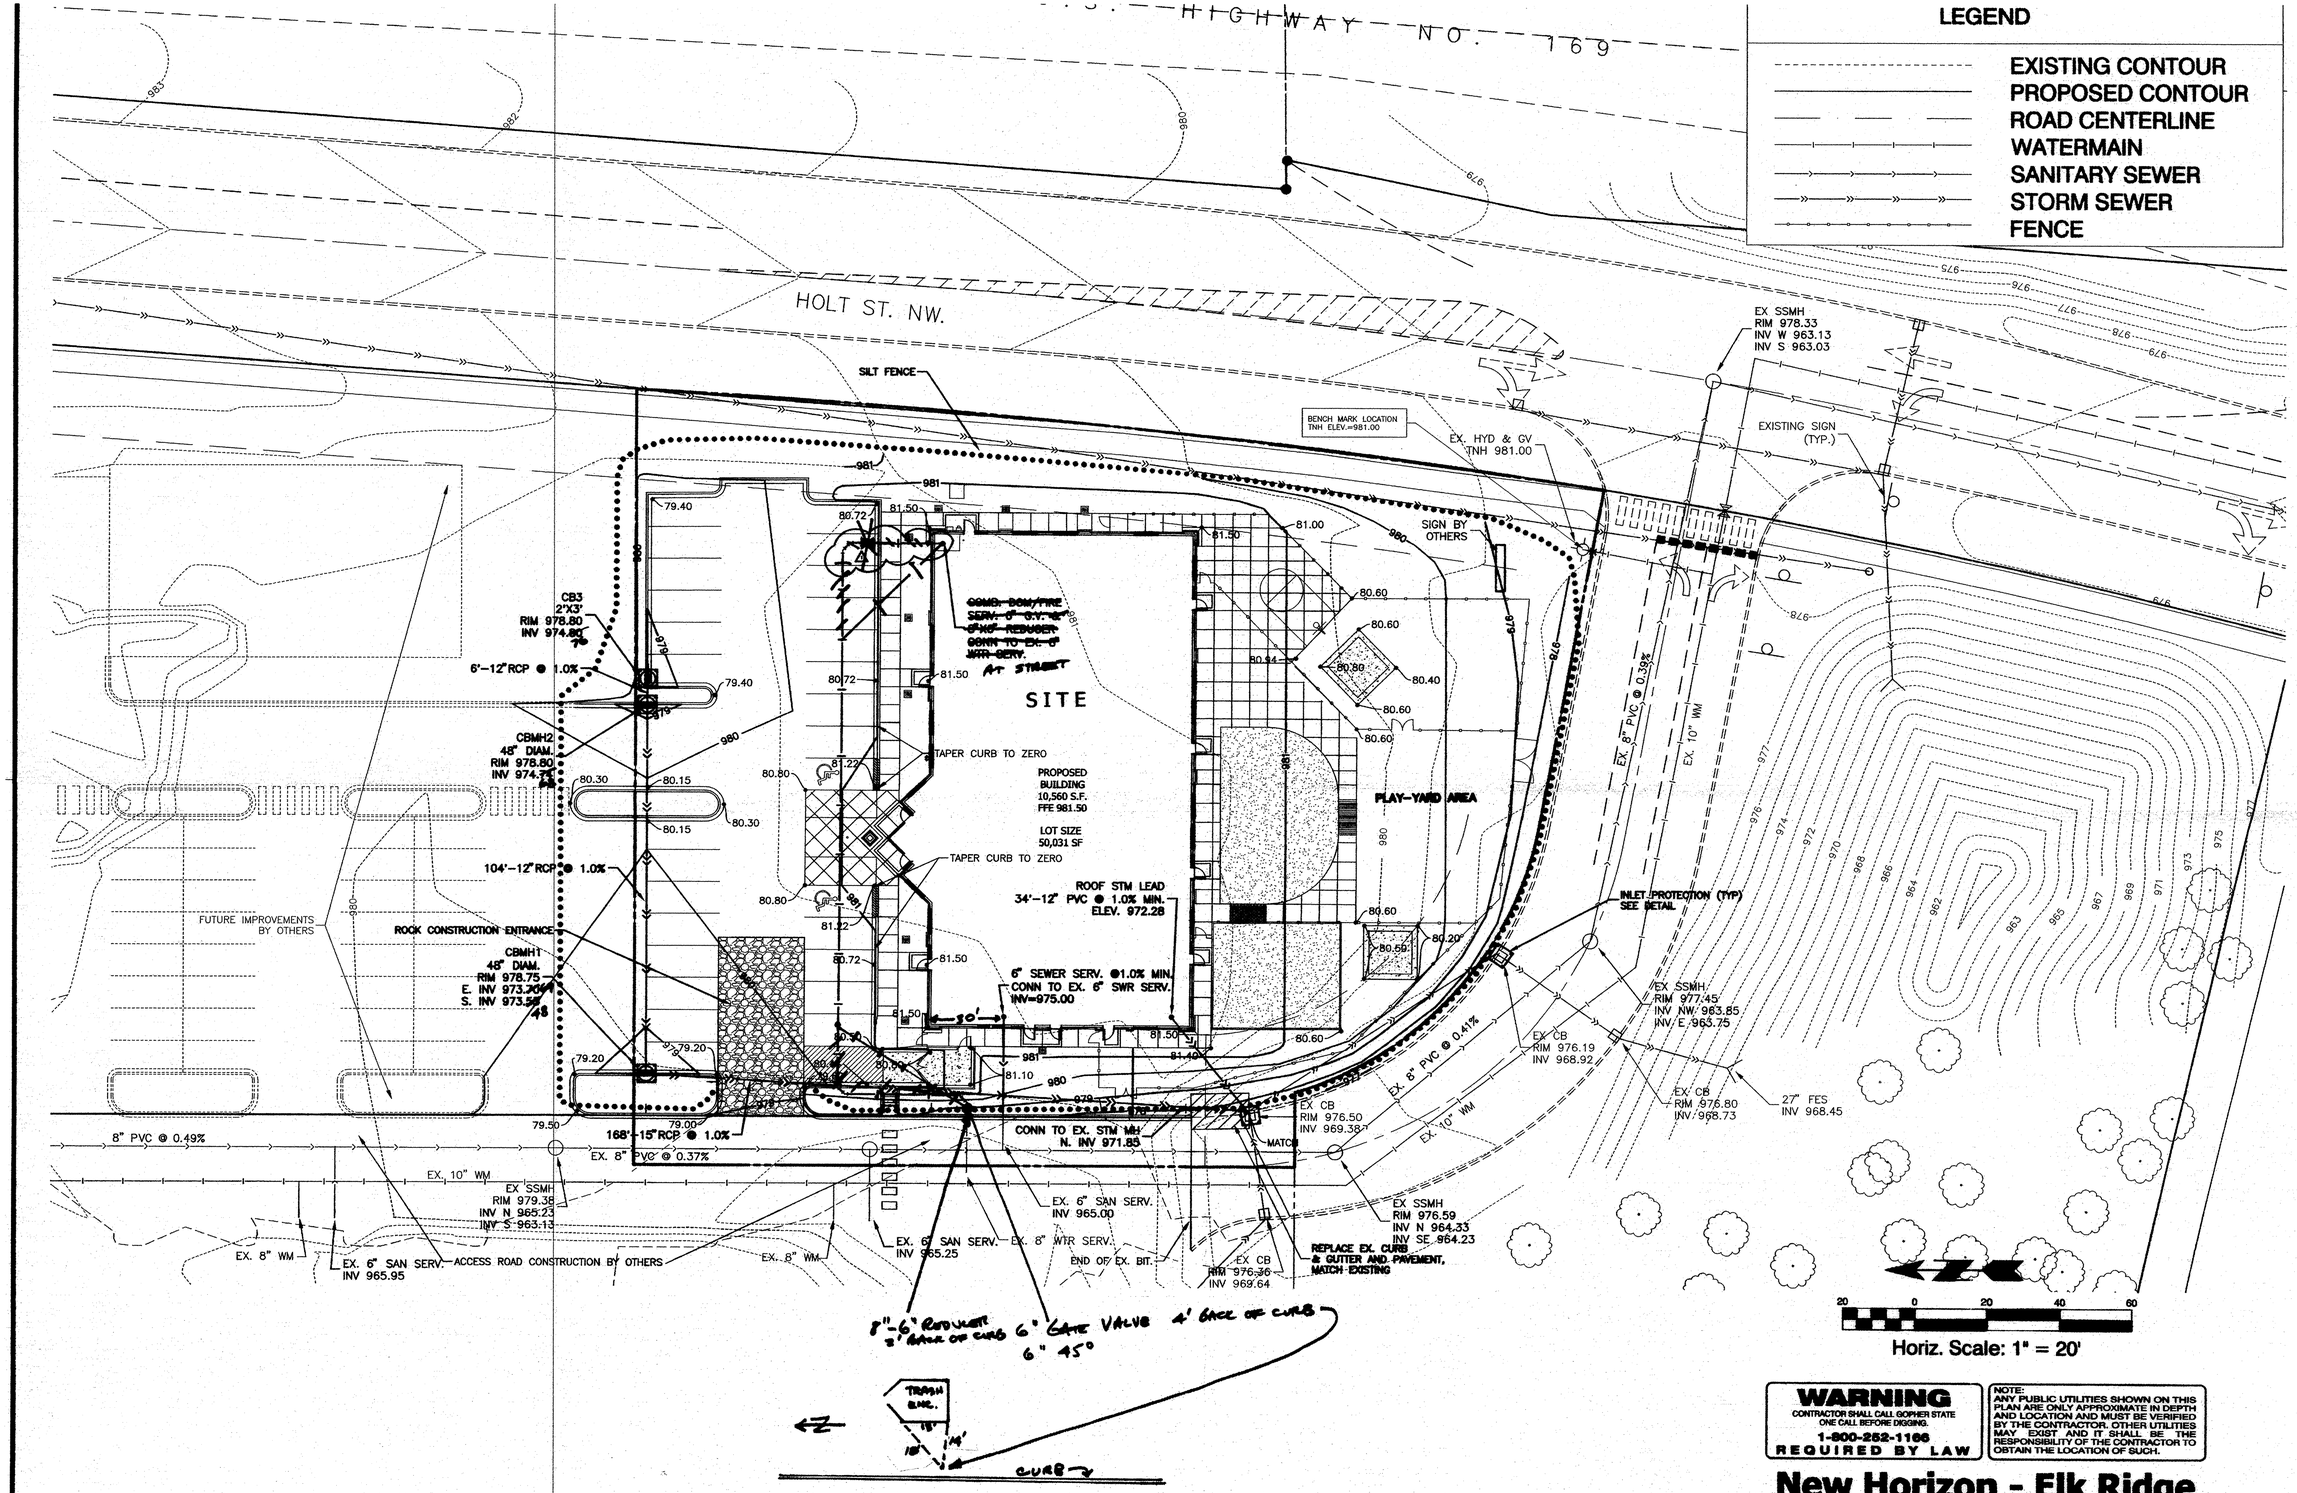

WARNING
CONTRACTOR SHALL CALL GOPHER STATE ONE CALL BEFORE DIGGING.
1-800-252-1166
REQUIRED BY LAW

NOTE:
ANY PUBLIC UTILITIES SHOWN ON THIS PLAN ARE ONLY APPROXIMATE IN DEPTH AND LOCATION AND MUST BE VERIFIED BY THE CONTRACTOR. OTHER UTILITIES MAY EXIST AND IT SHALL BE THE RESPONSIBILITY OF THE CONTRACTOR TO OBTAIN THE LOCATION OF SUCH.

New Horizon - Elk Ridge Grading & Utility Plan

Thatcher

AUTHORITY: Portfolio Design Services

PROJECT TITLE: New Horizon - Elk Ridge

I hereby certify that this plan, specification, or report was prepared by me or under my direct supervision and that I am a duly Licensed Professional Engineer under the laws of the state of Minnesota.
Print Name: Jana C. Hill
Signature: Jana C. Hill
Date: 2/14/06 License #: 44243

I hereby certify that this plan, specification, or report was prepared by me or under my direct supervision and that I am a duly Licensed Professional Engineer under the laws of the state of Minnesota.
Print Name: Jana C. Hill
Signature: Jana C. Hill
Date: 2/14/06 License #: 44243

REVISIONS

NO.	DATE	DRWN	CHKD	APPVD	COMMENTS
6					
5					
4					

DRAWN MPD
DATE 2/14/06
VERT. SCALE=
HORIZ. SCALE=

DRAWING NUMBER
SAFCO PRODUCTS • NEW HOPE, MINNESOTA
REORDER BY PART NUMBER 8552



DRAWING NUMBER
NEWHO.06-01
SAFCO PRODUCTS • NEW HOPE, MINNESOTA
REORDER BY PART NUMBER 8552