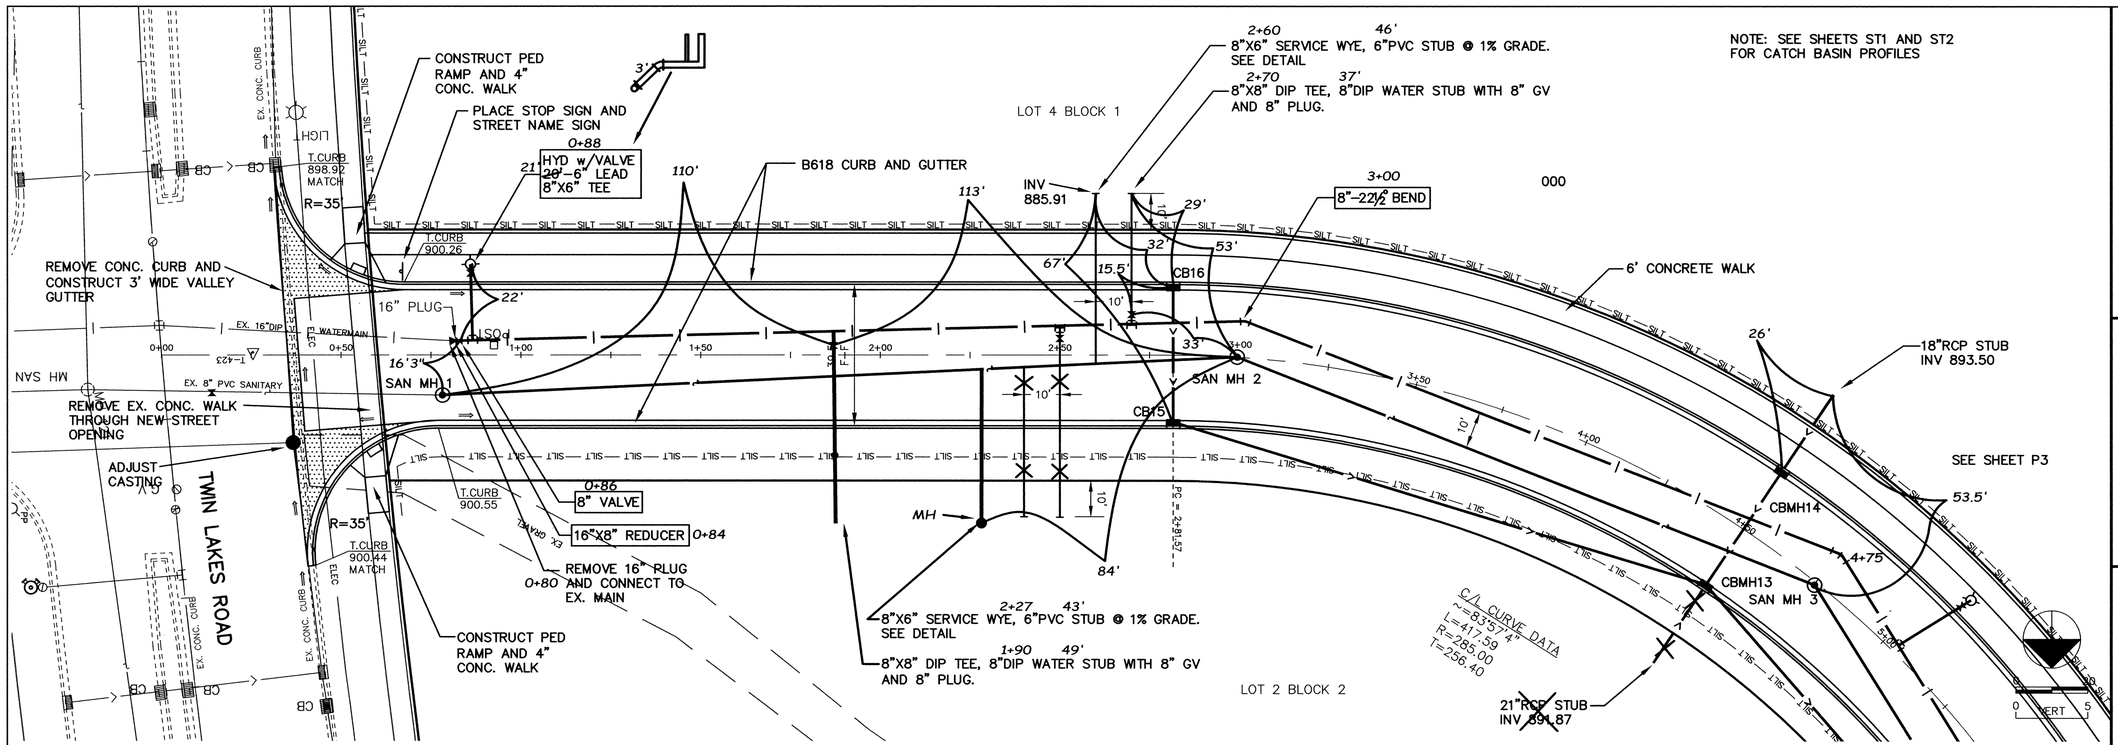

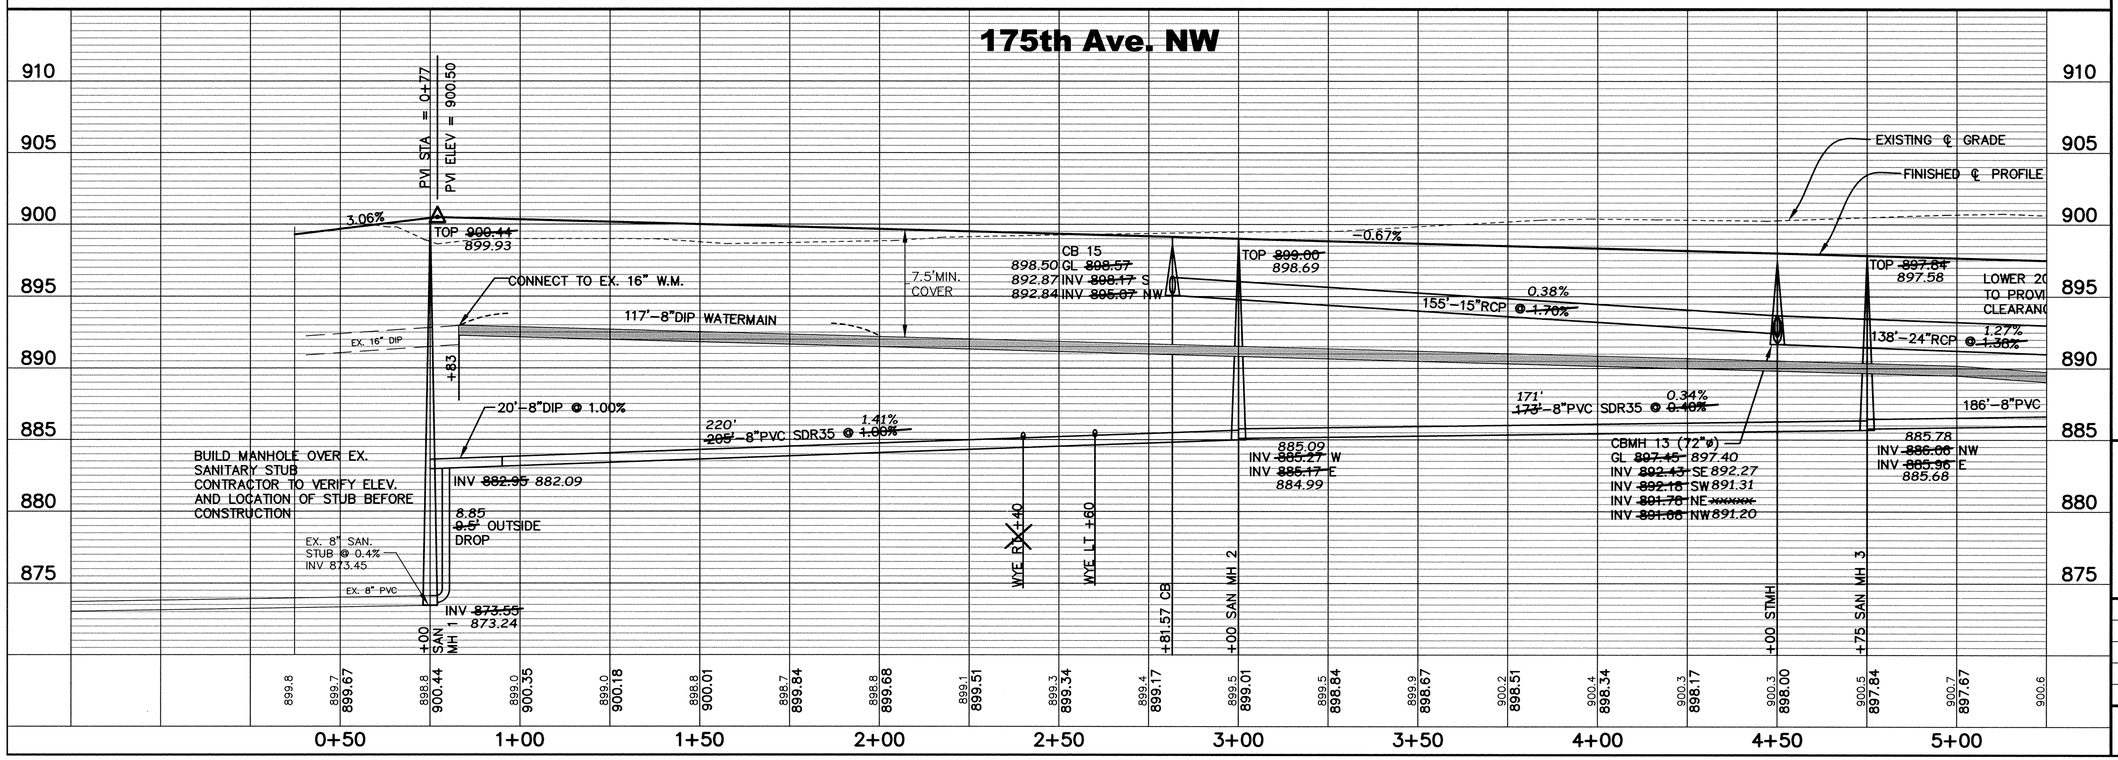

REVISIONS

NO.	DATE	BY	DESCRIPTION

I HEREBY CERTIFY THAT THIS PLAN, SPECIFICATION, OR REPORT WAS PREPARED BY ME OR UNDER MY DIRECT SUPERVISION AND THAT I AM A DULY LICENSED PROFESSIONAL ENGINEER UNDER THE LAWS OF THE STATE OF MINNESOTA.

JOHN M. ANDERSON
AUG. 12, 2005
DATE 2/3/07
25889
LIC. NO.

CITY OF ELK RIVER
NORTHSTAR BUSINESS PARK
PLAN AND PROFILE
STREET A

BDM
CONSULTING ENGINEERS, PLC
Engineers and Surveyors
4175 Lovell Road, Suite 112
Lexington, MN 55014
Phone: (763) 786-4570
Fax: (763) 786-4574
bdmce.com

DRAWN BY:	JL
CHECKED BY:	JMA
DESIGNED BY:	JL
JOB NO.	226035

SHEET	SHEETS
P2	25

SAFCO PRODUCTS • NEW HOPE, MINNESOTA
RECORDED BY PART NUMBER 83502
PRINTED ON BOTH SIDES OF SHEET IN THIS ZONE
NORBP.05
10