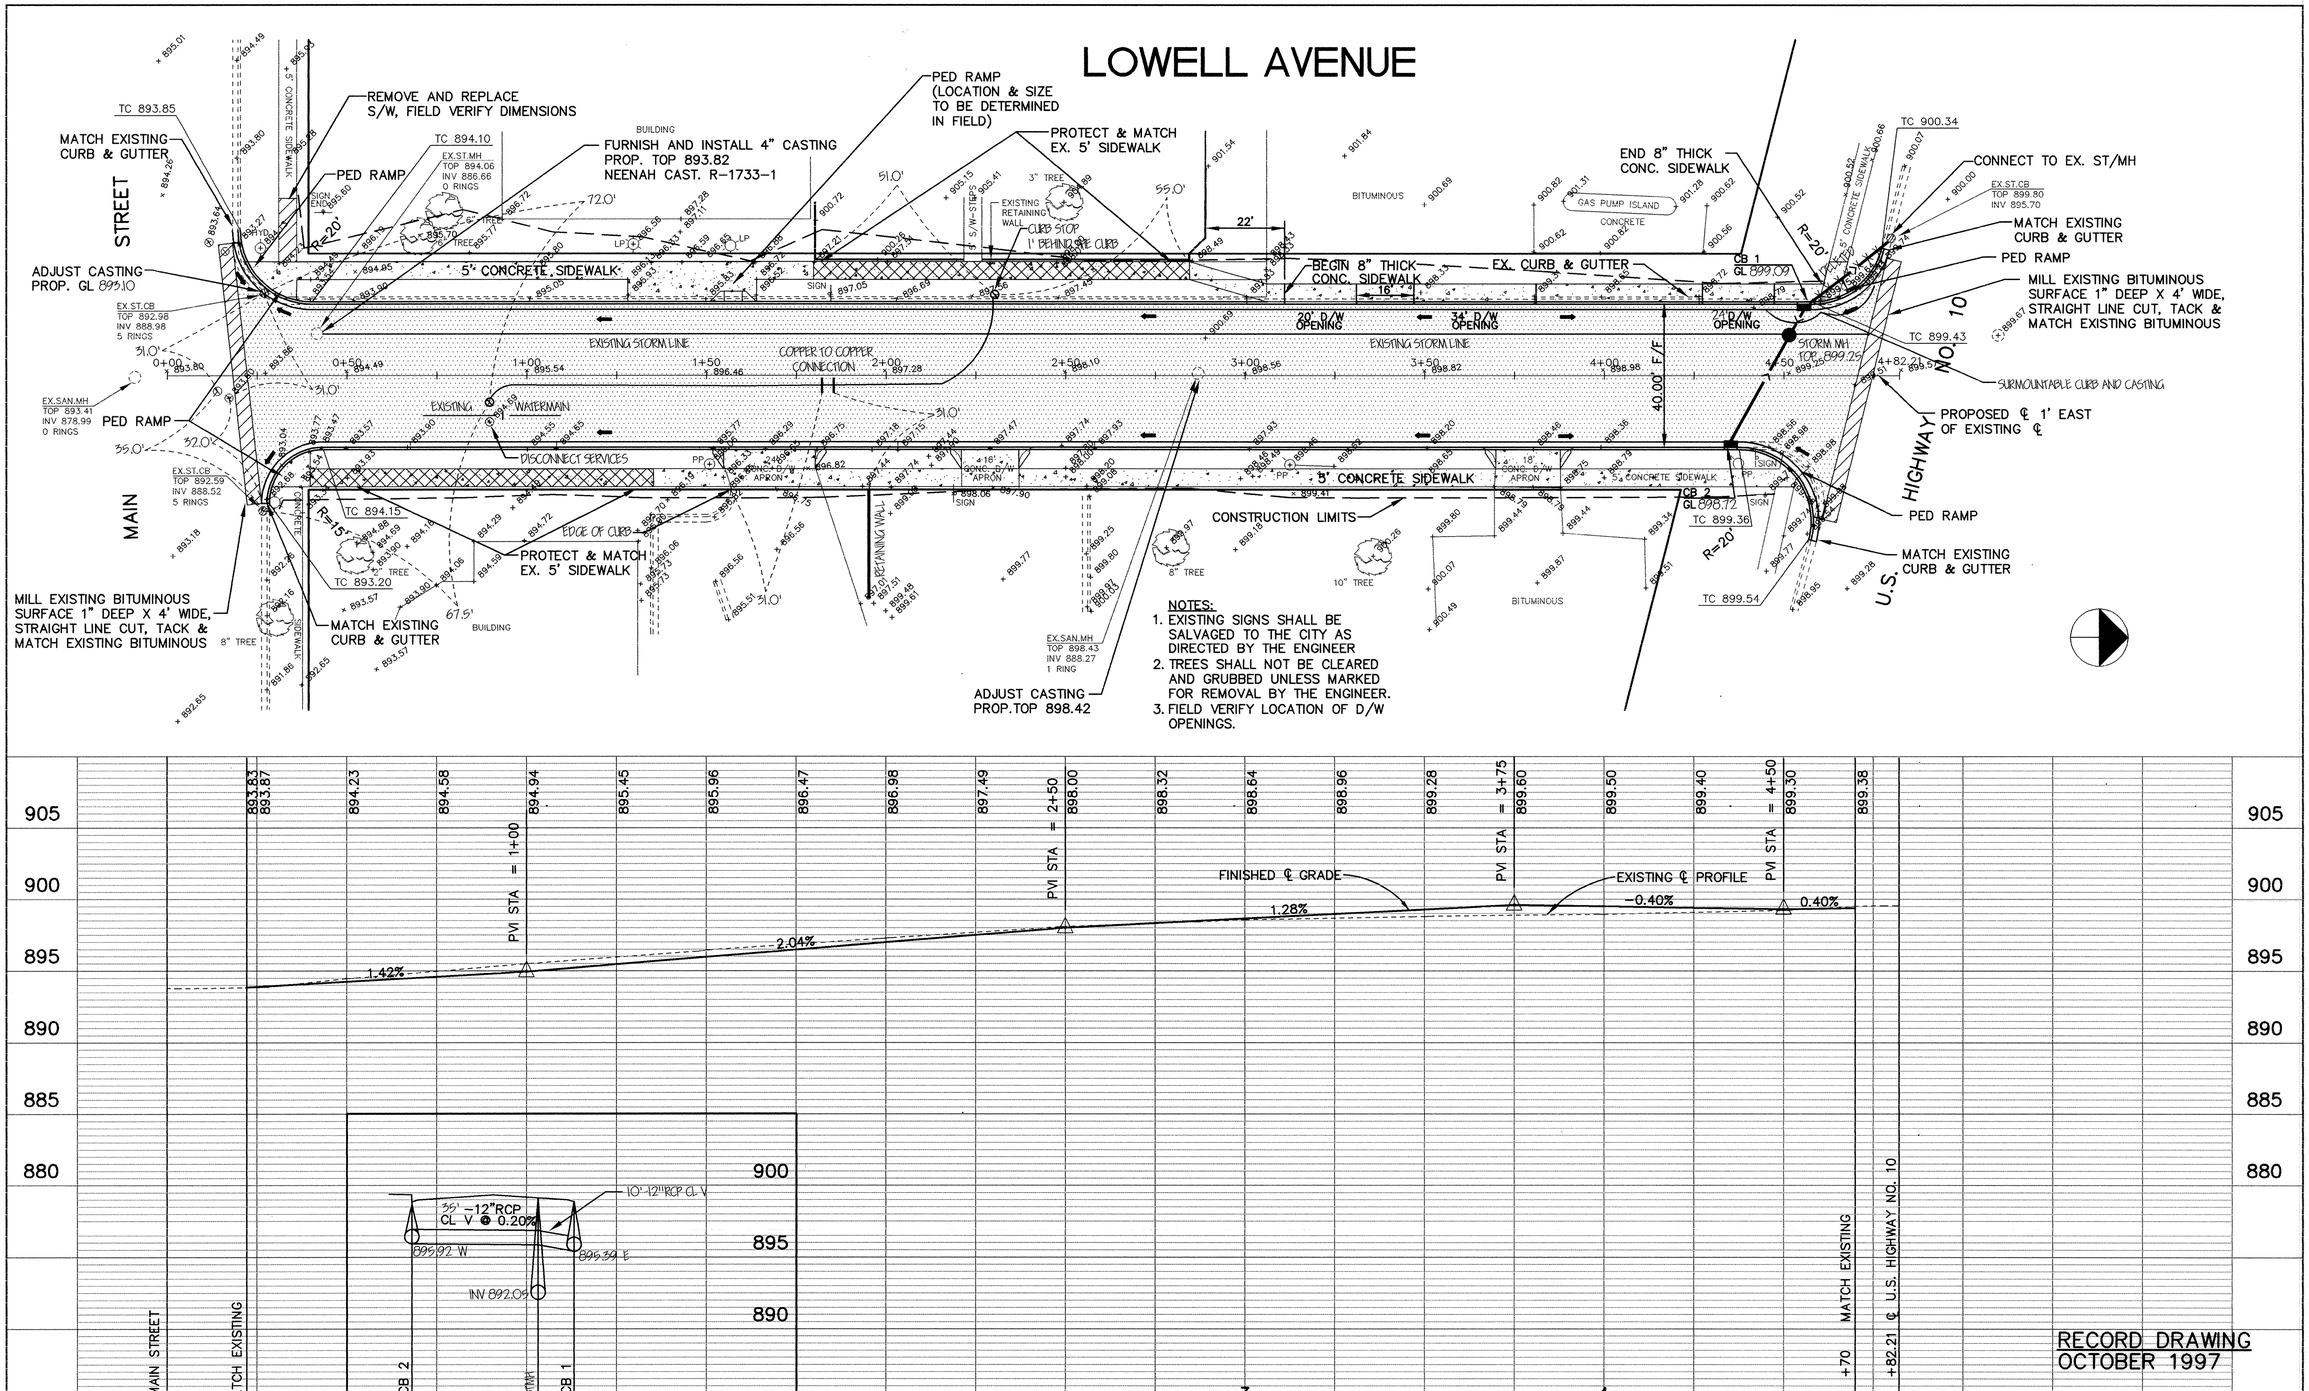

I HEREBY CERTIFY THAT THIS PLAN, SPECIFICATION, OR REPORT WAS PREPARED BY ME OR UNDER MY DIRECT SUPERVISION AND THAT I AM A DULY REGISTERED PROFESSIONAL ENGINEER UNDER THE LAWS OF THE STATE OF MINNESOTA.

DATE 12/8/96 REG.NO. 15316

MSA CONSULTING ENGINEERS

1326 ENERGY PARK DRIVE
ST. PAUL, MINNESOTA 55108
(612) 644-4389

REVISIONS

DATE	DESCRIPTION

DESIGNED SEF
CHECKED
DRAWN RKM
GRAPHIC SCALE 0 20 / 0 VERT. 5

CITY OF ELK RIVER
STREET IMPROVEMENTS
LOWELL AVENUE

0+00 TO 4+75

DATE NOV. 1996 | SHEET 25 OF 31 SHEETS | PROJECT NO. 230-331

ER330-1

1081

DRAWING NUMBER

DRAWING NUMBER

DRAWING NUMBER
ORONO3.96
25